

ROADWAY CROSS SECTIONS

PROJECT NAME: WILLIAMSTOWN

PROJECT NUMBER: BRS 0204(4)

FILE NAME: 83ell\Sr+uc+\sellxs.dgn

PLOT DATE: 07-APR-2008

PROJECT LEADER: EVANS-MONGEON


DRAWN BY: G.ROKES

DESIGNED BY: U. STANLEY

CHECKED BY: EVANS-MONGEON

IPARM: sellxs5.1

SHEET 76 OF 108

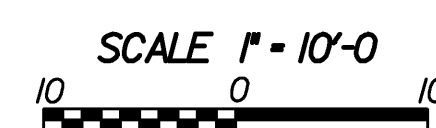

STA. 217+63 TO STA. 218+20