


218+25  
END APPROACH  
BEGIN PROJECT

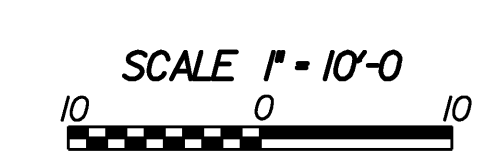

STA. 218+40 TO STA. 218+73

ROADWAY CROSS SECTIONS	
PROJECT NAME:	WILLIAMSTOWN
PROJECT NUMBER:	BRS 0204(4)
FILE NAME:	83ell\Sr+uc+sellxs.dgn
PROJECT LEADER:	EVANS-MONGEON
DESIGNED BY:	U. STANLEY
IPARM:	sellxs6.1
PLOT DATE:	07-APR-2008
DRAWN BY:	G.ROKES
CHECKED BY:	EVANS-MONGEON
SHEET	77 OF 108