


ROADWAY CROSS SECTIONS

PROJECT NAME:	WILLIAMSTOWN
PROJECT NUMBER:	BRS 0204(4)
FILE NAME:	83ell\Sr\truct\sellxs.dgn
PROJECT LEADER:	EVANS-MONGEON
DESIGNED BY:	U. STANLEY
IPARM:	sellxs9.I
PLOT DATE:	07-APR-2008
DRAWN BY:	G.ROKES
CHECKED BY:	EVANS-MONGEON
SHEET	80 OF 108

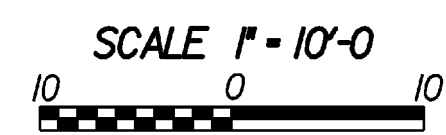

STA. 219+85 TO STA. 220+40