


ROADWAY CROSS SECTIONS

| | | | |
|-----------------|--------------------------|--------------|---------------|
| PROJECT NAME: | WILLIAMSTOWN | PLOT DATE: | 07-APR-2008 |
| PROJECT NUMBER: | BRS 0204(4) | DRAWN BY: | G.ROKES |
| FILE NAME: | 83ell\Struct\selllxs.dgn | DESIGNED BY: | U. STANLEY |
| PROJECT LEADER: | EVANS-MONGEON | CHECKED BY: | EVANS-MONGEON |
| IPARM: | selllxs14.1 | SHEET | 85 OF 108 |

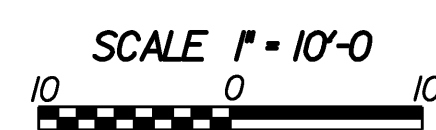

STA. 222+80 TO STA. 223+20