


ROADWAY CROSS SECTIONS

PROJECT NAME:	WILLIAMSTOWN	FILE NAME:	83elll\Sr+uc+\selllxs.dgn	PLOT DATE:	07-APR-2008
PROJECT NUMBER:	BRS 0204(4)	PROJECT LEADER:	EVANS-MONGEON	DRAWN BY:	G.ROKES
		DESIGNED BY:	U. STANLEY	CHECKED BY:	EVANS-MONGEON
		IPARM:	selllxs15.1	SHEET	86 OF 108

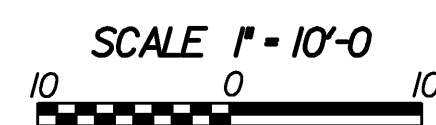

STA. 223+20 TO STA. 223+85