



STA. 52+55.48
 END COFFERDAM EXCAVATION EARTH
 END COFFERDAM EXCAVATION ROCK
 END GRANULAR BACKFILL FOR STRUCTURES


52+60

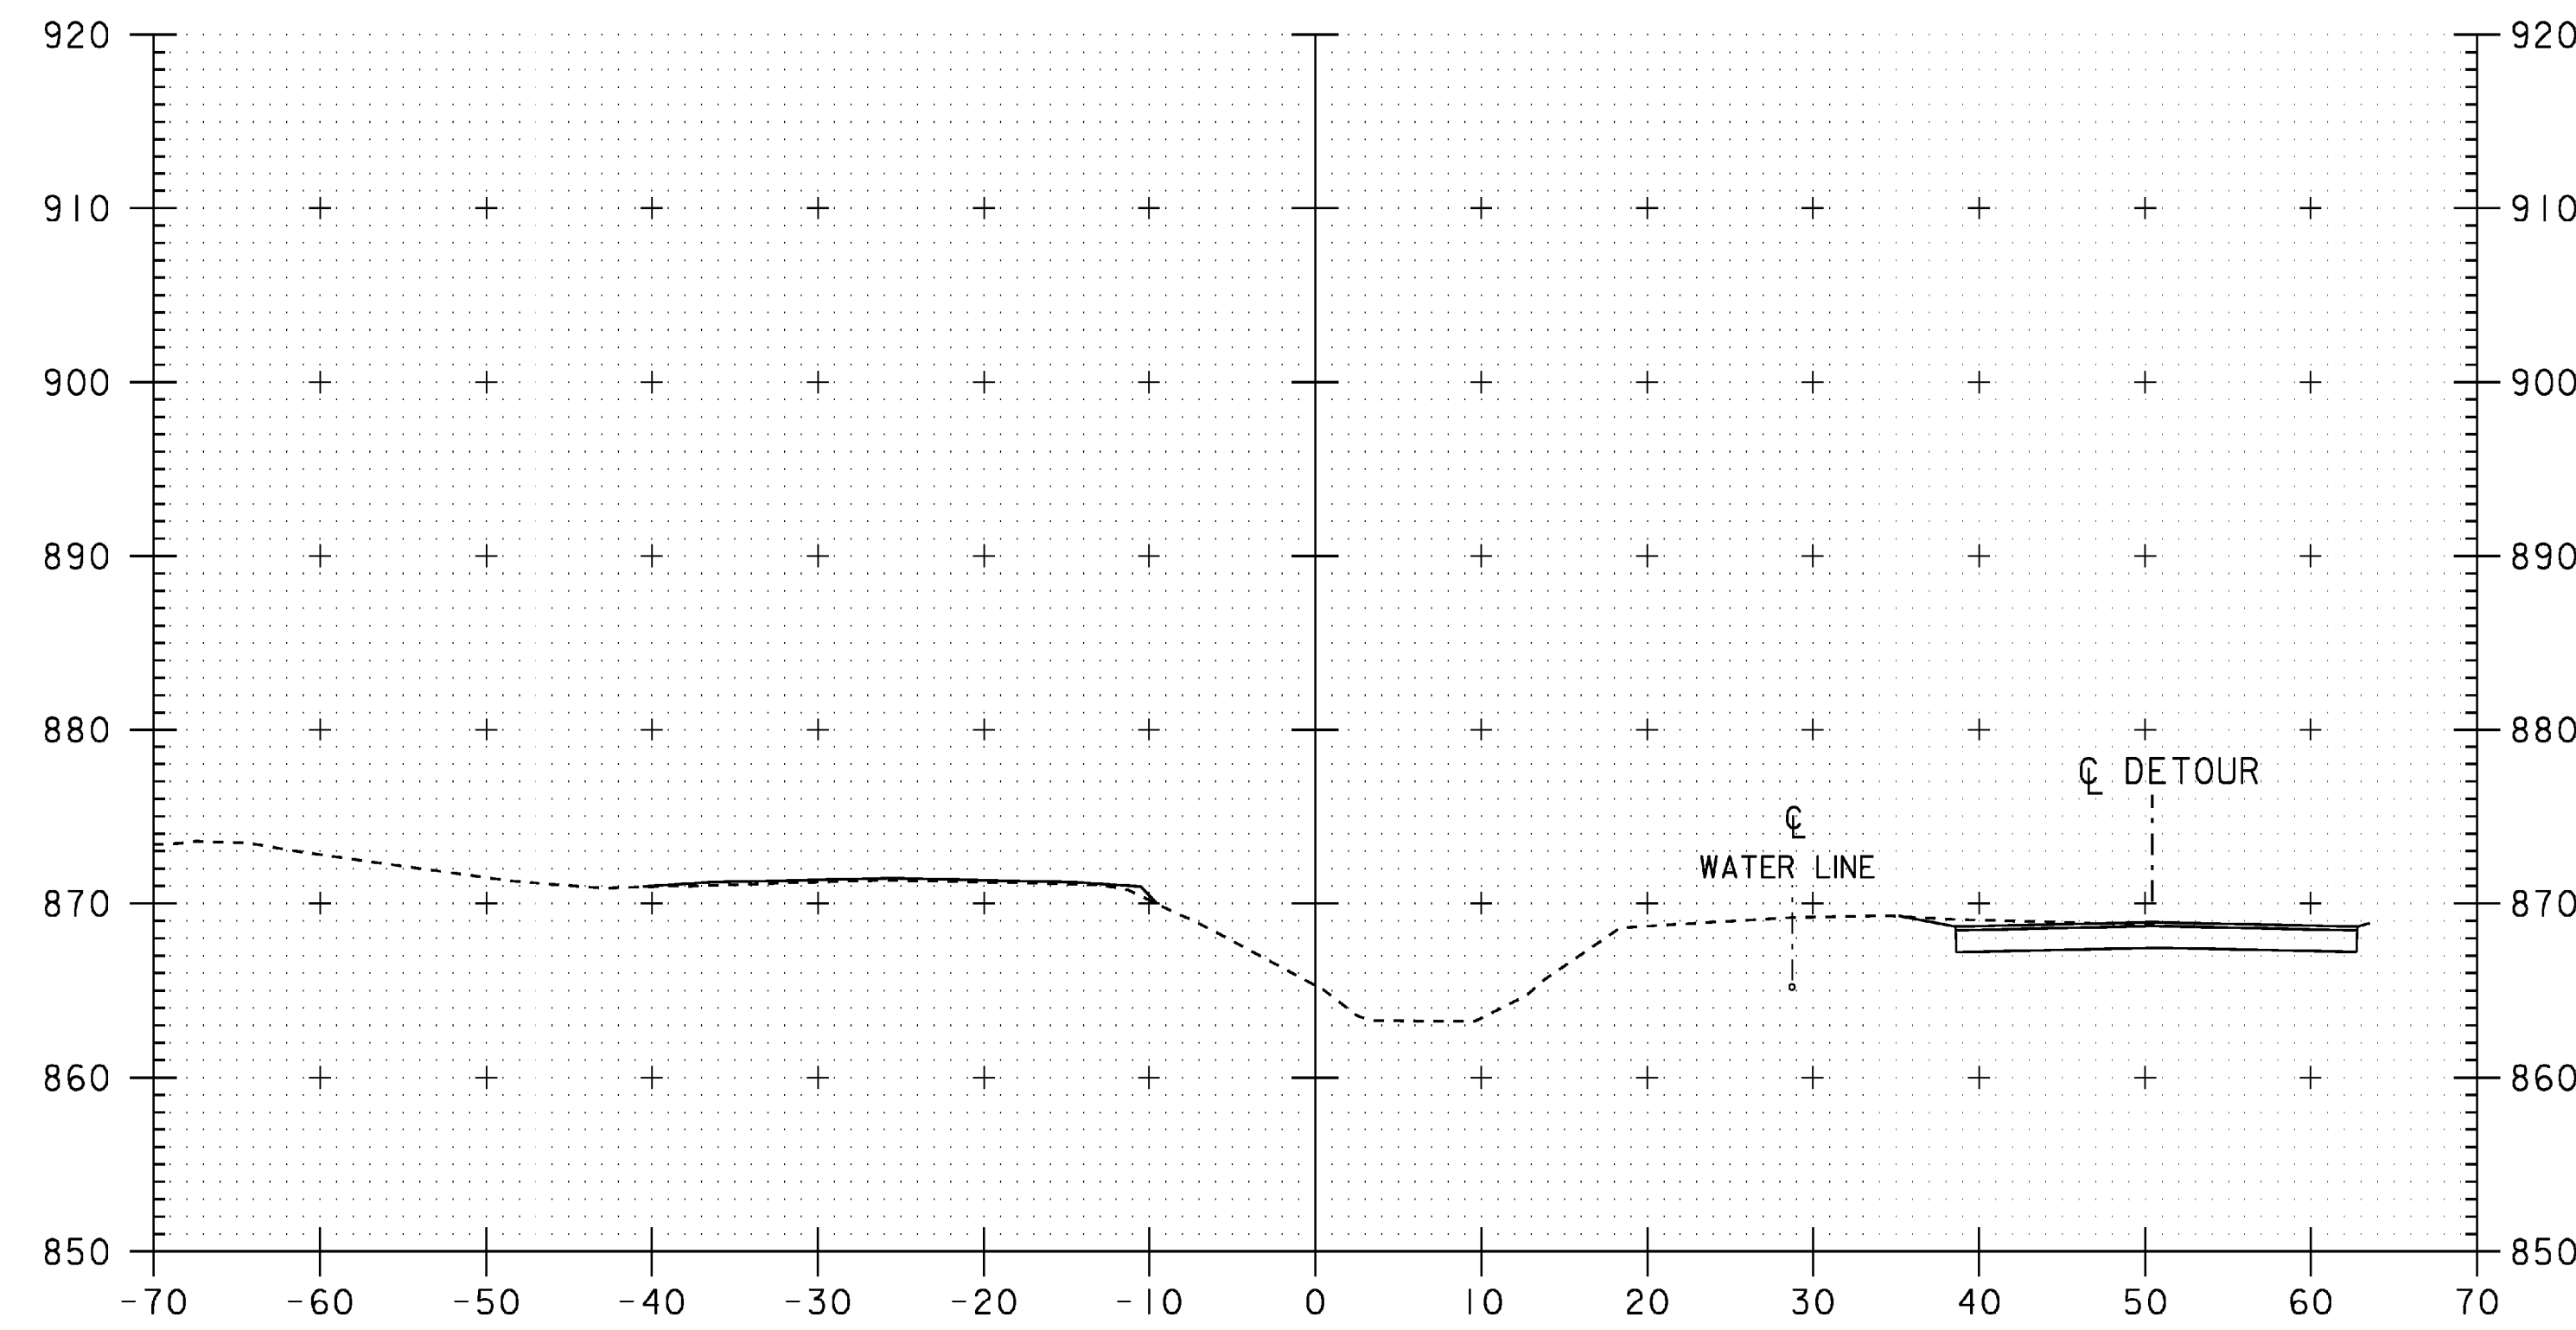

53+00

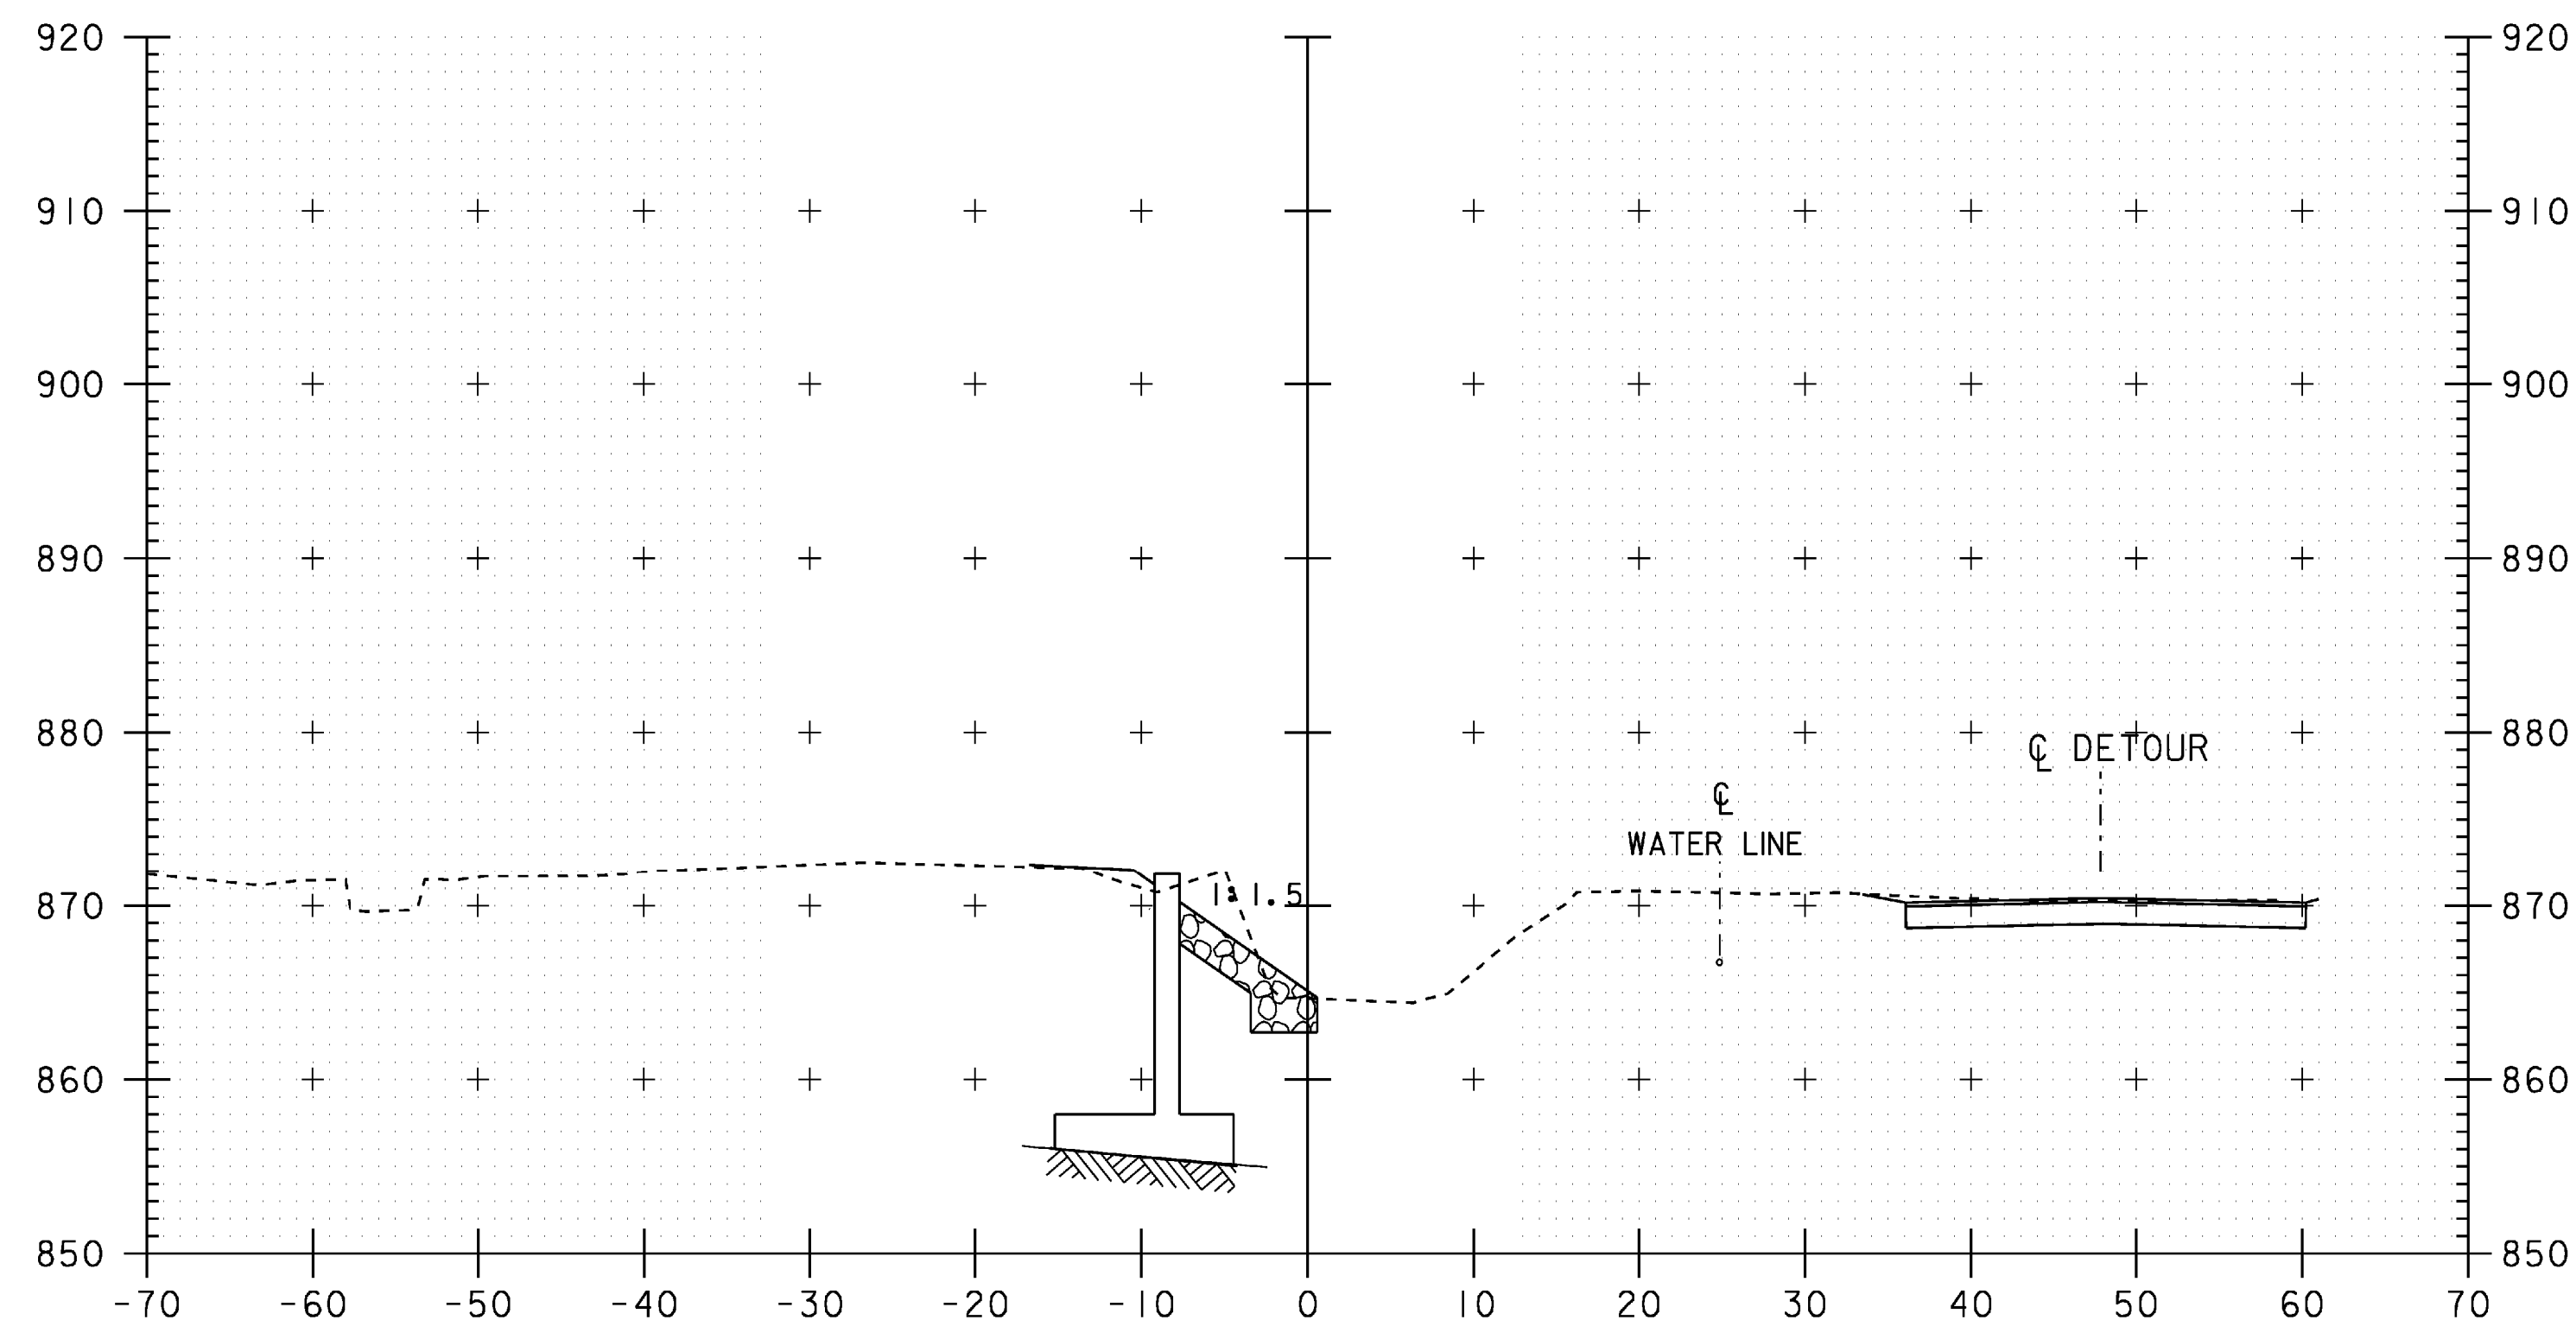


52+54

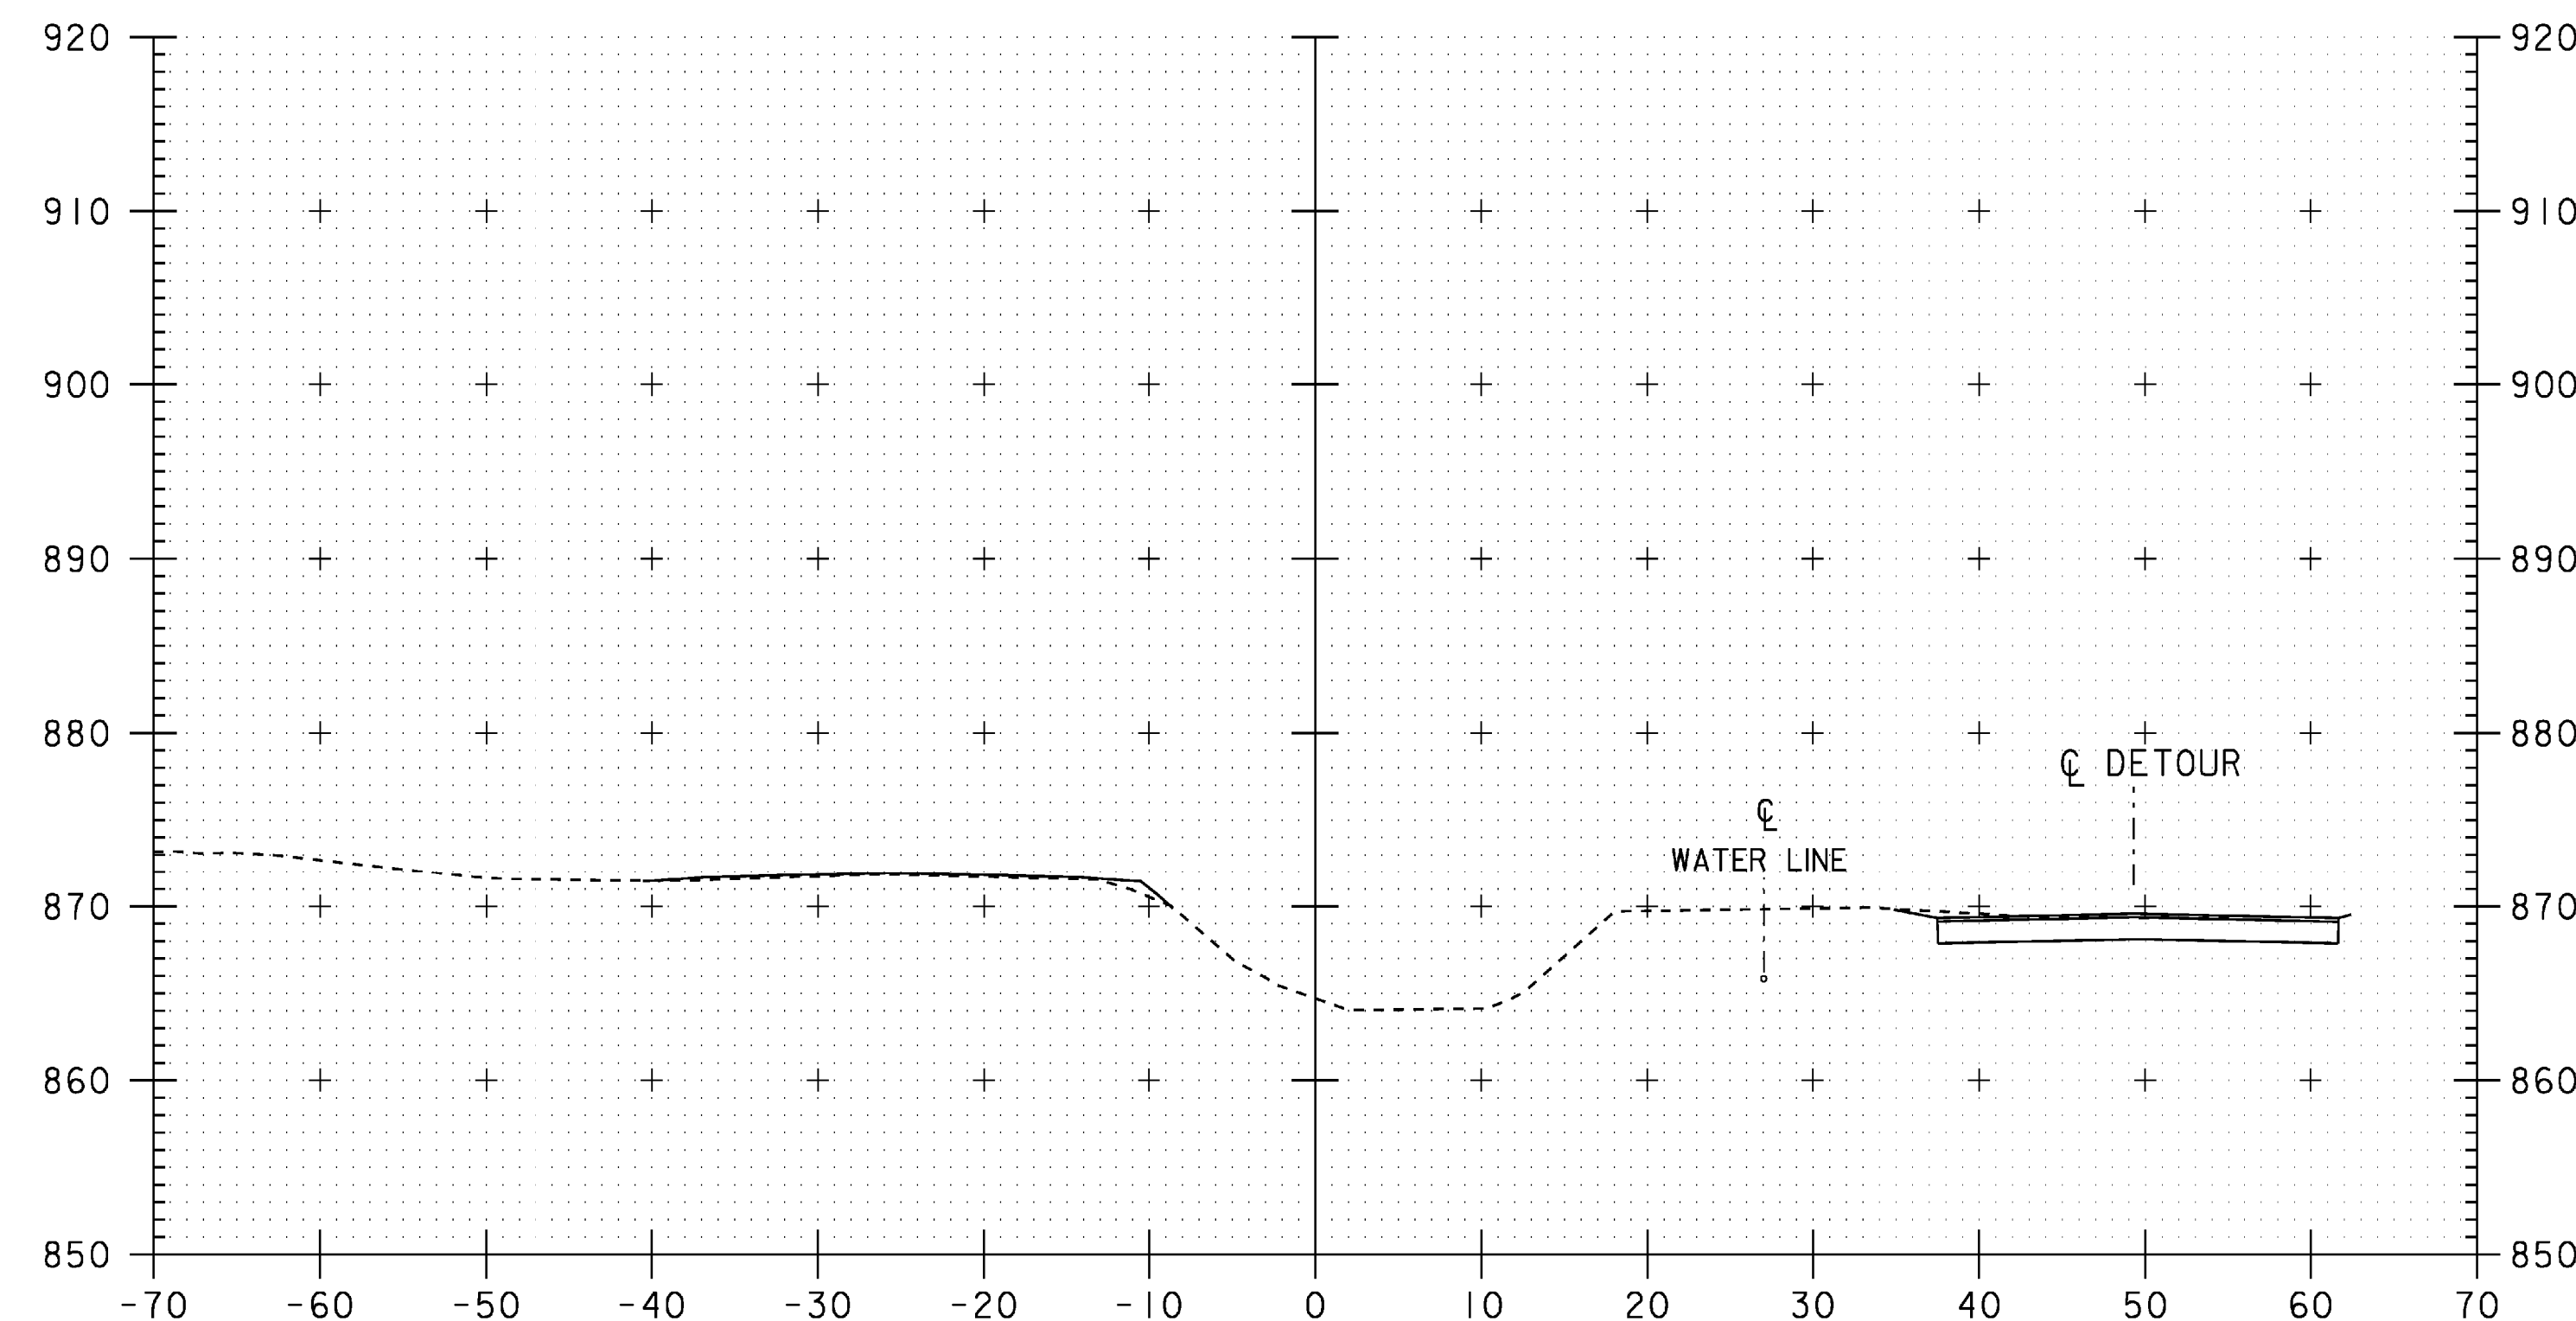

52+80

STA. 52+70
 END UNCLASSIFIED CHANNEL EXCAVATION
 END STONE FILL TYPE II
 END GRUBBING MATERIAL
 END GEOTEXTILE UNDER STONE FILL

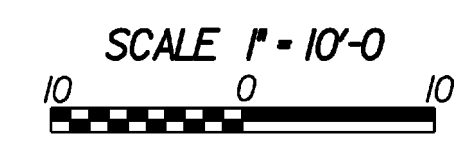

CHANNEL CROSS SECTIONS

PROJECT NAME: WILLIAMSTOWN
 PROJECT NUMBER: BRS 0204(4)

FILE NAME: 83ell\structures\ellxs.d	PLOT DATE: 07-APR-2008
PROJECT LEADER: EVANS-MONGEON	DRAWN BY: G.ROKES
DESIGNED BY: U. STANLEY	CHECKED BY: EVANS-MONGEON
IPARM: sellch9.I	SHEET 95 OF 108

STA. 52+54 TO STA. 53+00