




300+80

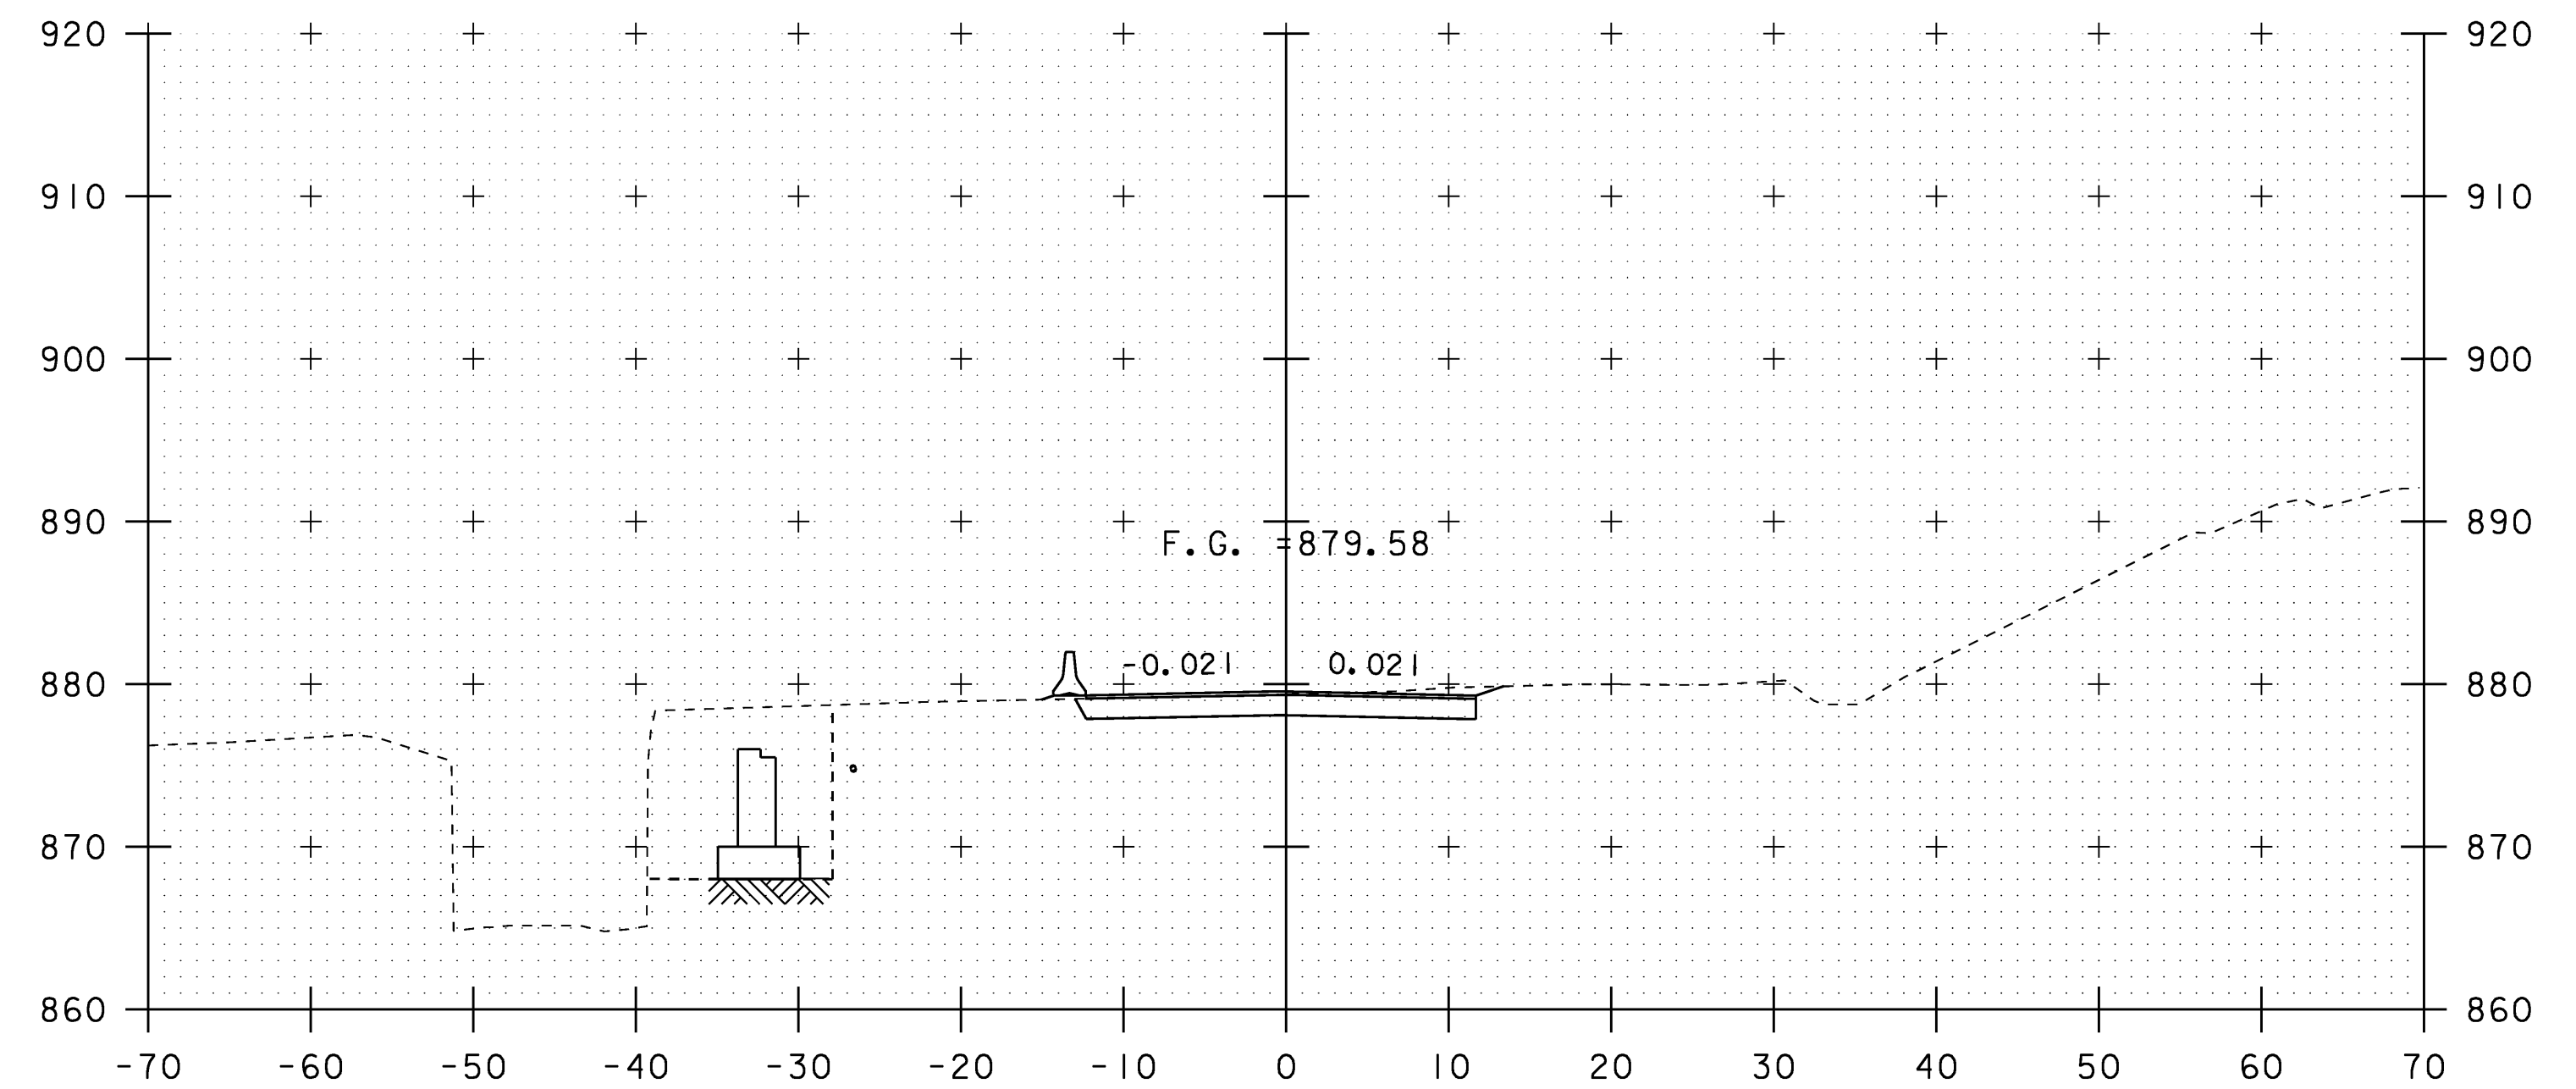


301+02

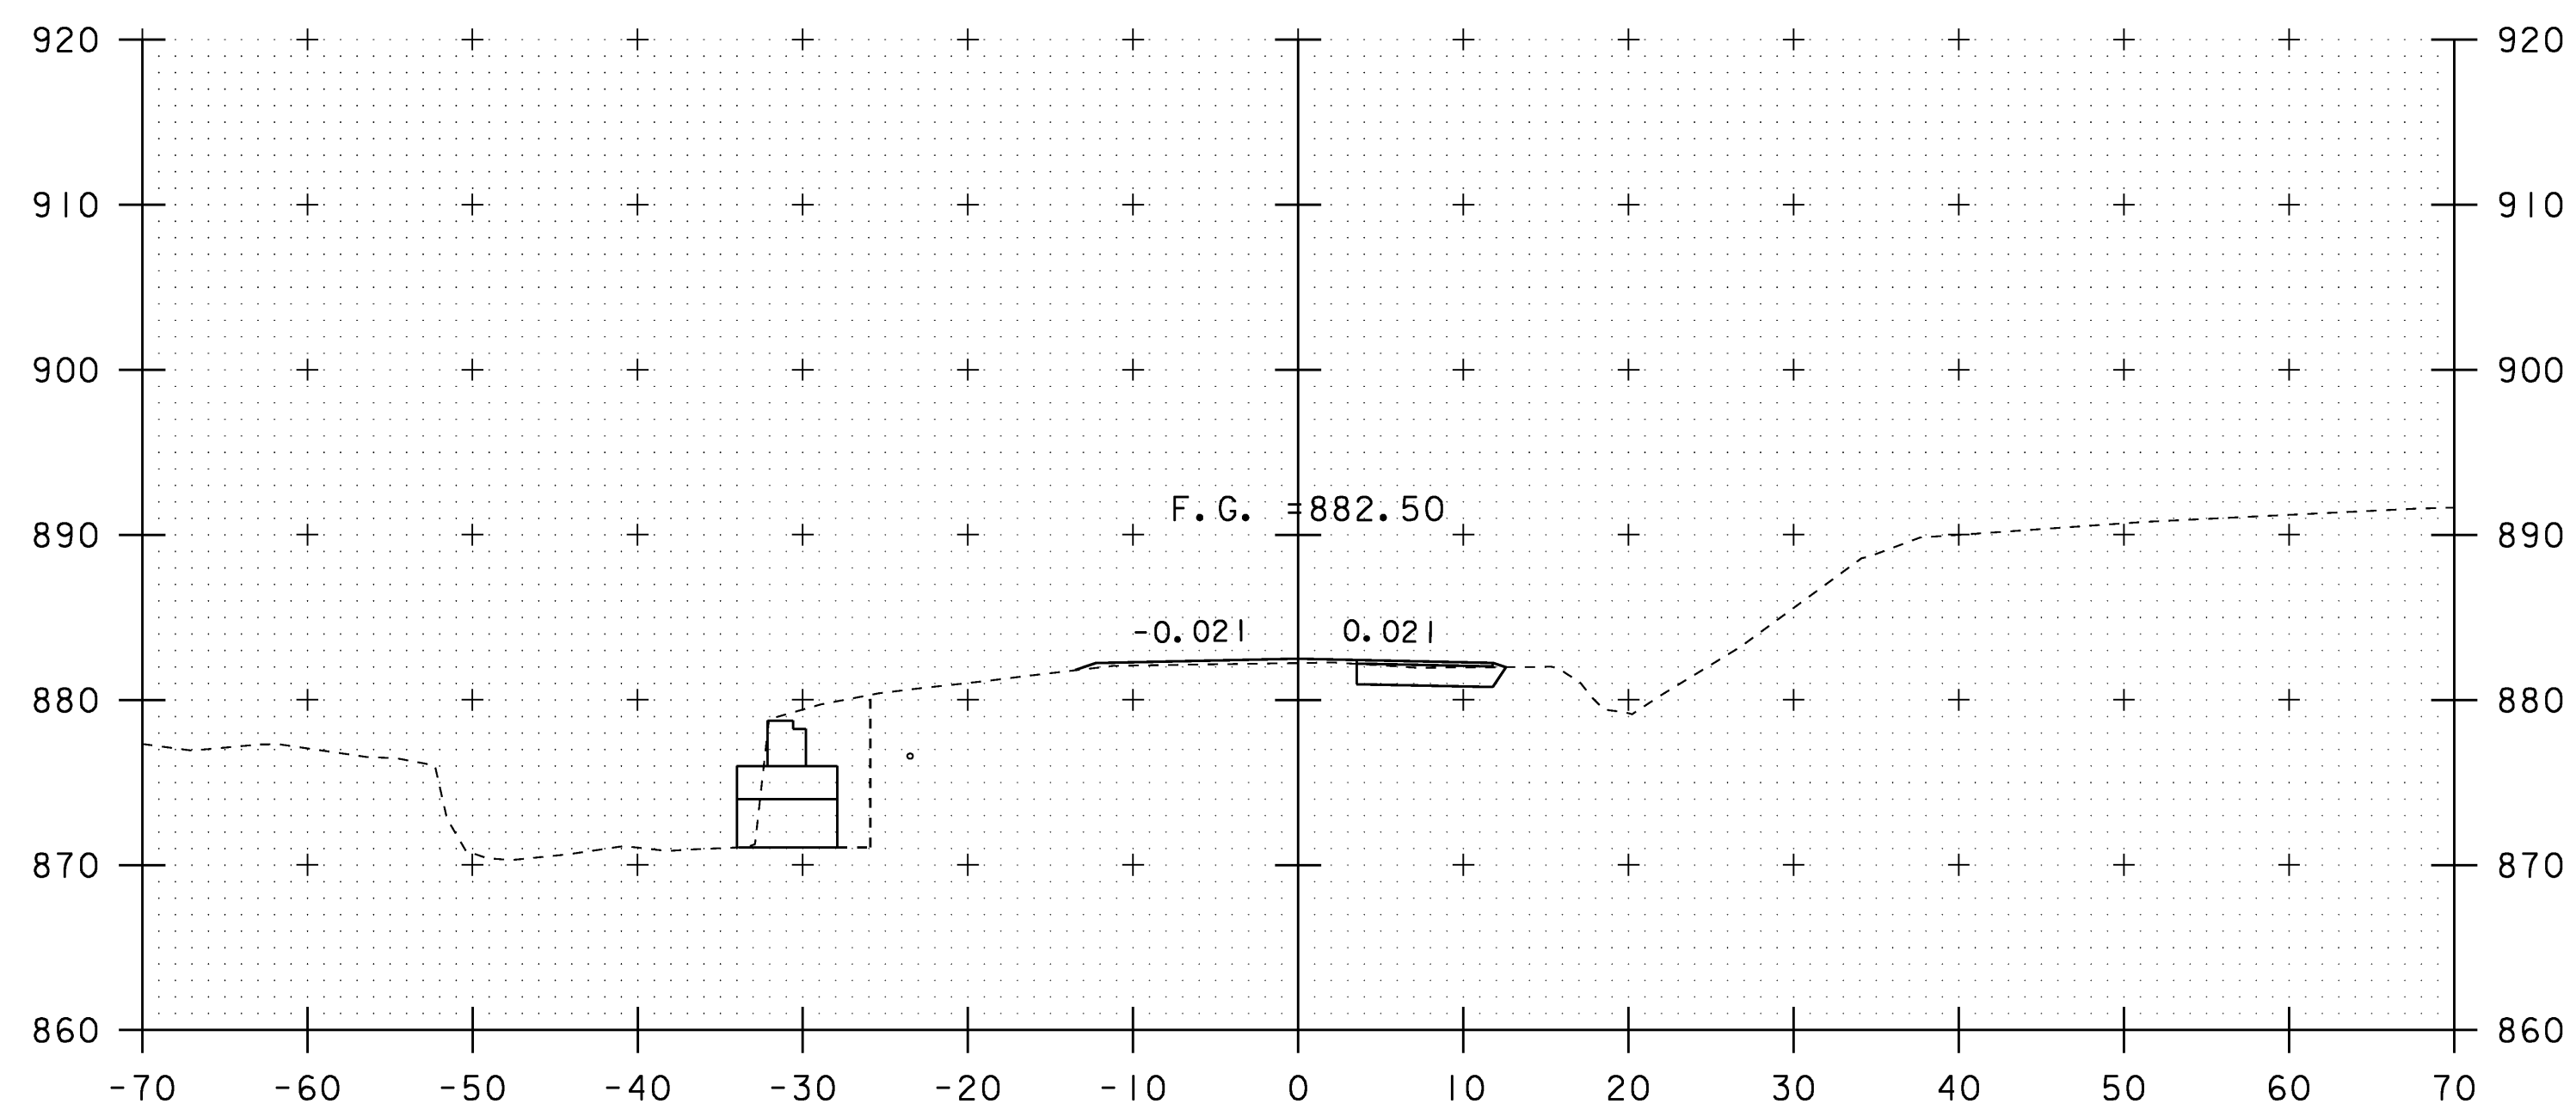

300+60

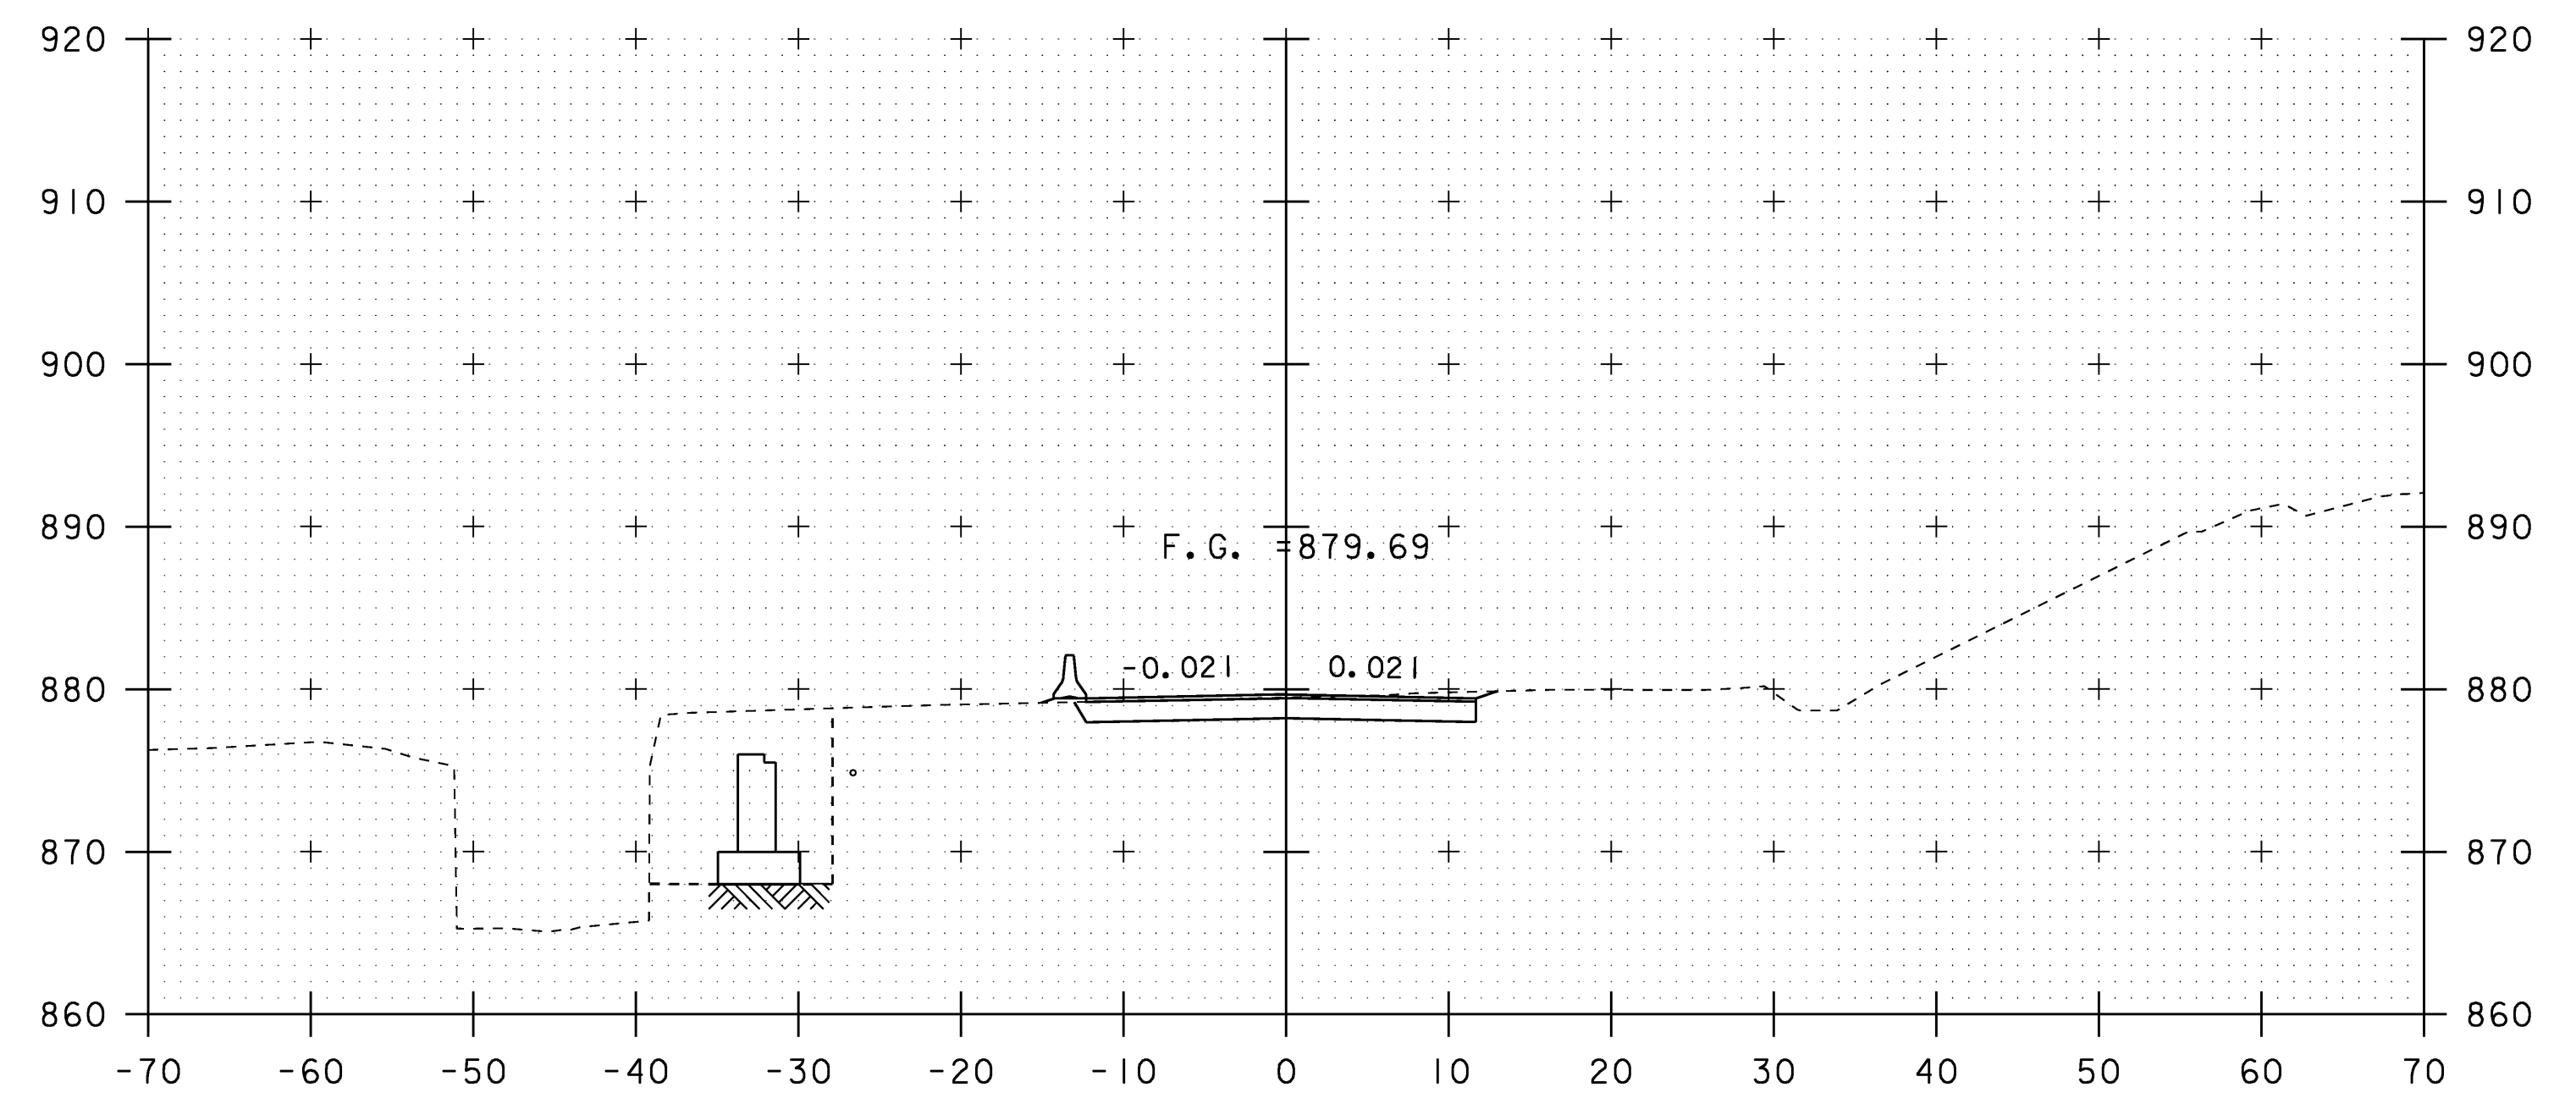

301+00

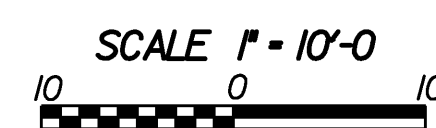

DETOUR CROSS SECTIONS

PROJECT NAME: WILLIAMSTOWN

PROJECT NUMBER: BRS 0204(4)

FILE NAME: 83ell\Sr+uc+\sellxs.dgn

PLOT DATE: 07-APR-2008

PROJECT LEADER: EVANS-MONGEON

DRAWN BY: U. STANLEY

DESIGNED BY: U. STANLEY

CHECKED BY: EVANS-MONGEON

IPARM: sellde+xs2.i

SHEET 100 OF 108

STA. 300+60 TO STA. 301+02