




301+09

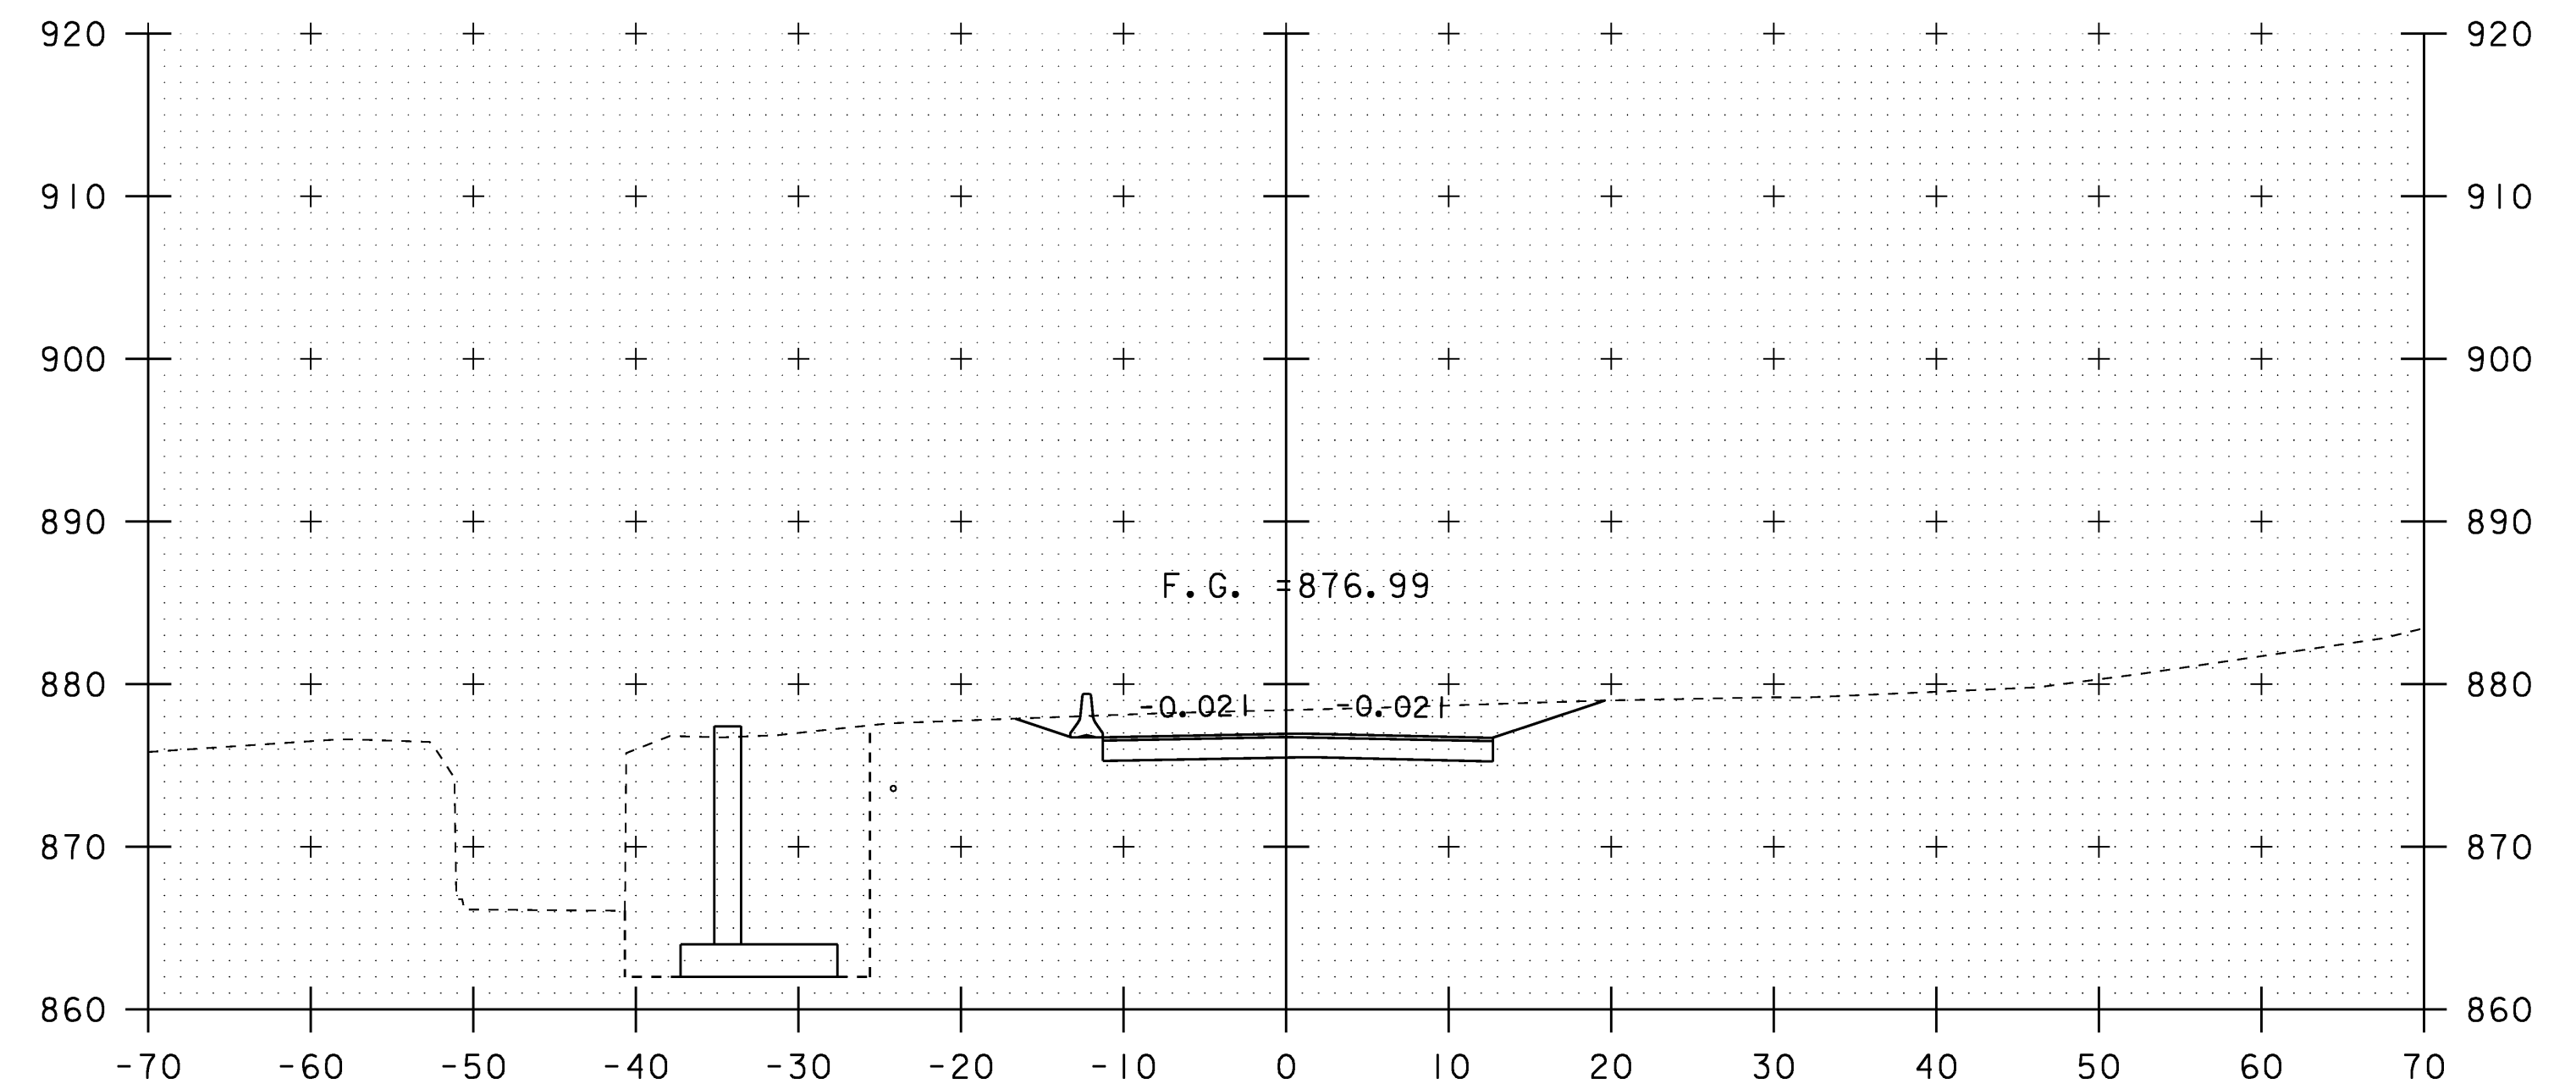


301+40

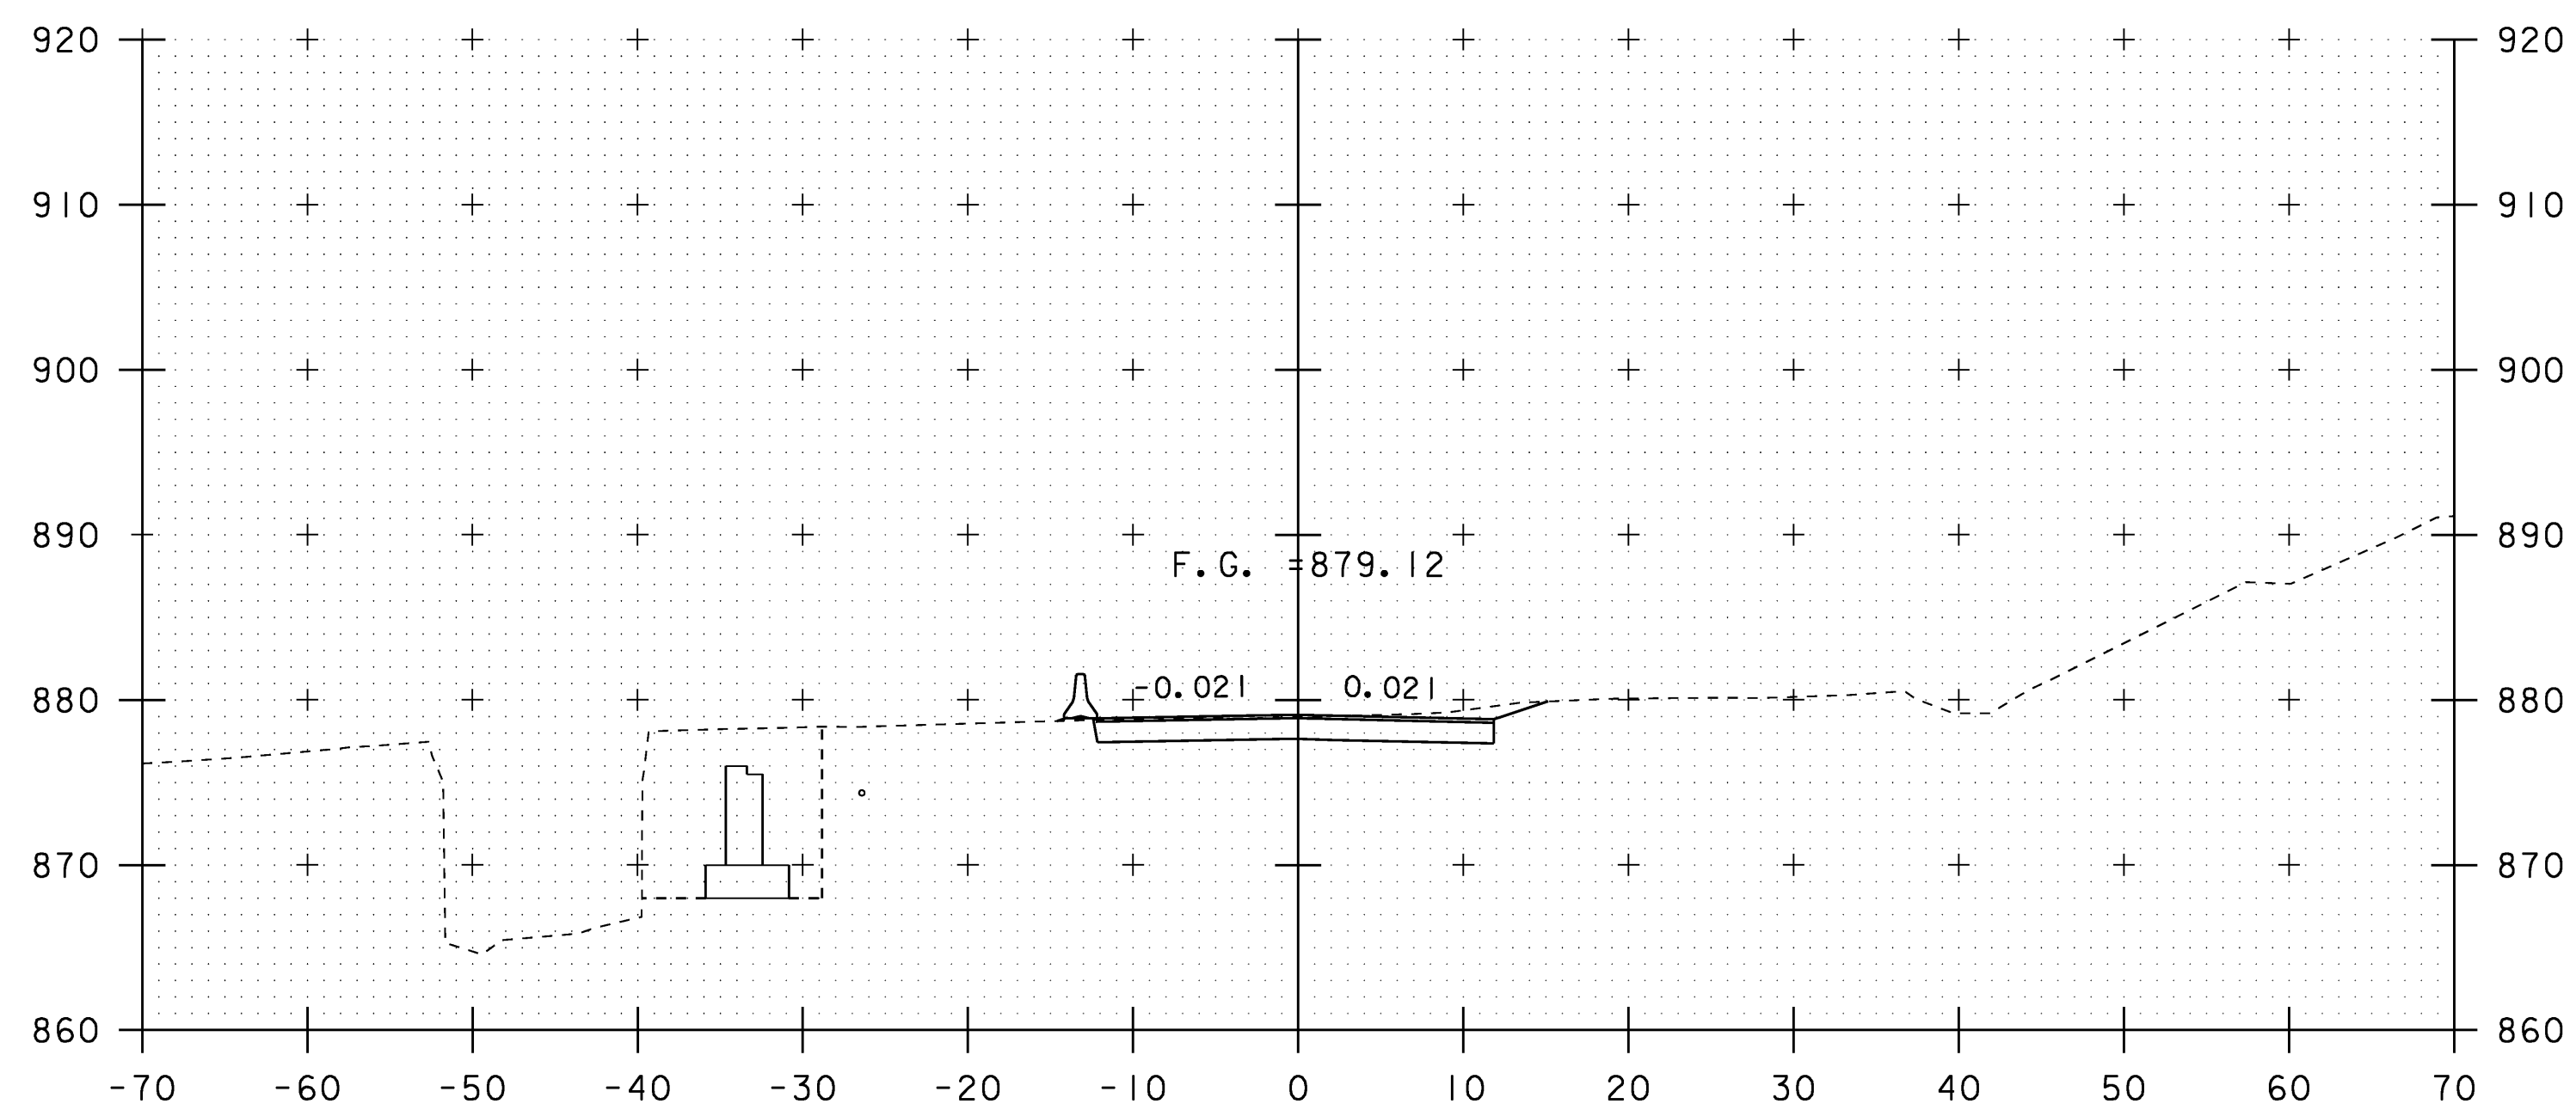

301+08

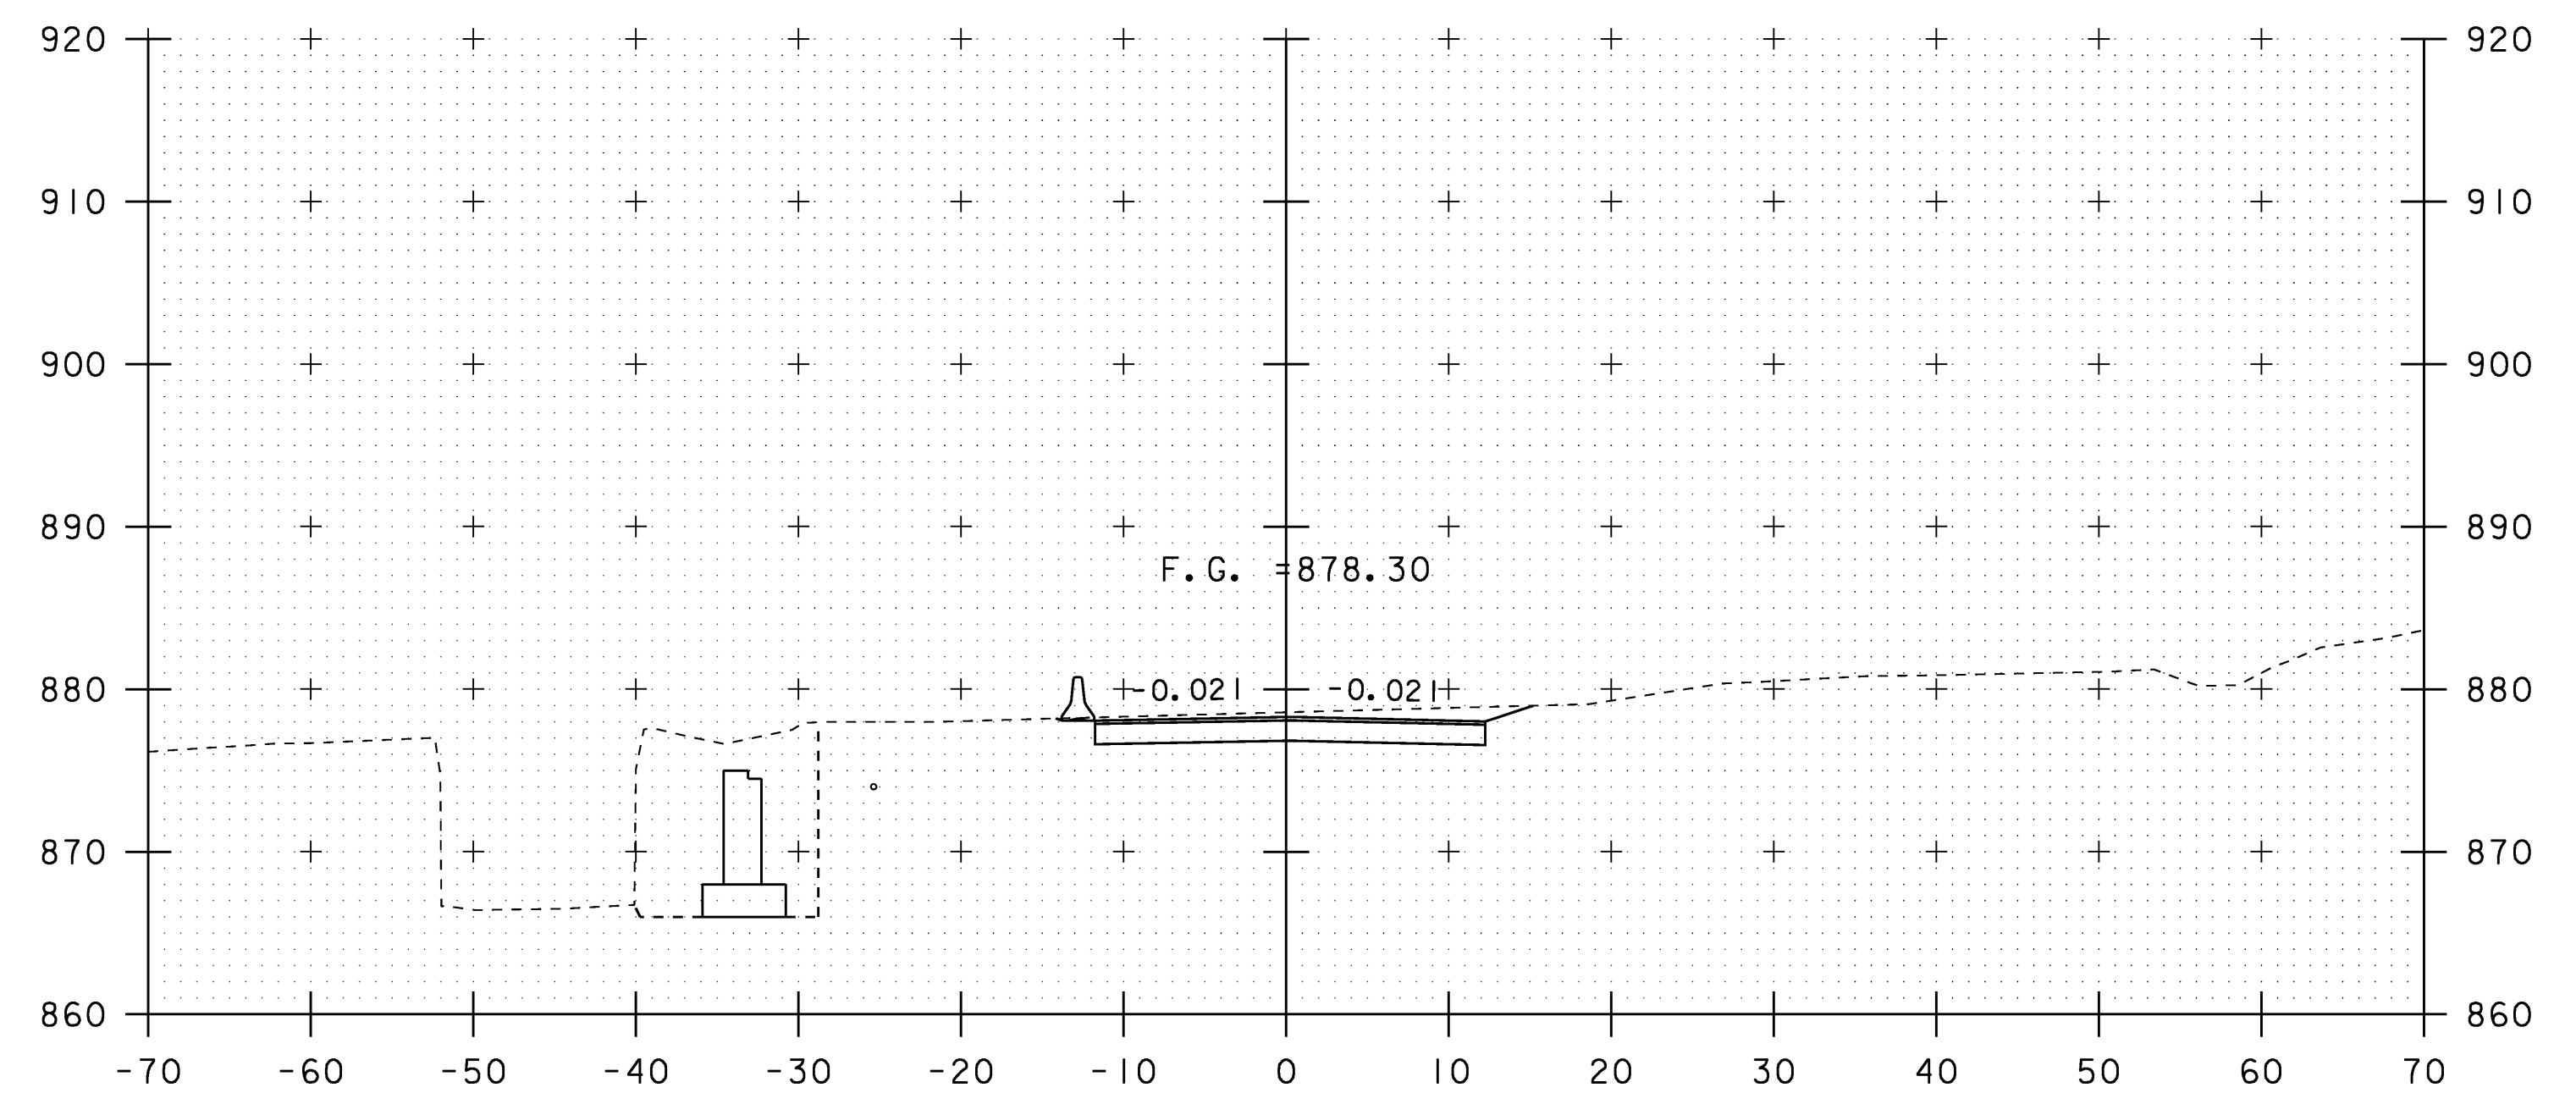

301+20

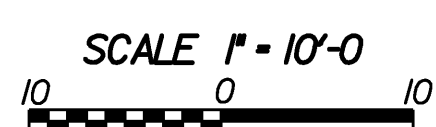

DETOUR CROSS SECTIONS

PROJECT NAME: WILLIAMSTOWN

PROJECT NUMBER: BRS 0204(4)

FILE NAME: 83ell\Sr+uc+\sellxs.dgn

PROJECT LEADER: EVANS-MONGEON

DESIGNED BY: U. STANLEY

IPARM: sellde+xs3.l

PLOT DATE: 07-APR-2008

DRAWN BY: U. STANLEY

CHECKED BY: EVANS-MONGEON

SHEET 101 OF 108

STA. 301+08 TO STA. 301+40