




301+80

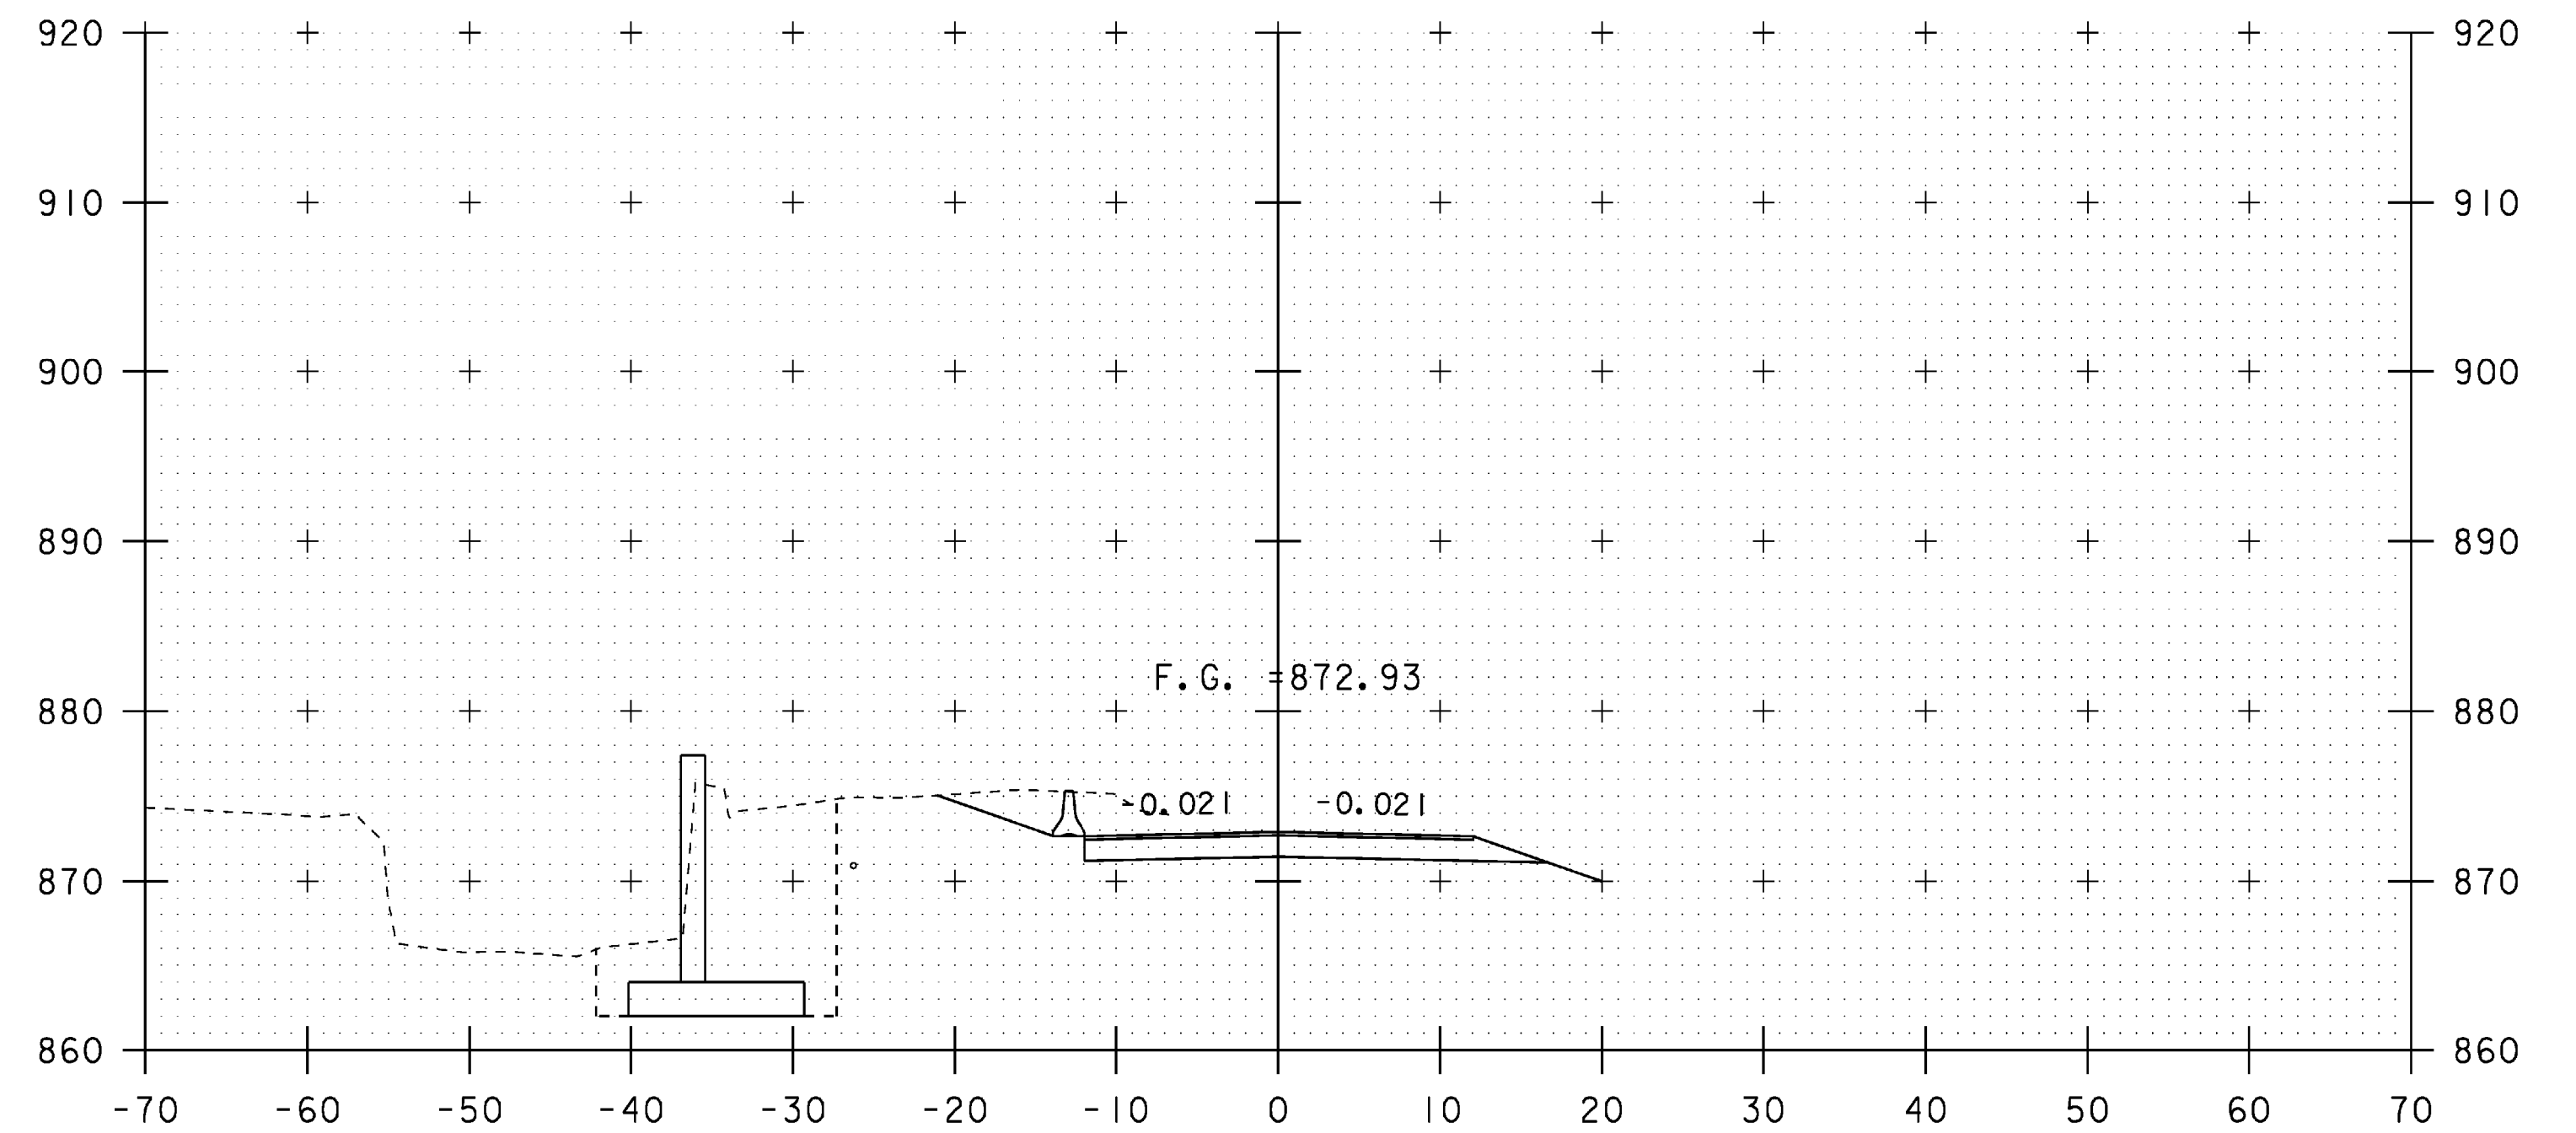


302+12

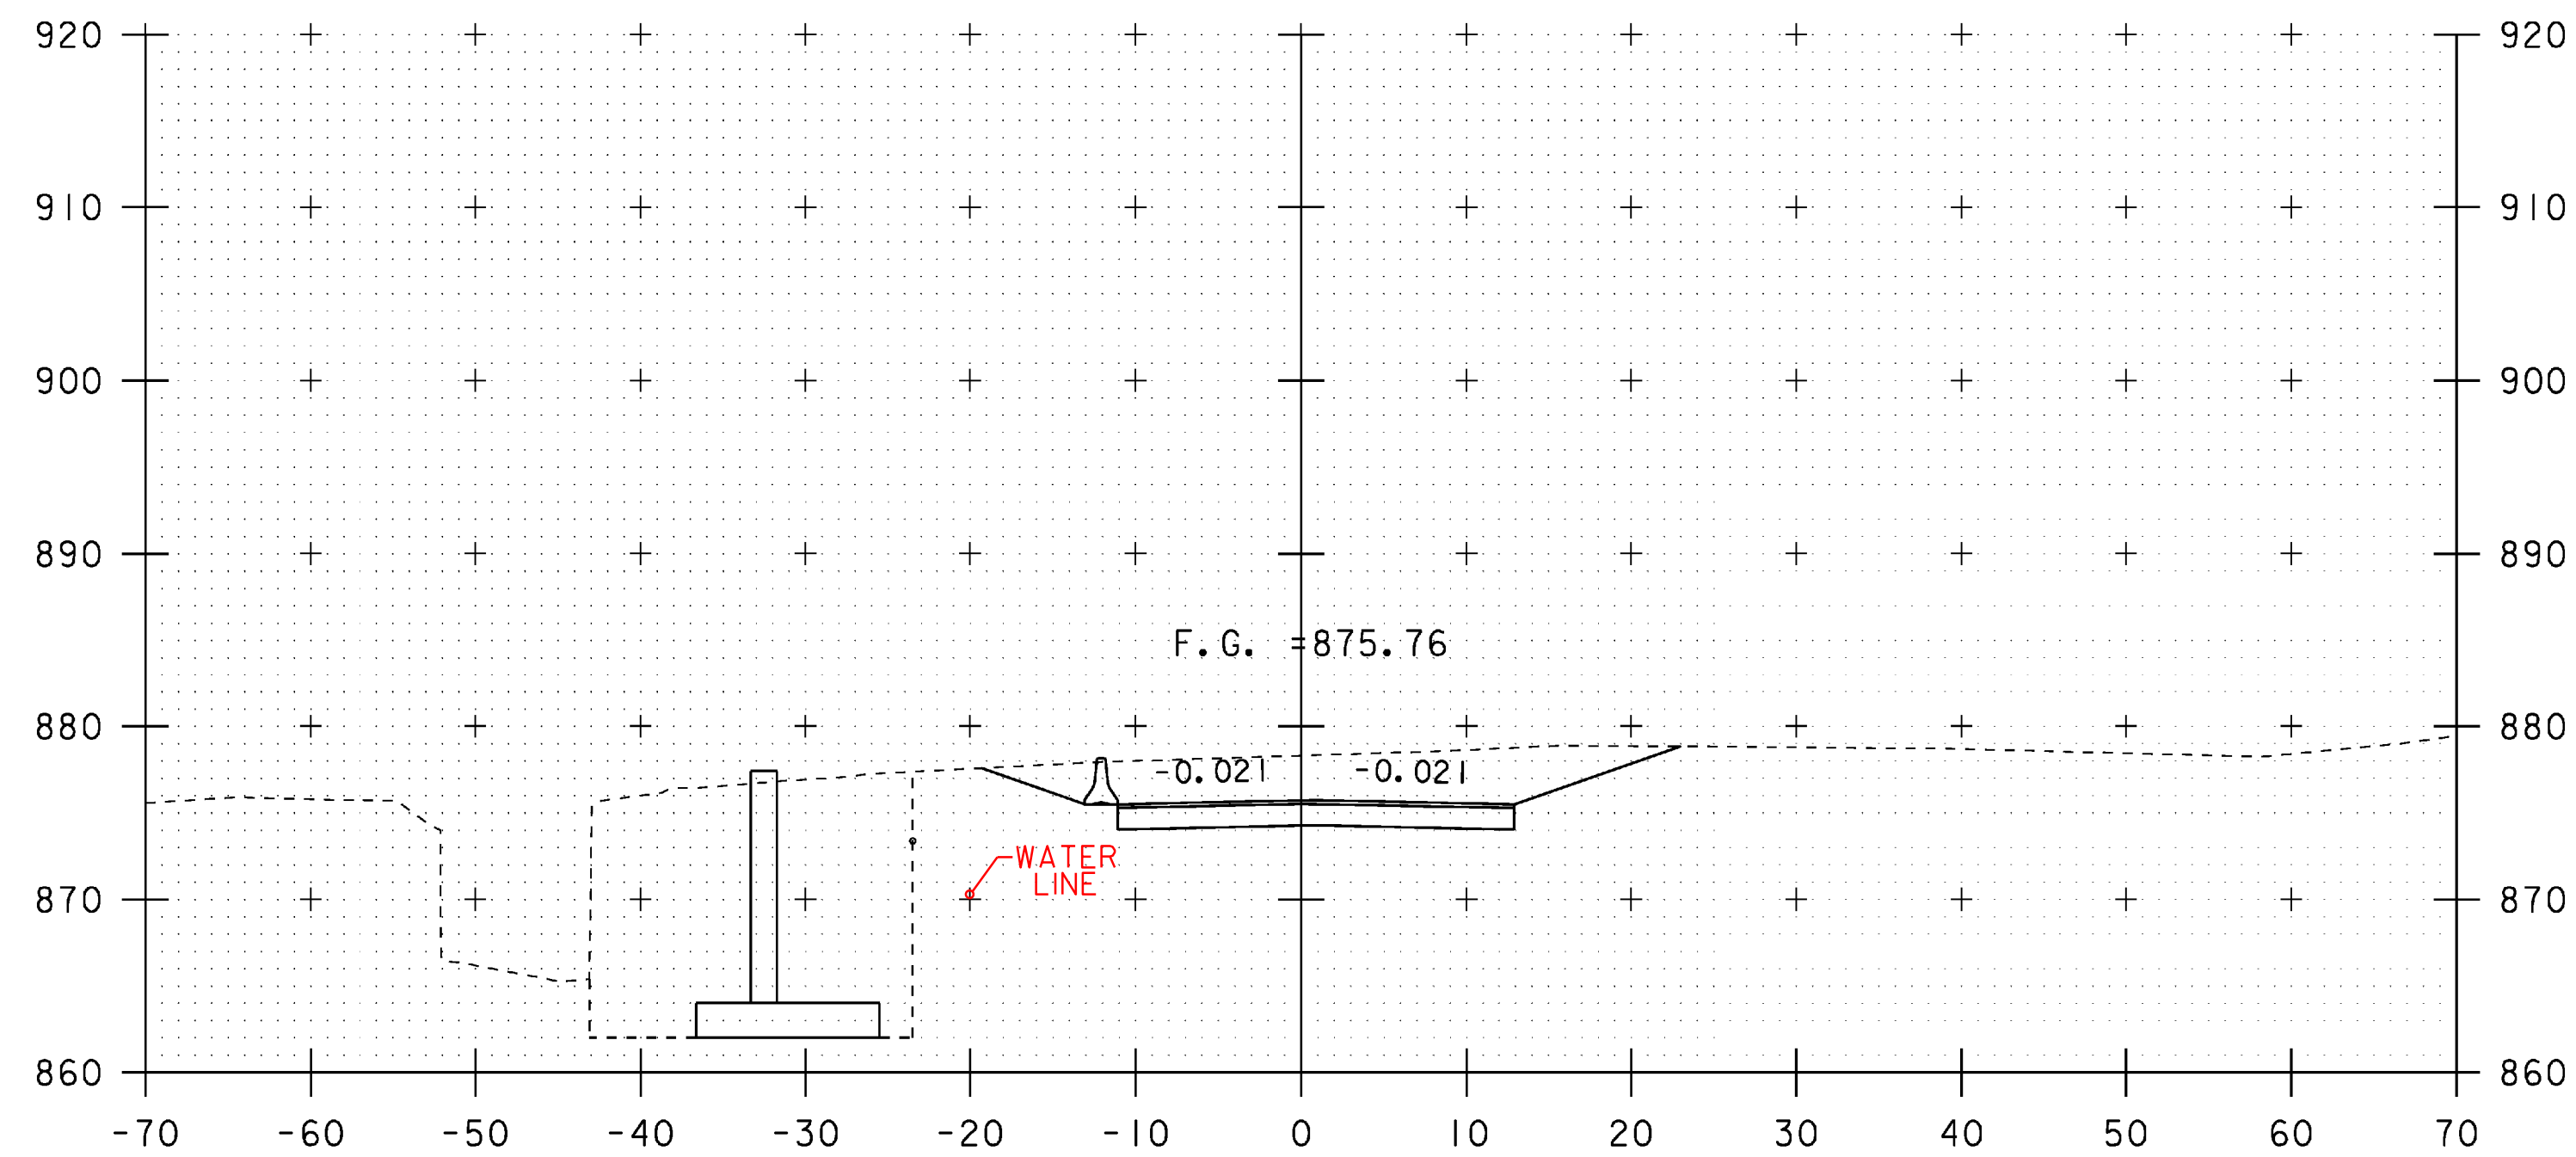

301+60

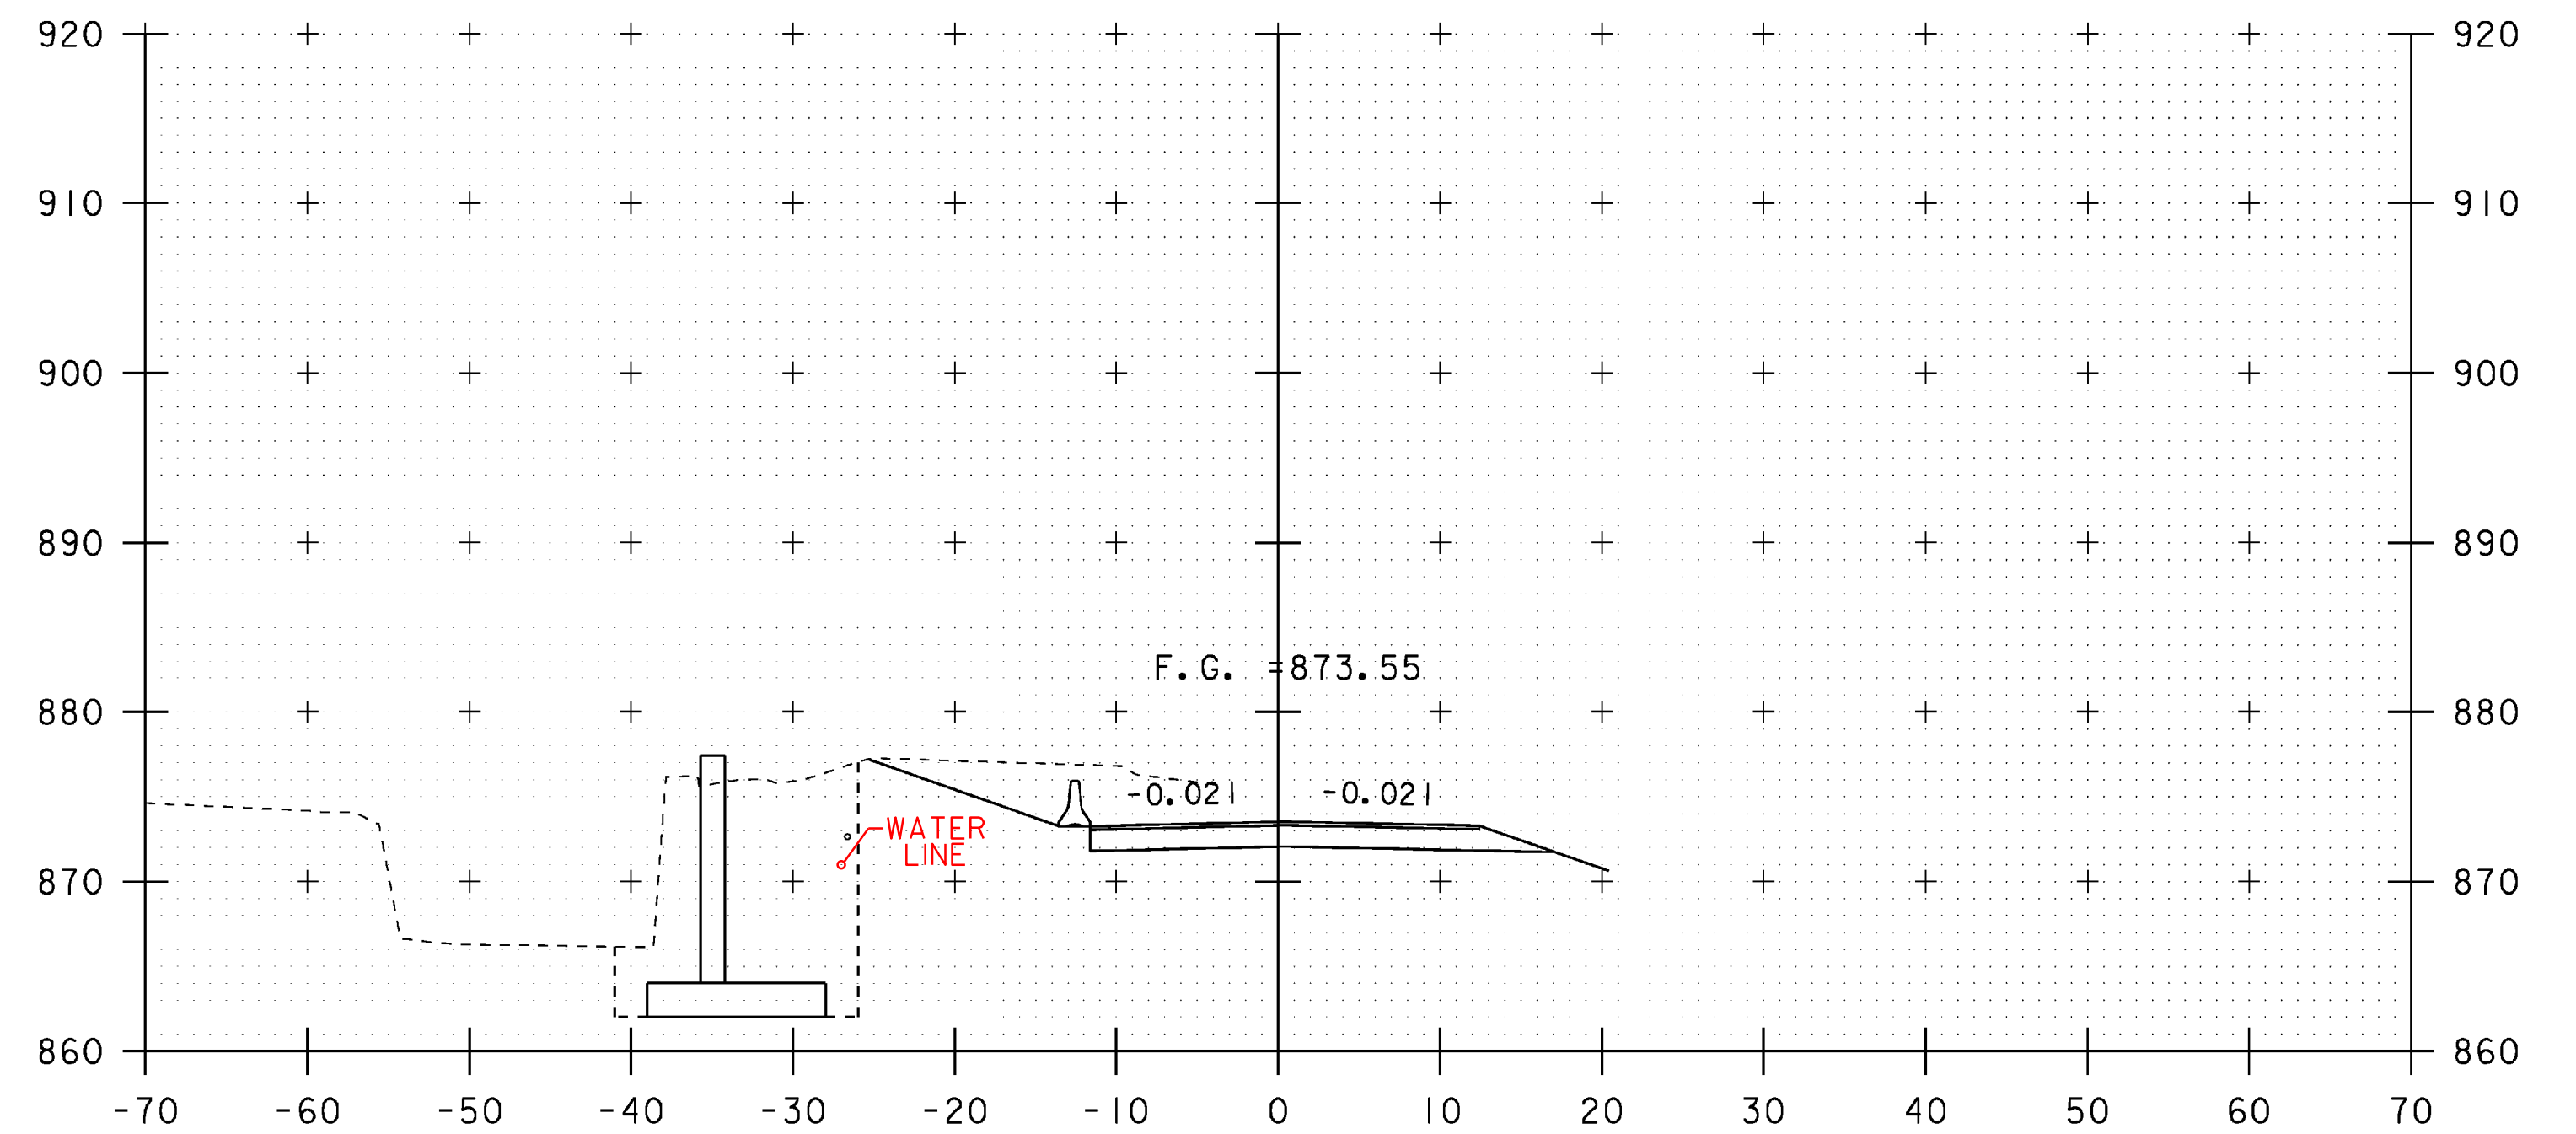

302+00

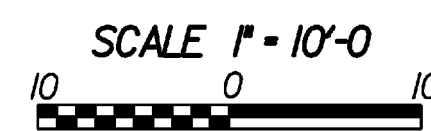

STA. 301+60 TO STA. 302+12

DETOUR CROSS SECTIONS

PROJECT NAME: WILLIAMSTOWN
PROJECT NUMBER: BRS 0204(4)

FILE NAME: 83ell\Sr+uct\sellxs.dgn	PLOT DATE: 07-APR-2008
PROJECT LEADER: EVANS-MONGEON	DRAWN BY: U. STANLEY
DESIGNED BY: U. STANLEY	CHECKED BY: EVANS-MONGEON
IPARM: selldetxs4.I	SHEET 102 OF 108