




302+40

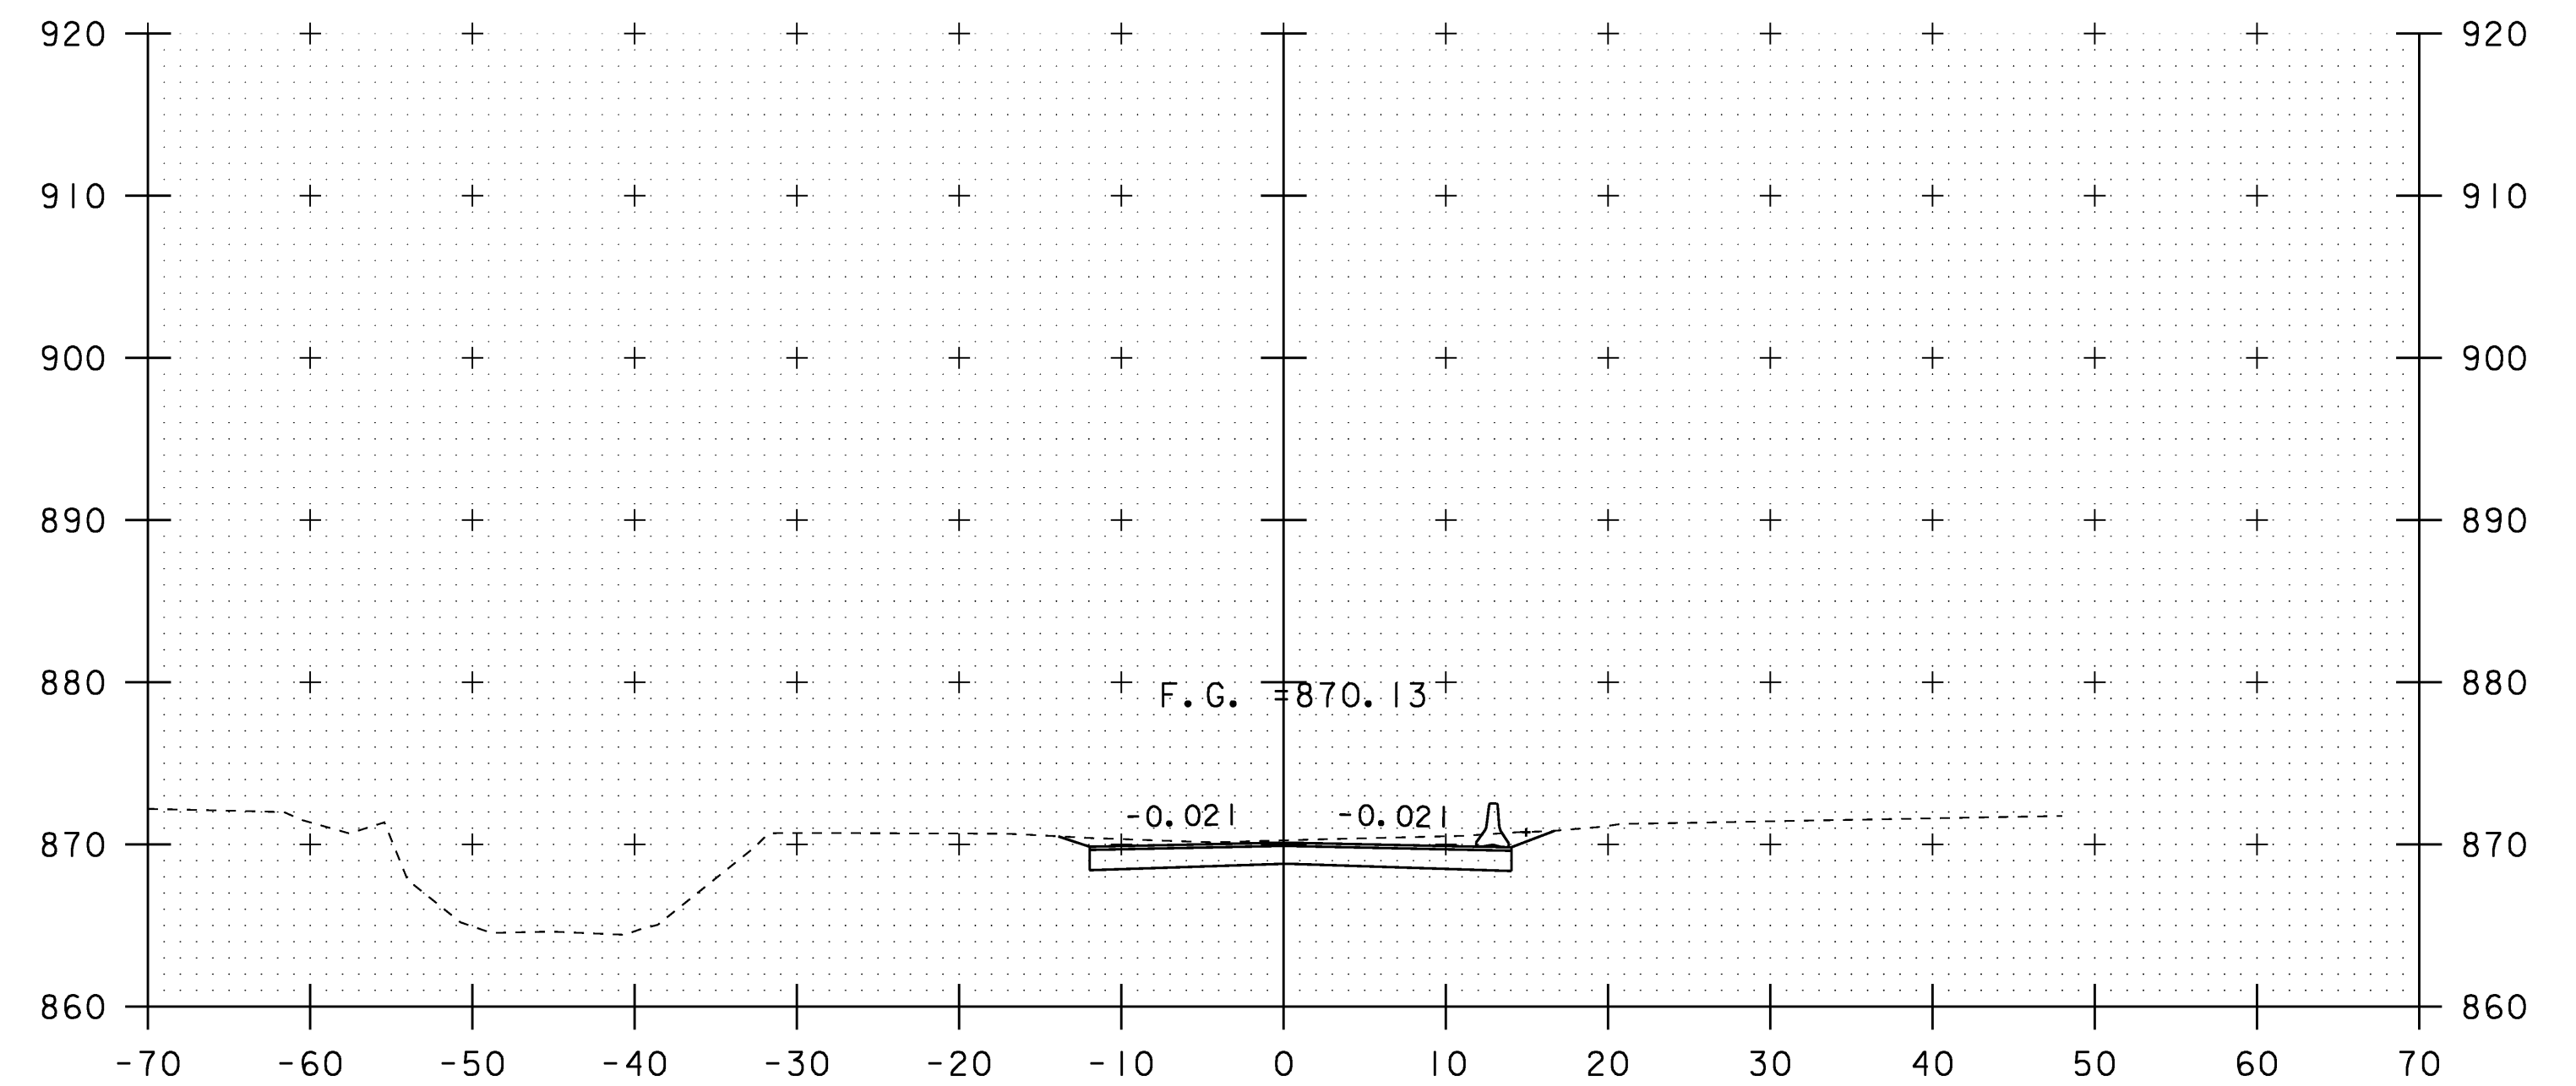


302+80

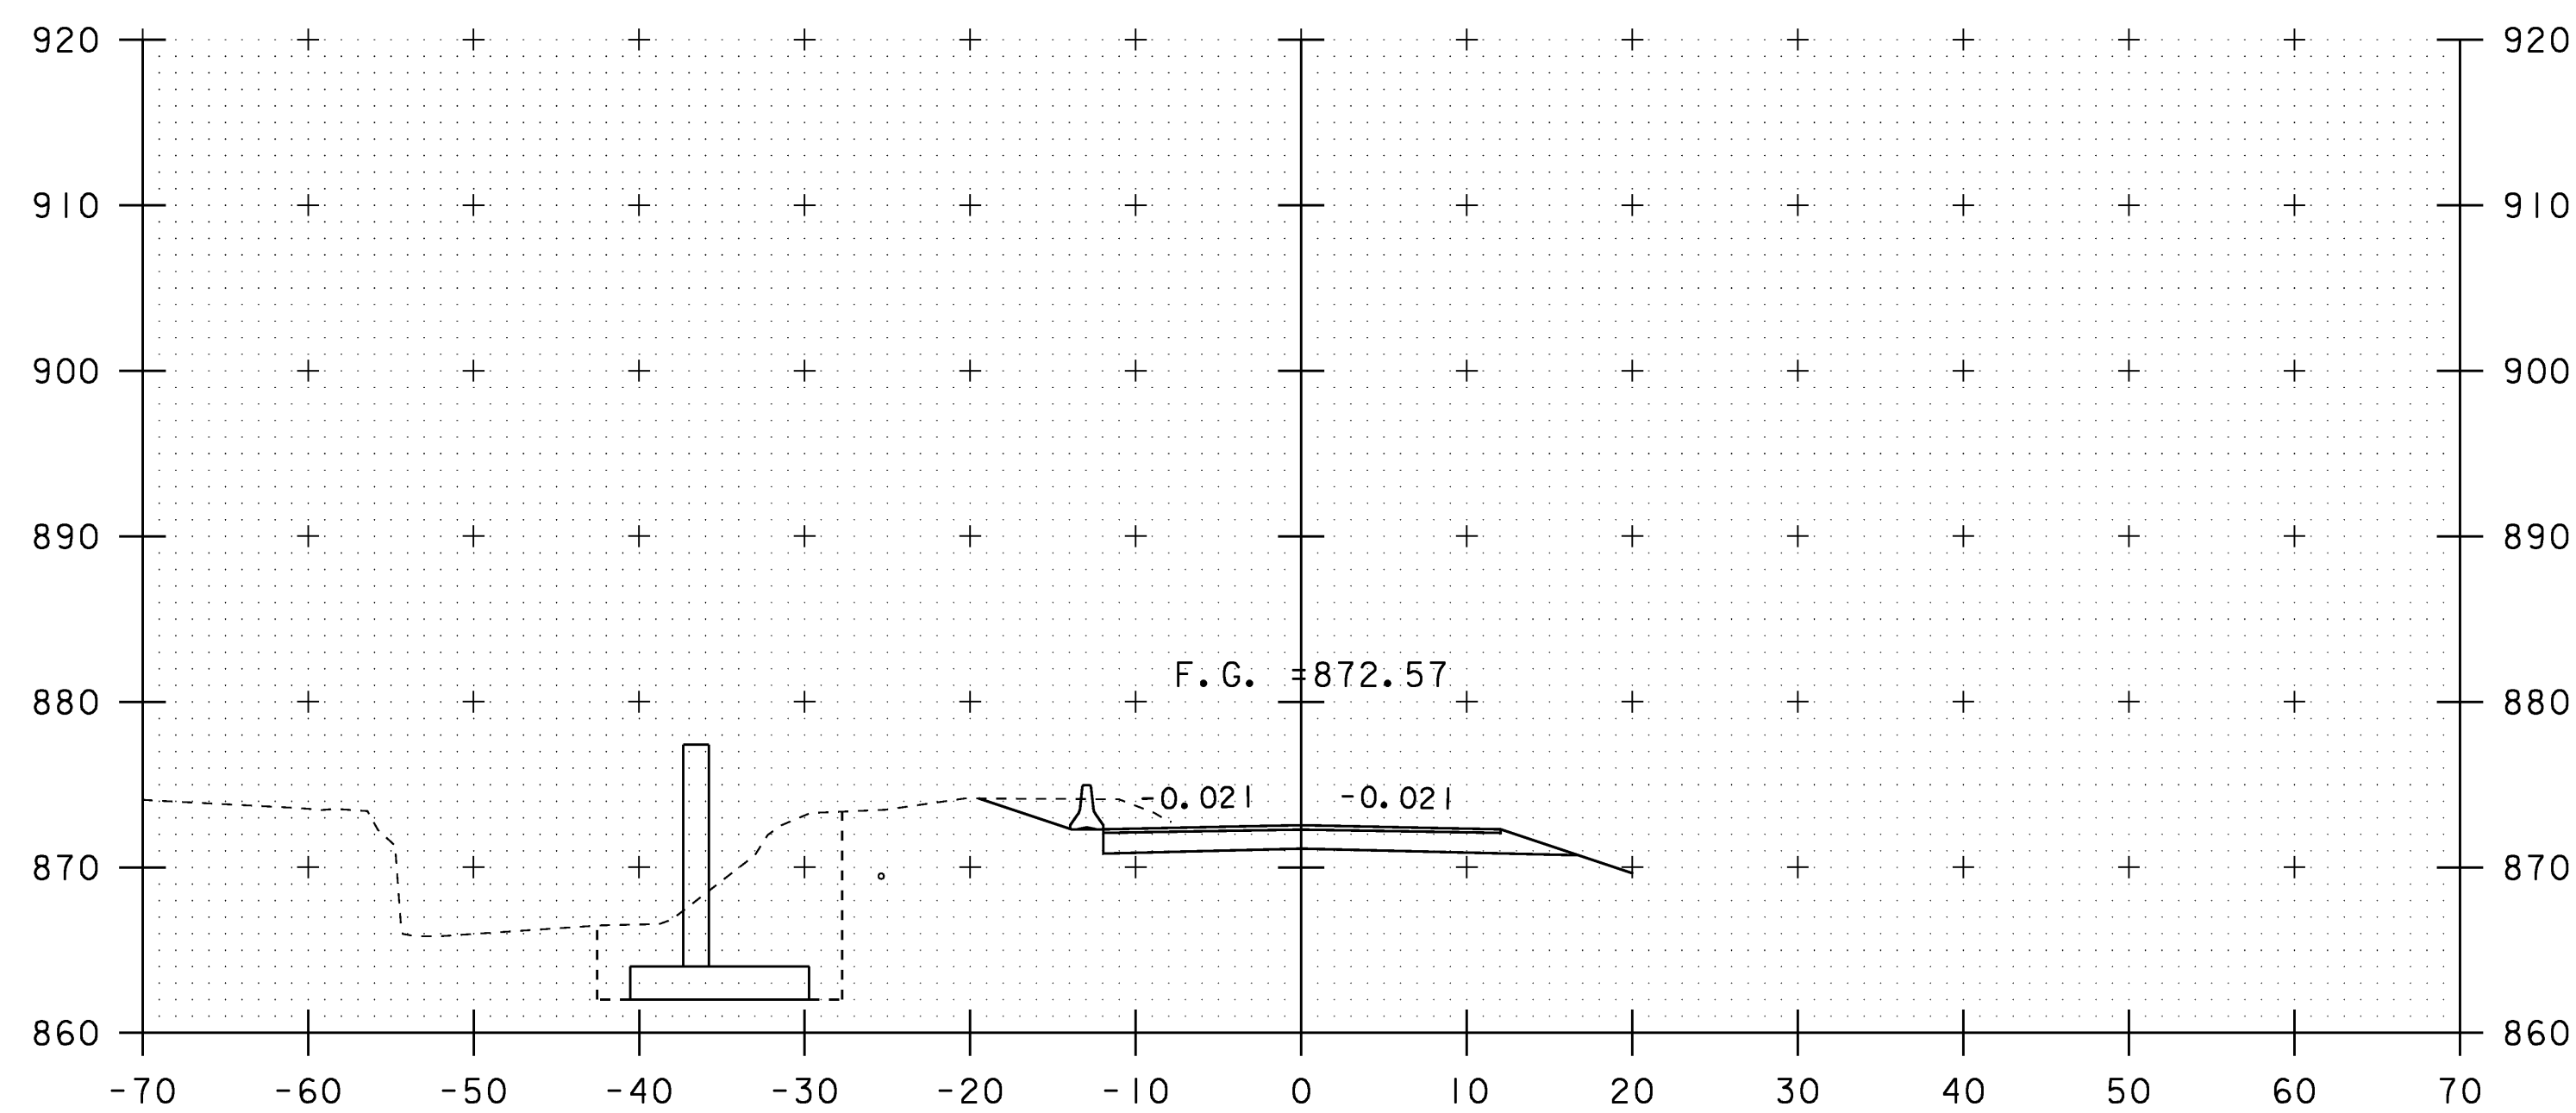

302+20

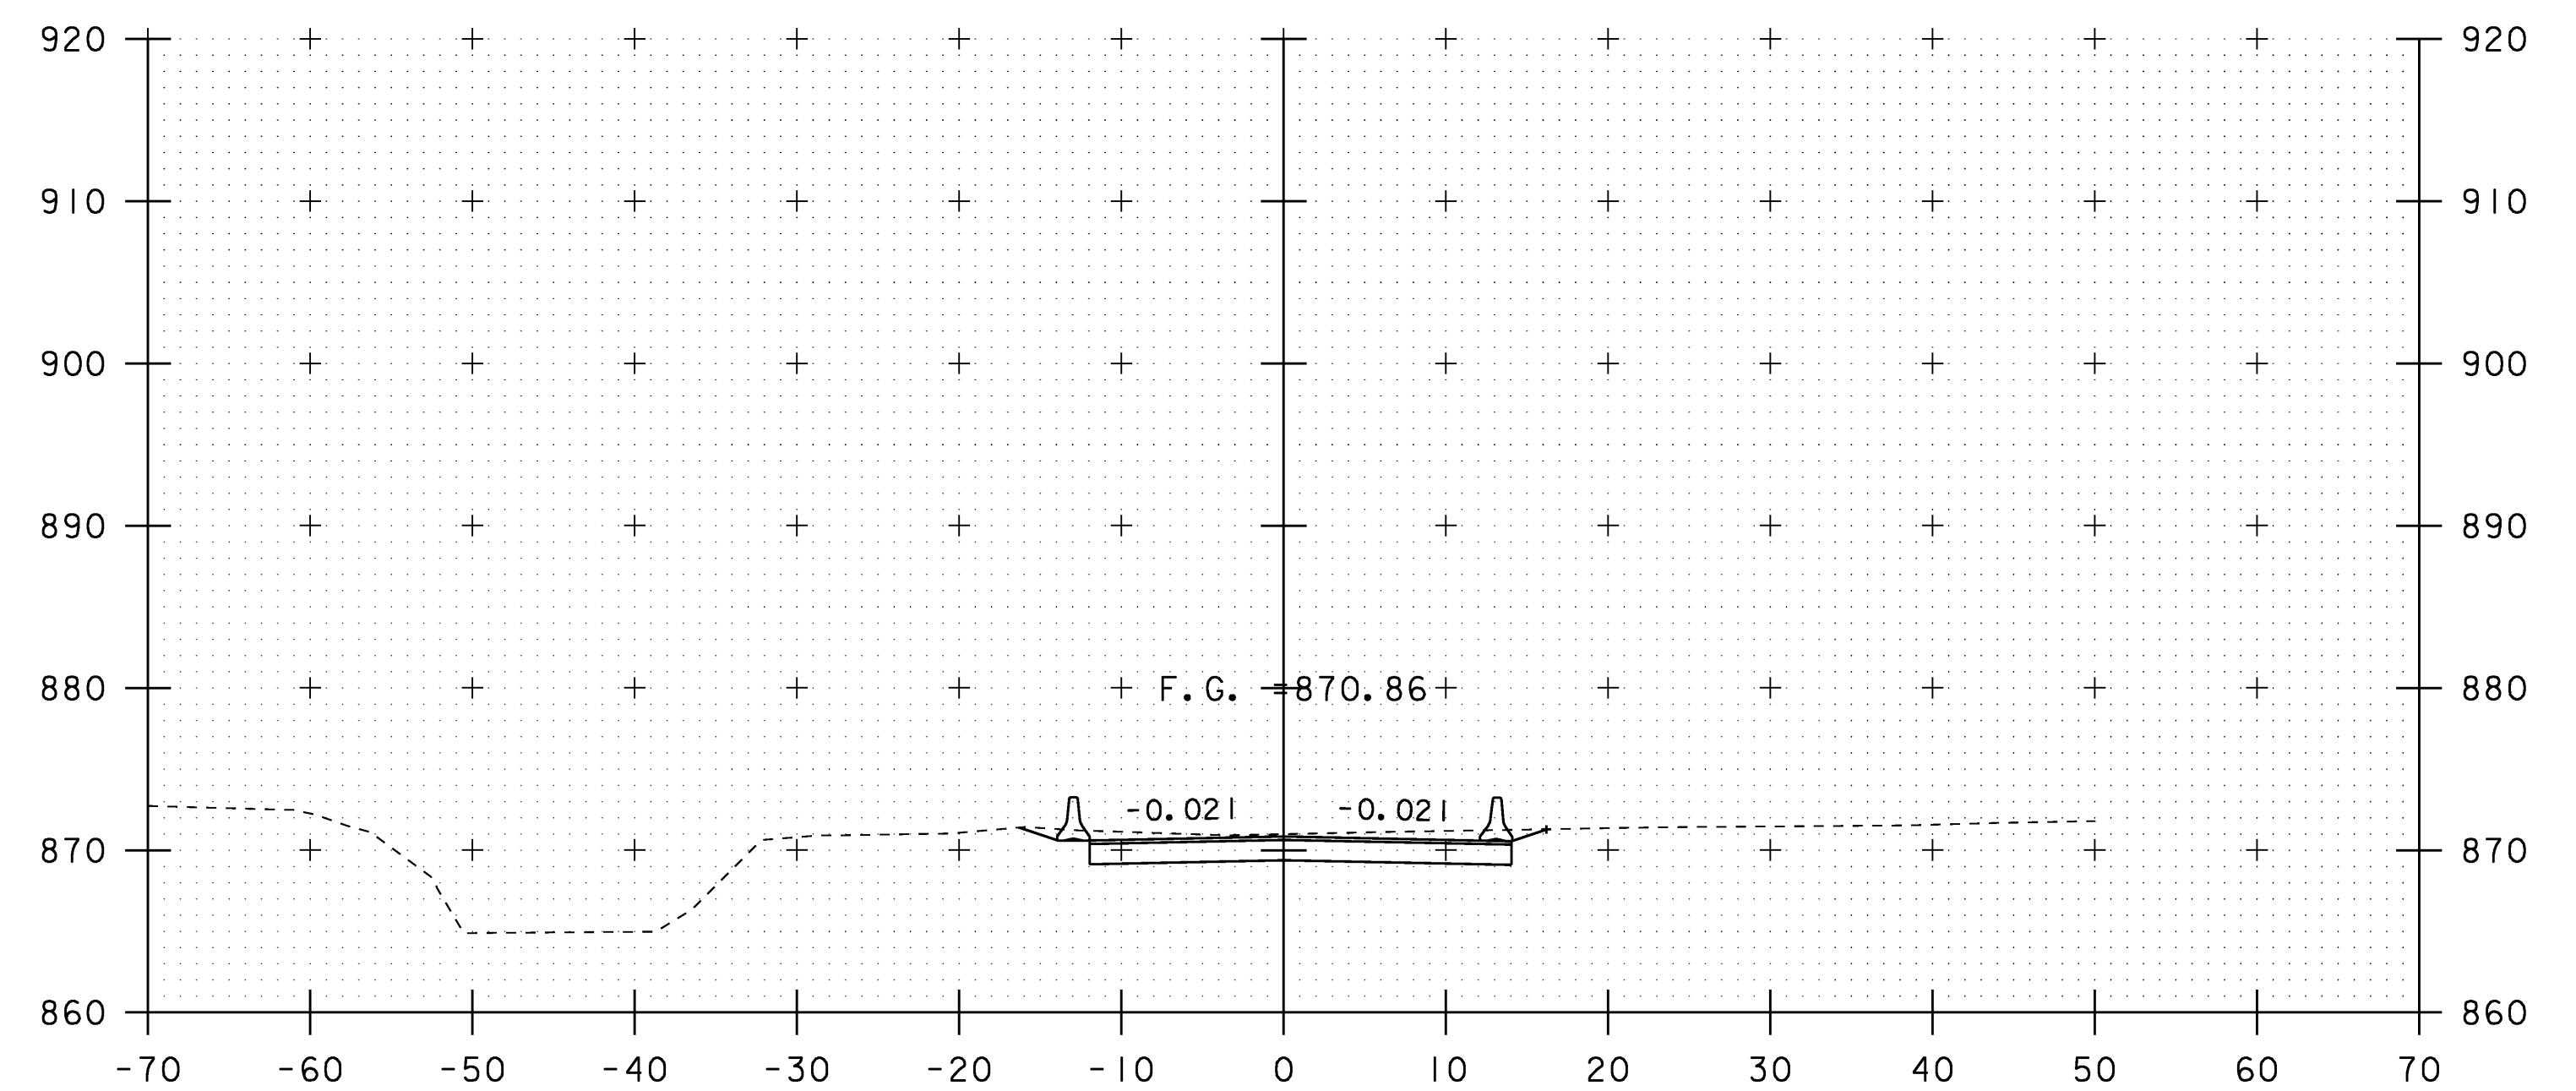

302+60

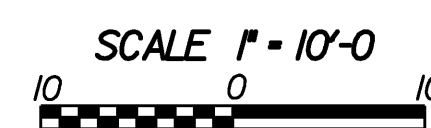

DETOUR CROSS SECTIONS

PROJECT NAME: WILLIAMSTOWN
 PROJECT NUMBER: BRS 0204(4)

FILE NAME: 83ell\Sr+uc+\sellxs.dgn
 PROJECT LEADER: EVANS-MONGEON
 DESIGNED BY: U. STANLEY
 IPARM: sellde+xs5.1

PLOT DATE: 07-APR-2008
 DRAWN BY: U. STANLEY
 CHECKED BY: EVANS-MONGEON
 SHEET 103 OF 108