




303+20

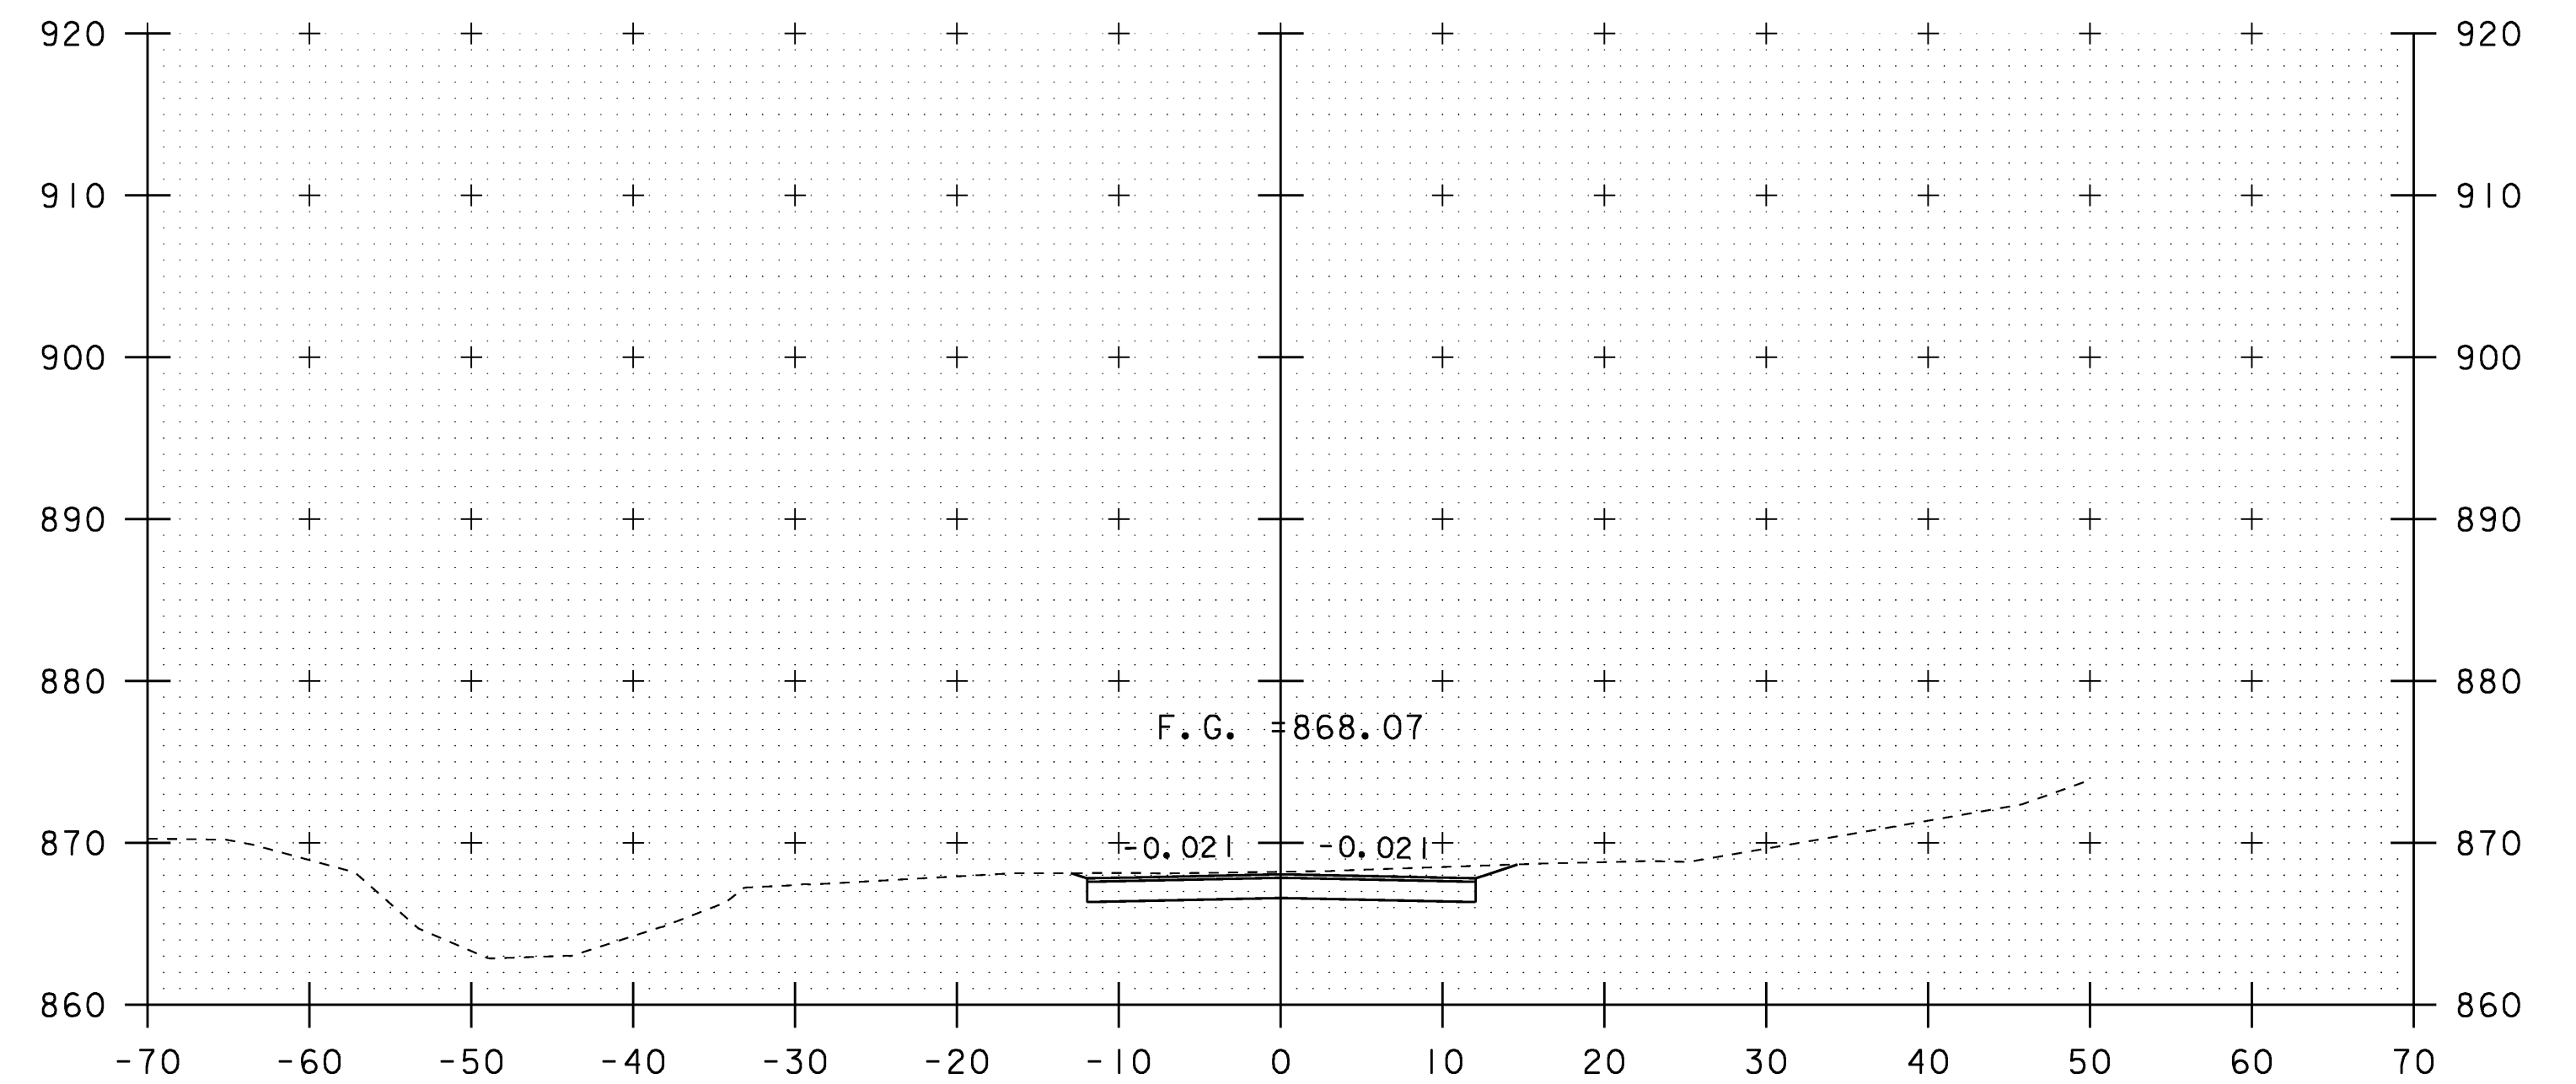


303+60

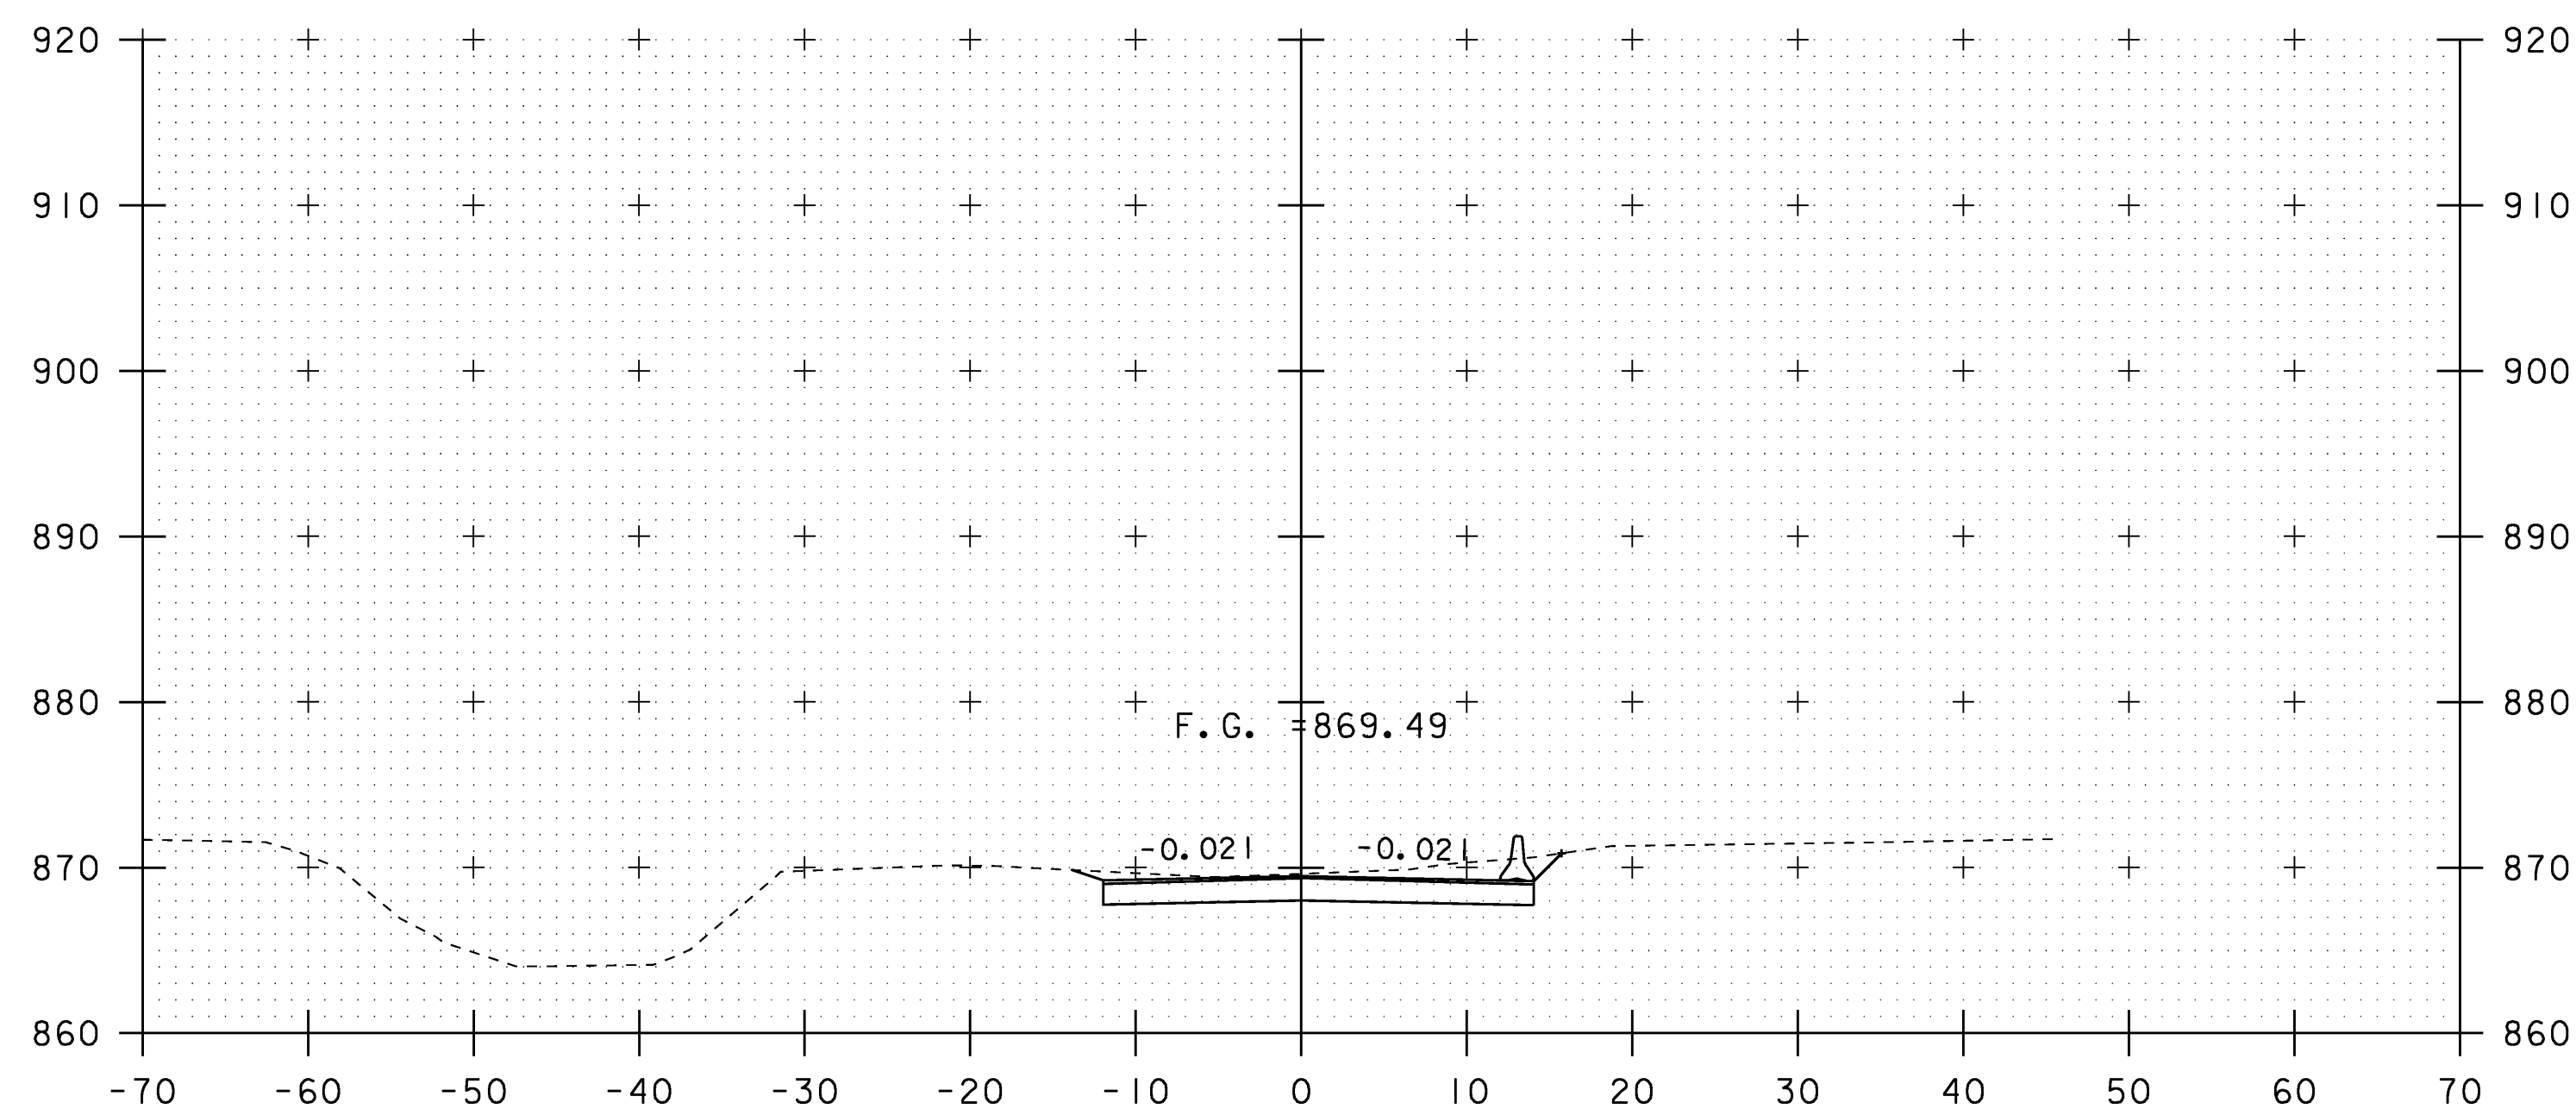

303+00

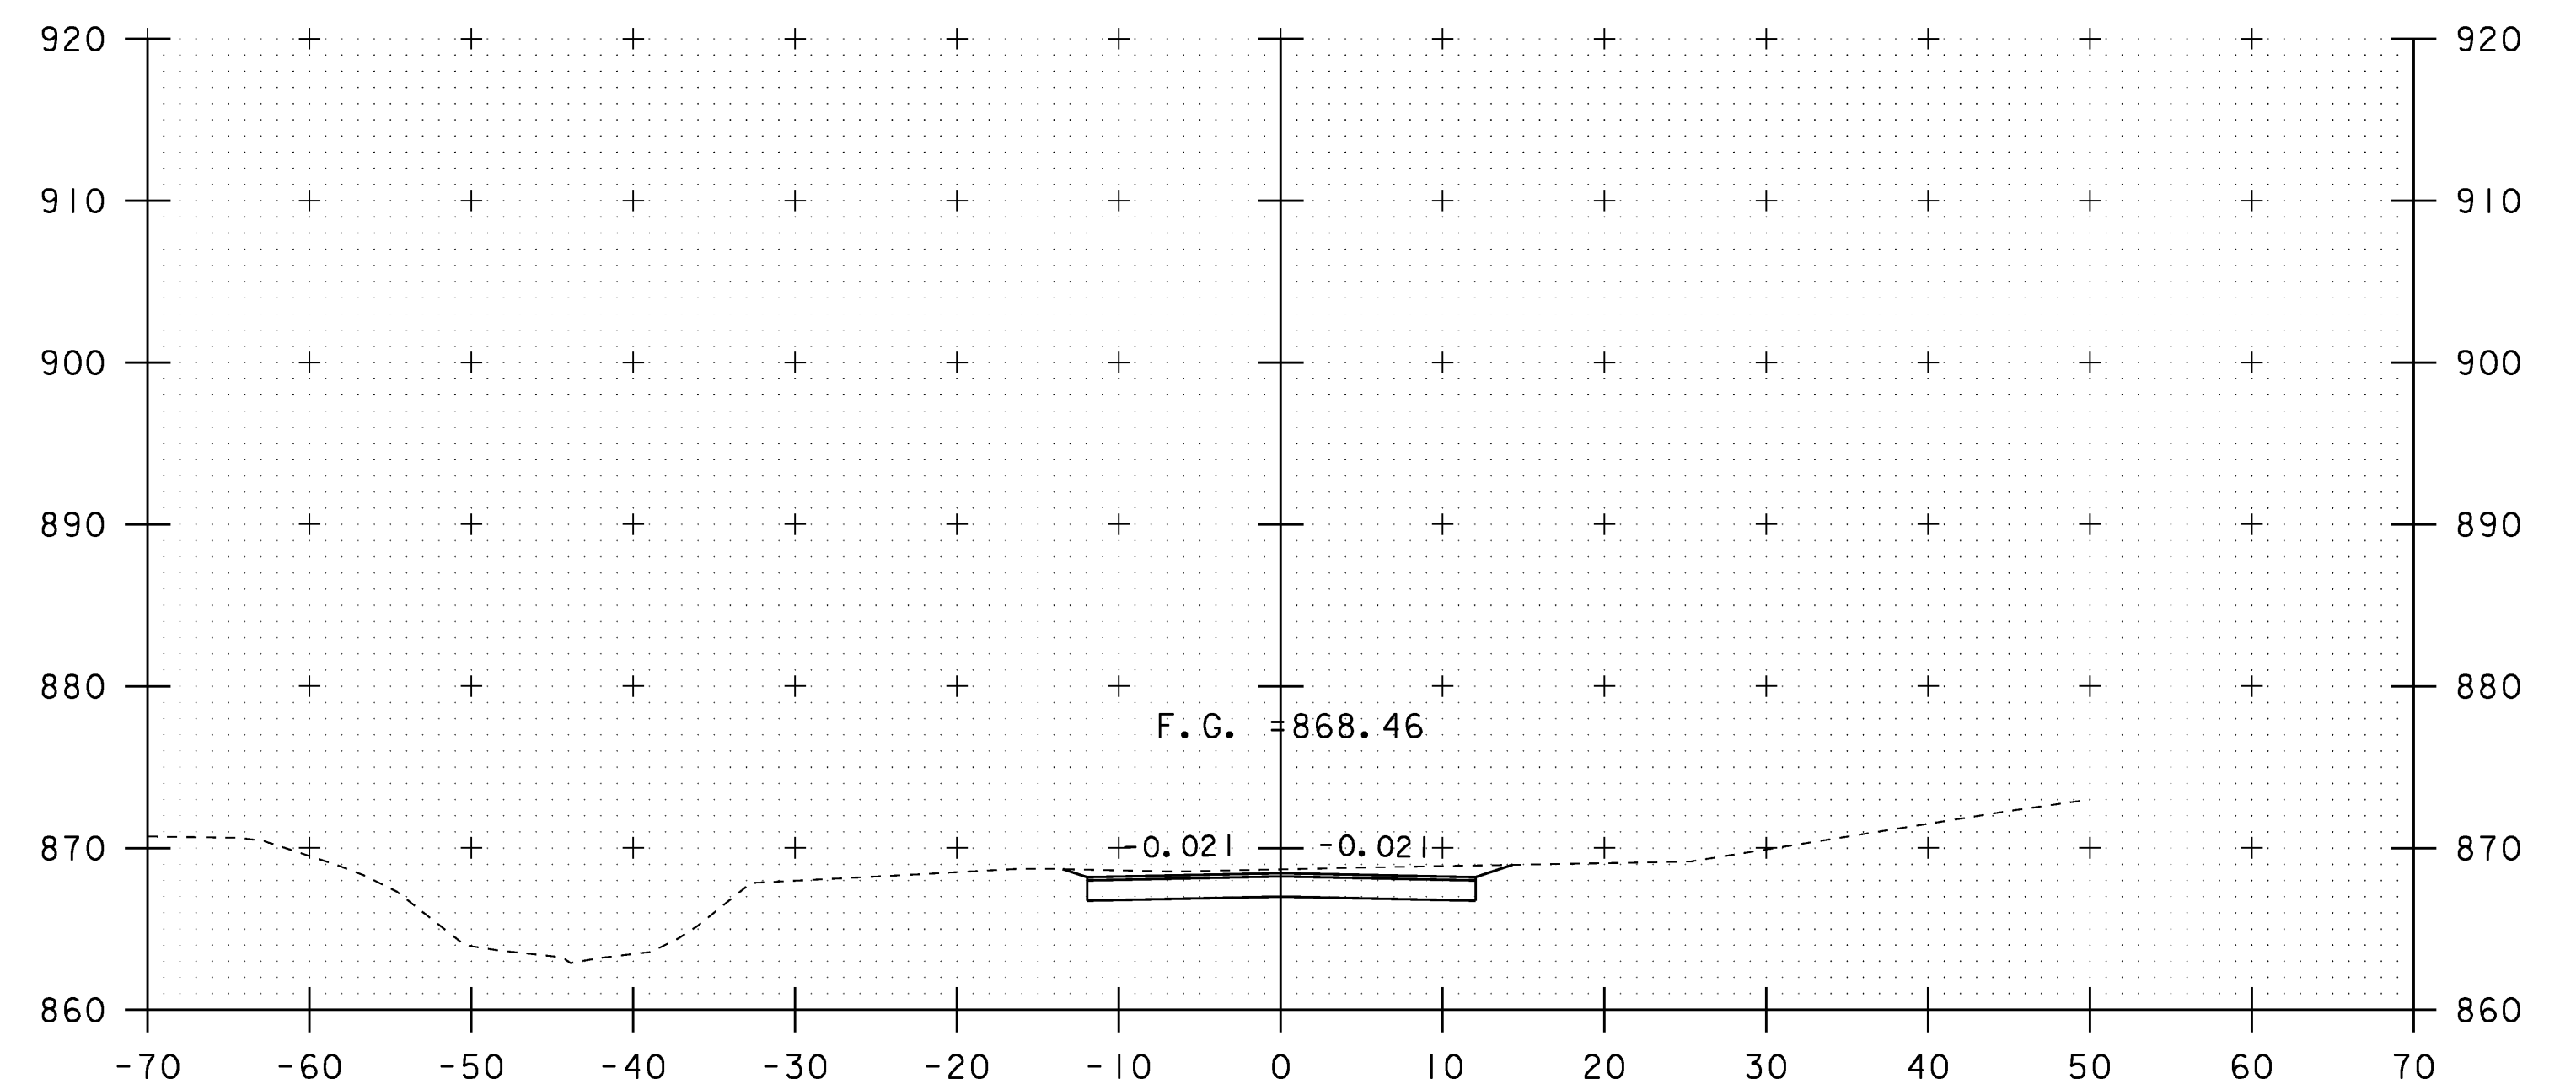

303+40

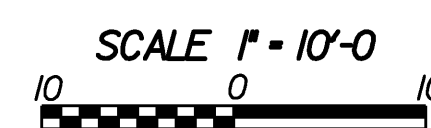

DETOUR CROSS SECTIONS

PROJECT NAME: WILLIAMSTOWN	PLOT DATE: 07-APR-2008
PROJECT NUMBER: BRS 0204(4)	DRAWN BY: U. STANLEY
FILE NAME: 83ell\Sr+uc+\sellxs.dgn	CHECKED BY: EVANS-MONGEON
PROJECT LEADER: EVANS-MONGEON	SHEET 104 OF 108
DESIGNED BY: U. STANLEY	
IPARM: sellde+xs6.l	