




304+00

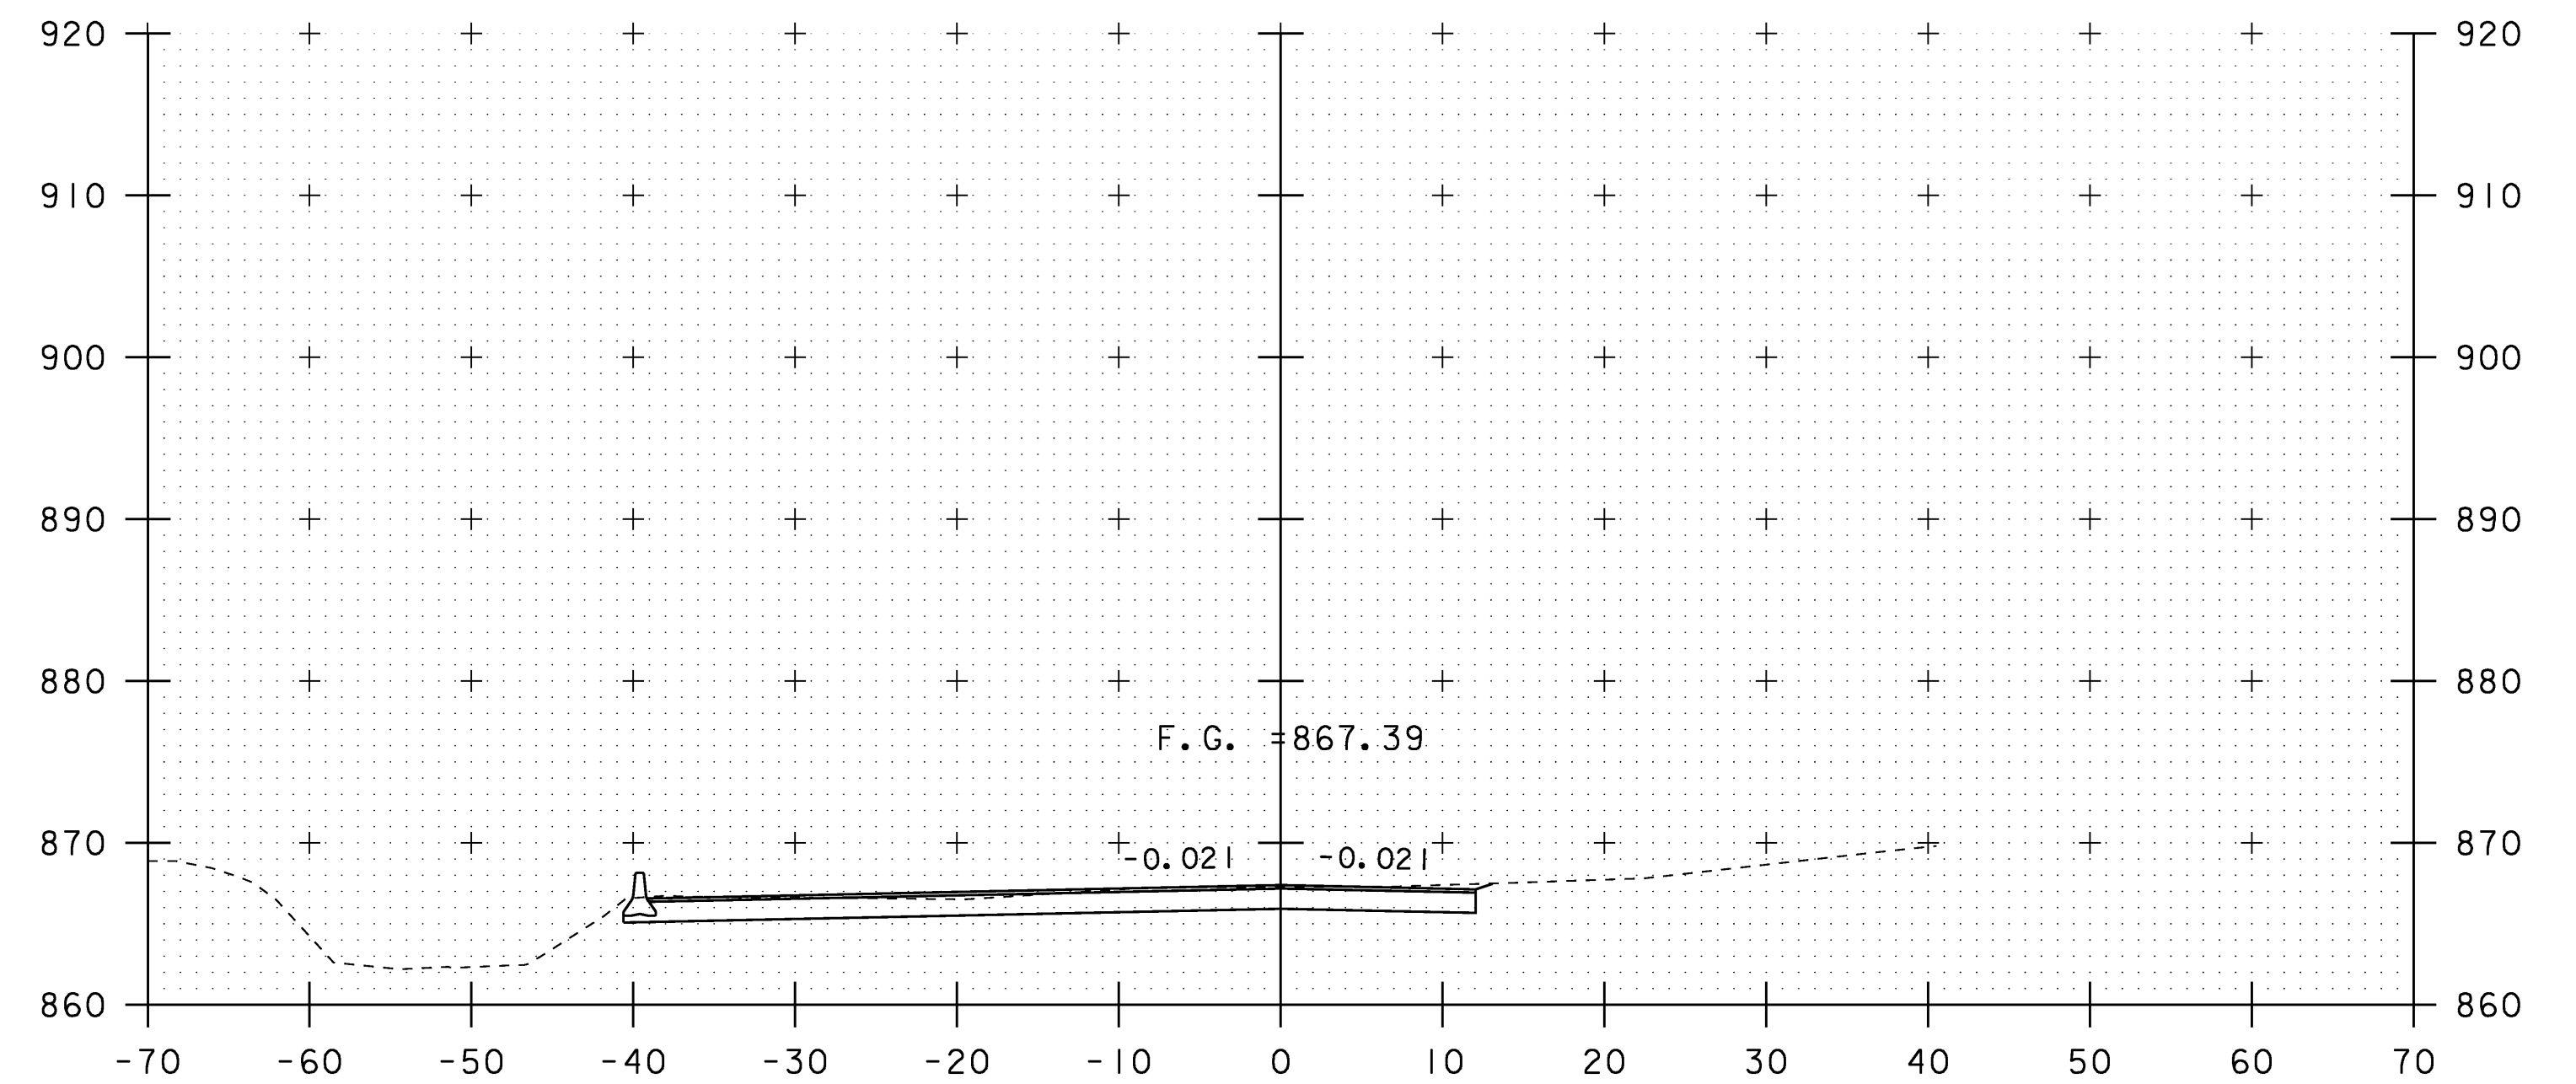


304+20

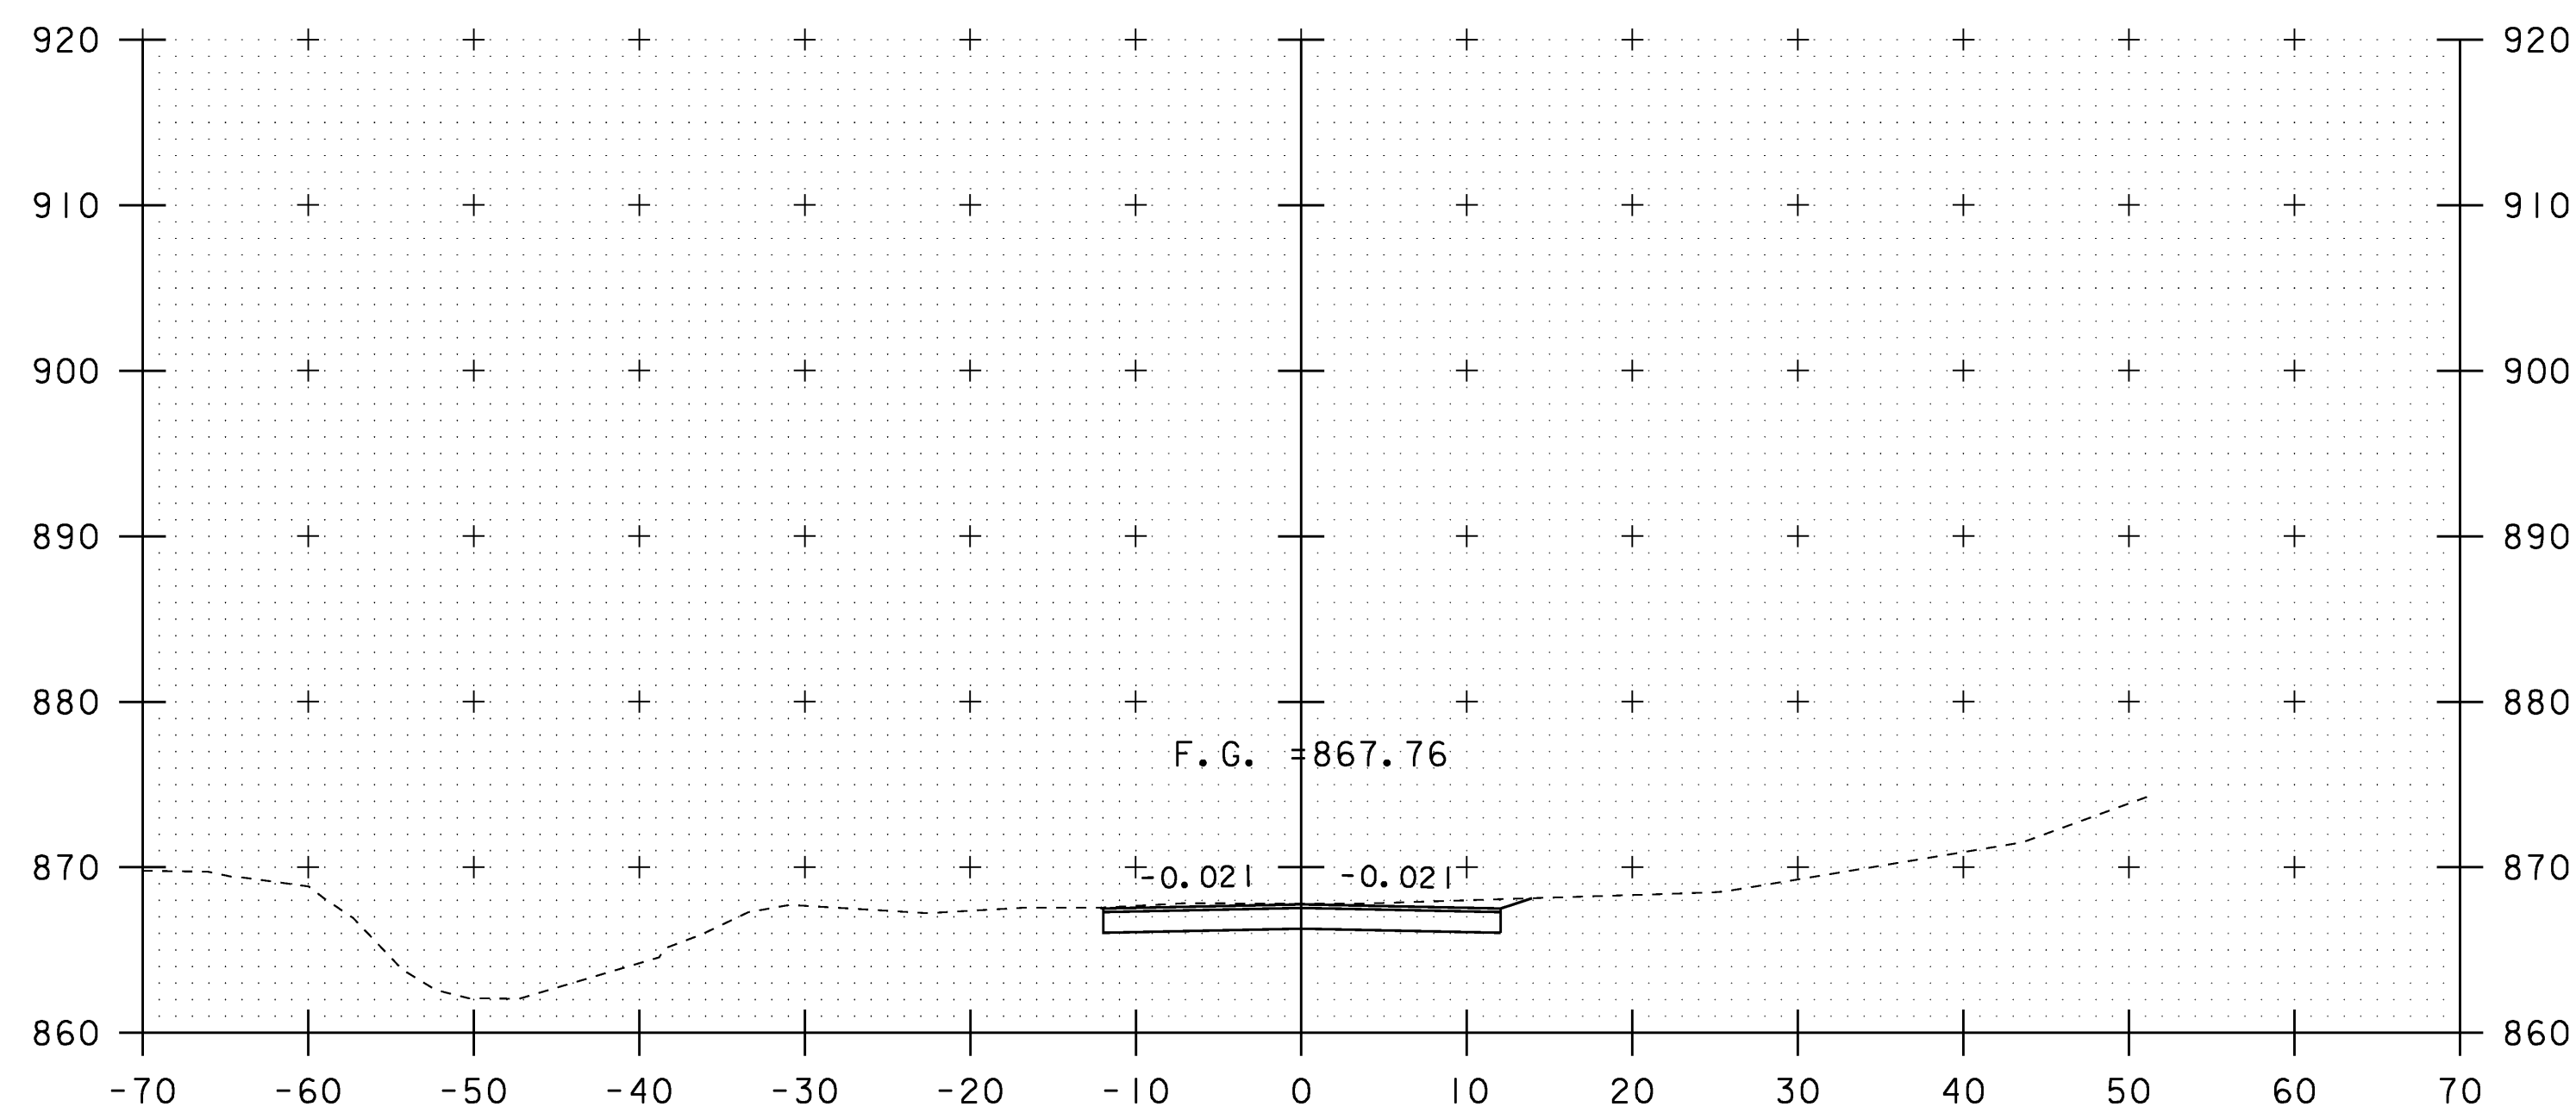

303+80

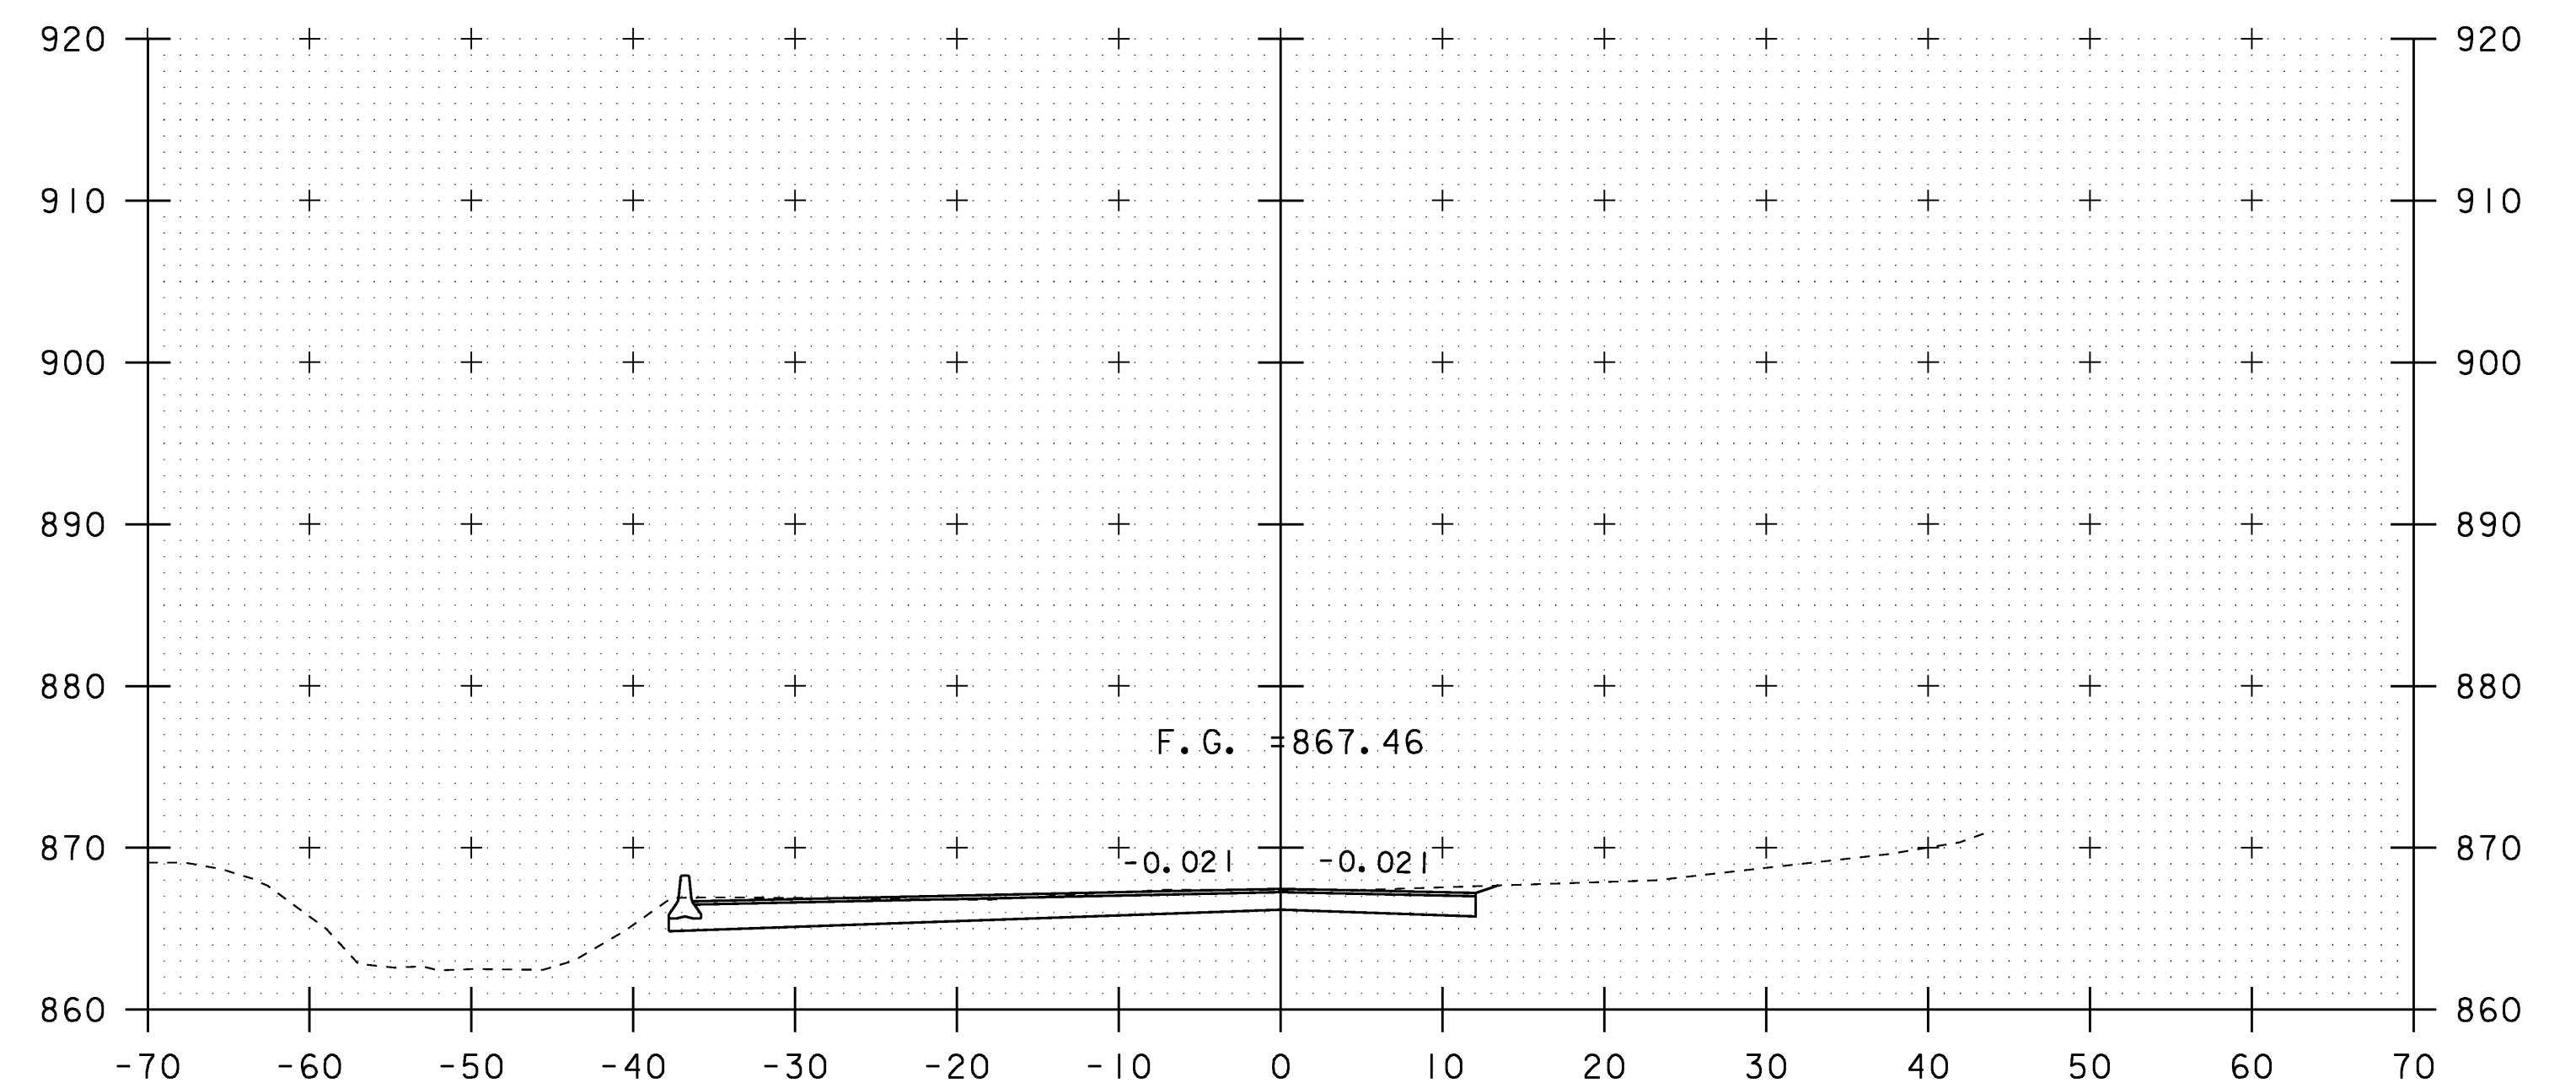

304+09

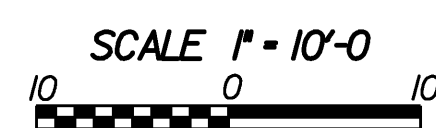

DETOUR CROSS SECTIONS

PROJECT NAME: WILLIAMSTOWN

PROJECT NUMBER: BRS 0204(4)

FILE NAME: 83ell\Sr+uc+\sellxs.dgn

PROJECT LEADER: EVANS-MONGEON

DESIGNED BY: U. STANLEY

IPARM: sellde+xs7.l

PLOT DATE: 07-APR-2008

DRAWN BY: U. STANLEY

CHECKED BY: EVANS-MONGEON

SHEET 105 OF 108

STA. 303+80 TO STA. 304+20