




304+60

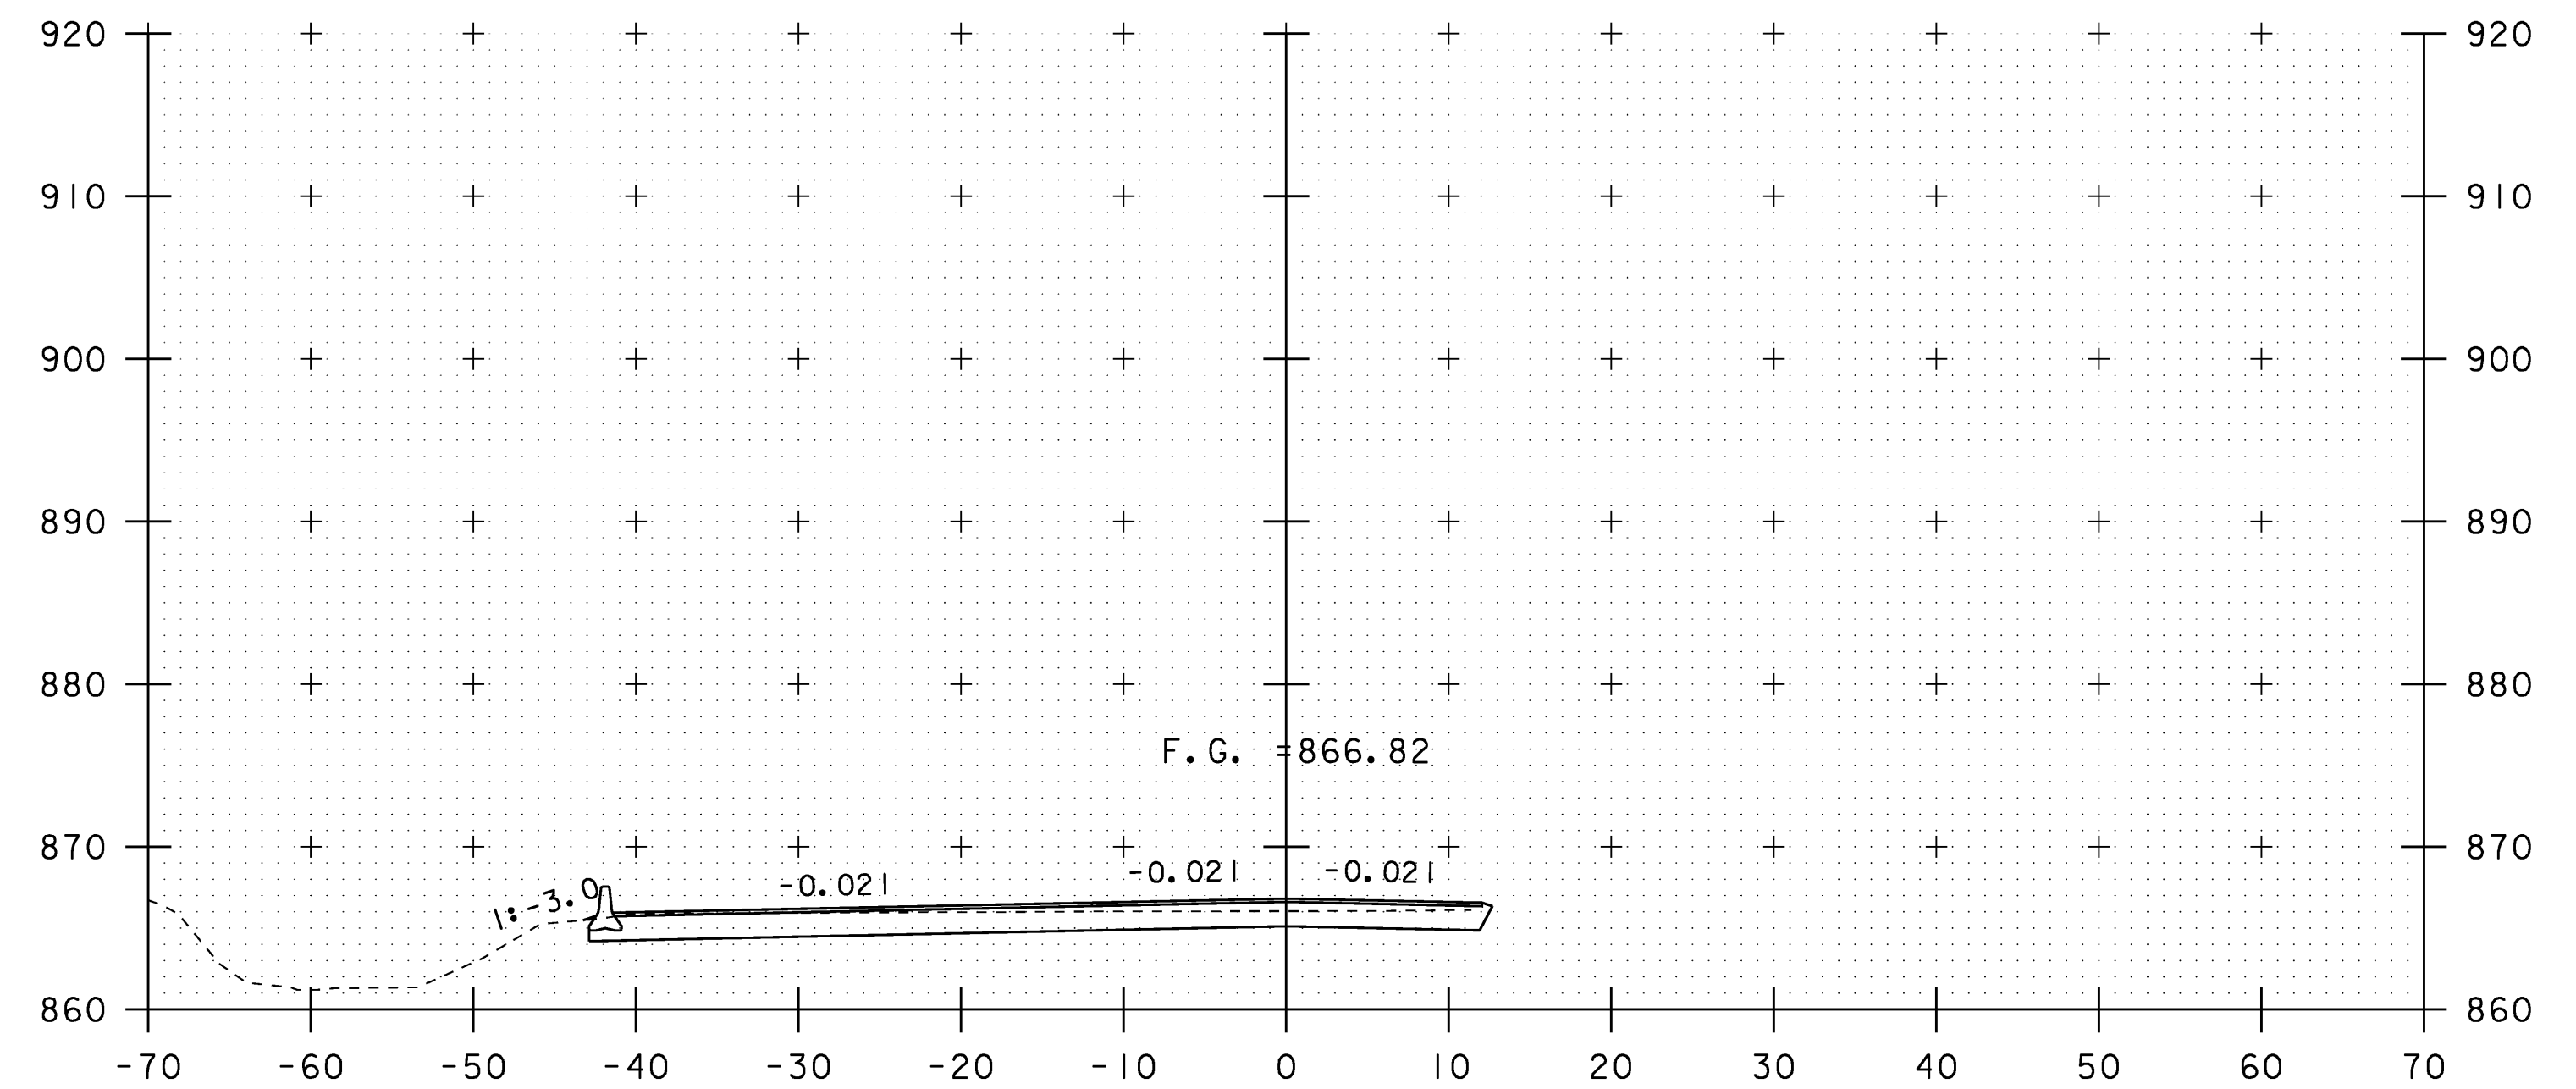


305+00

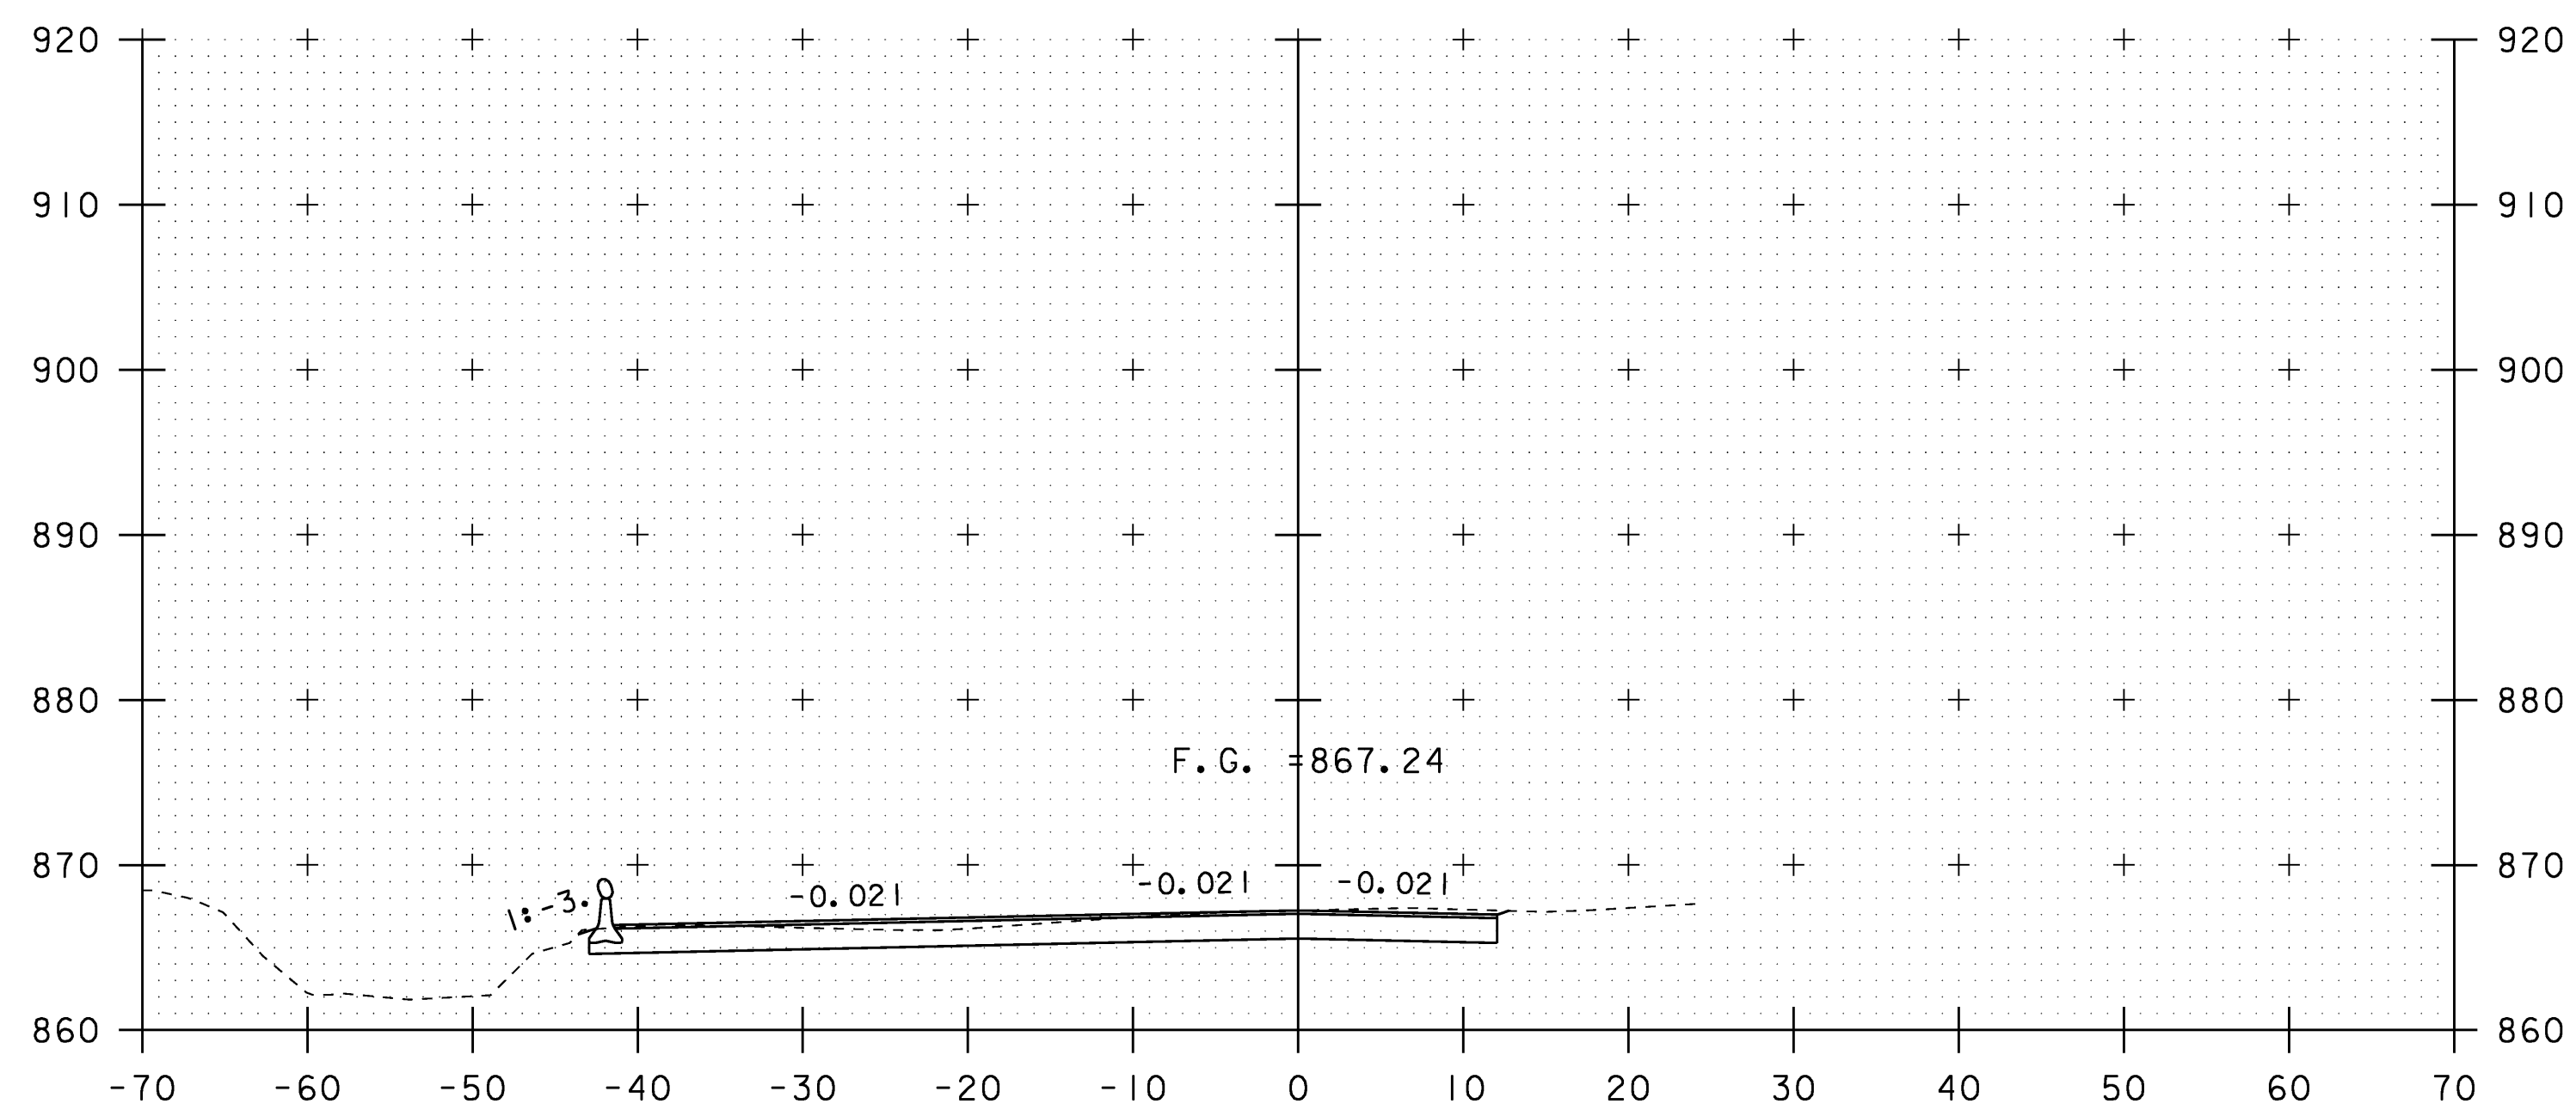

304+40

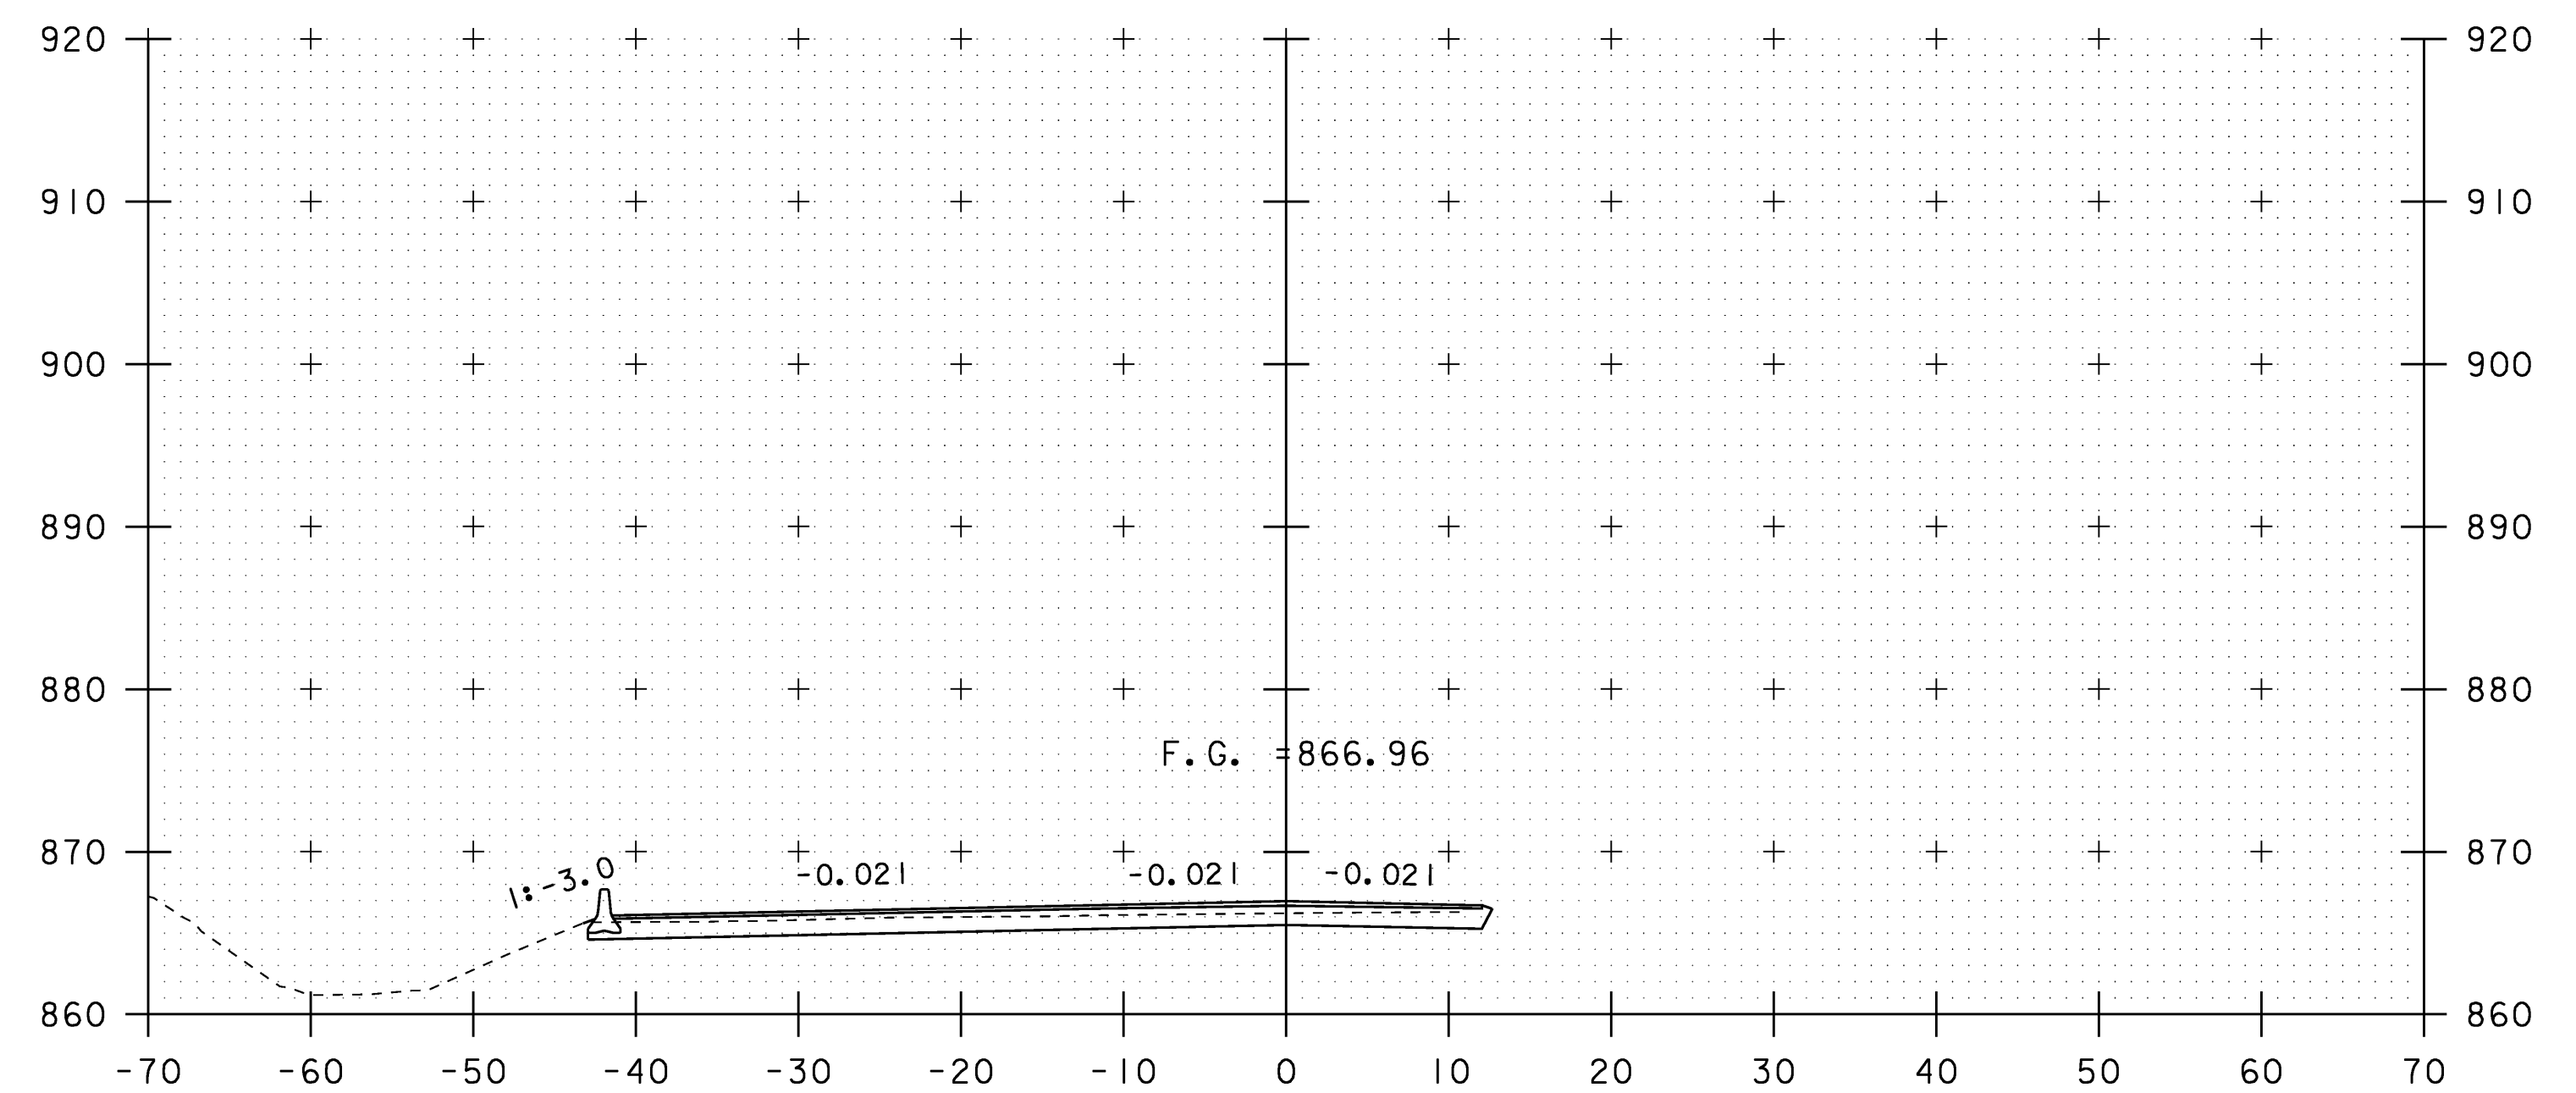

304+80

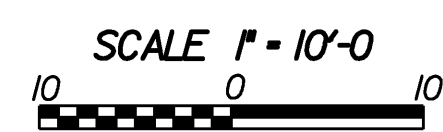

DETOUR CROSS SECTIONS

PROJECT NAME: WILLIAMSTOWN

PROJECT NUMBER: BRS 0204(4)

FILE NAME: 83ell\Sr+uc+\sellxs.dgn

PROJECT LEADER: EVANS-MONGEON

DESIGNED BY: U. STANLEY

IPARM: sellde+xs8.l

PLOT DATE: 07-APR-2008

DRAWN BY: U. STANLEY

CHECKED BY: EVANS-MONGEON

SHEET 106 OF 108

STA. 304+40 TO STA. 305+00