



(4) PANEL PP1

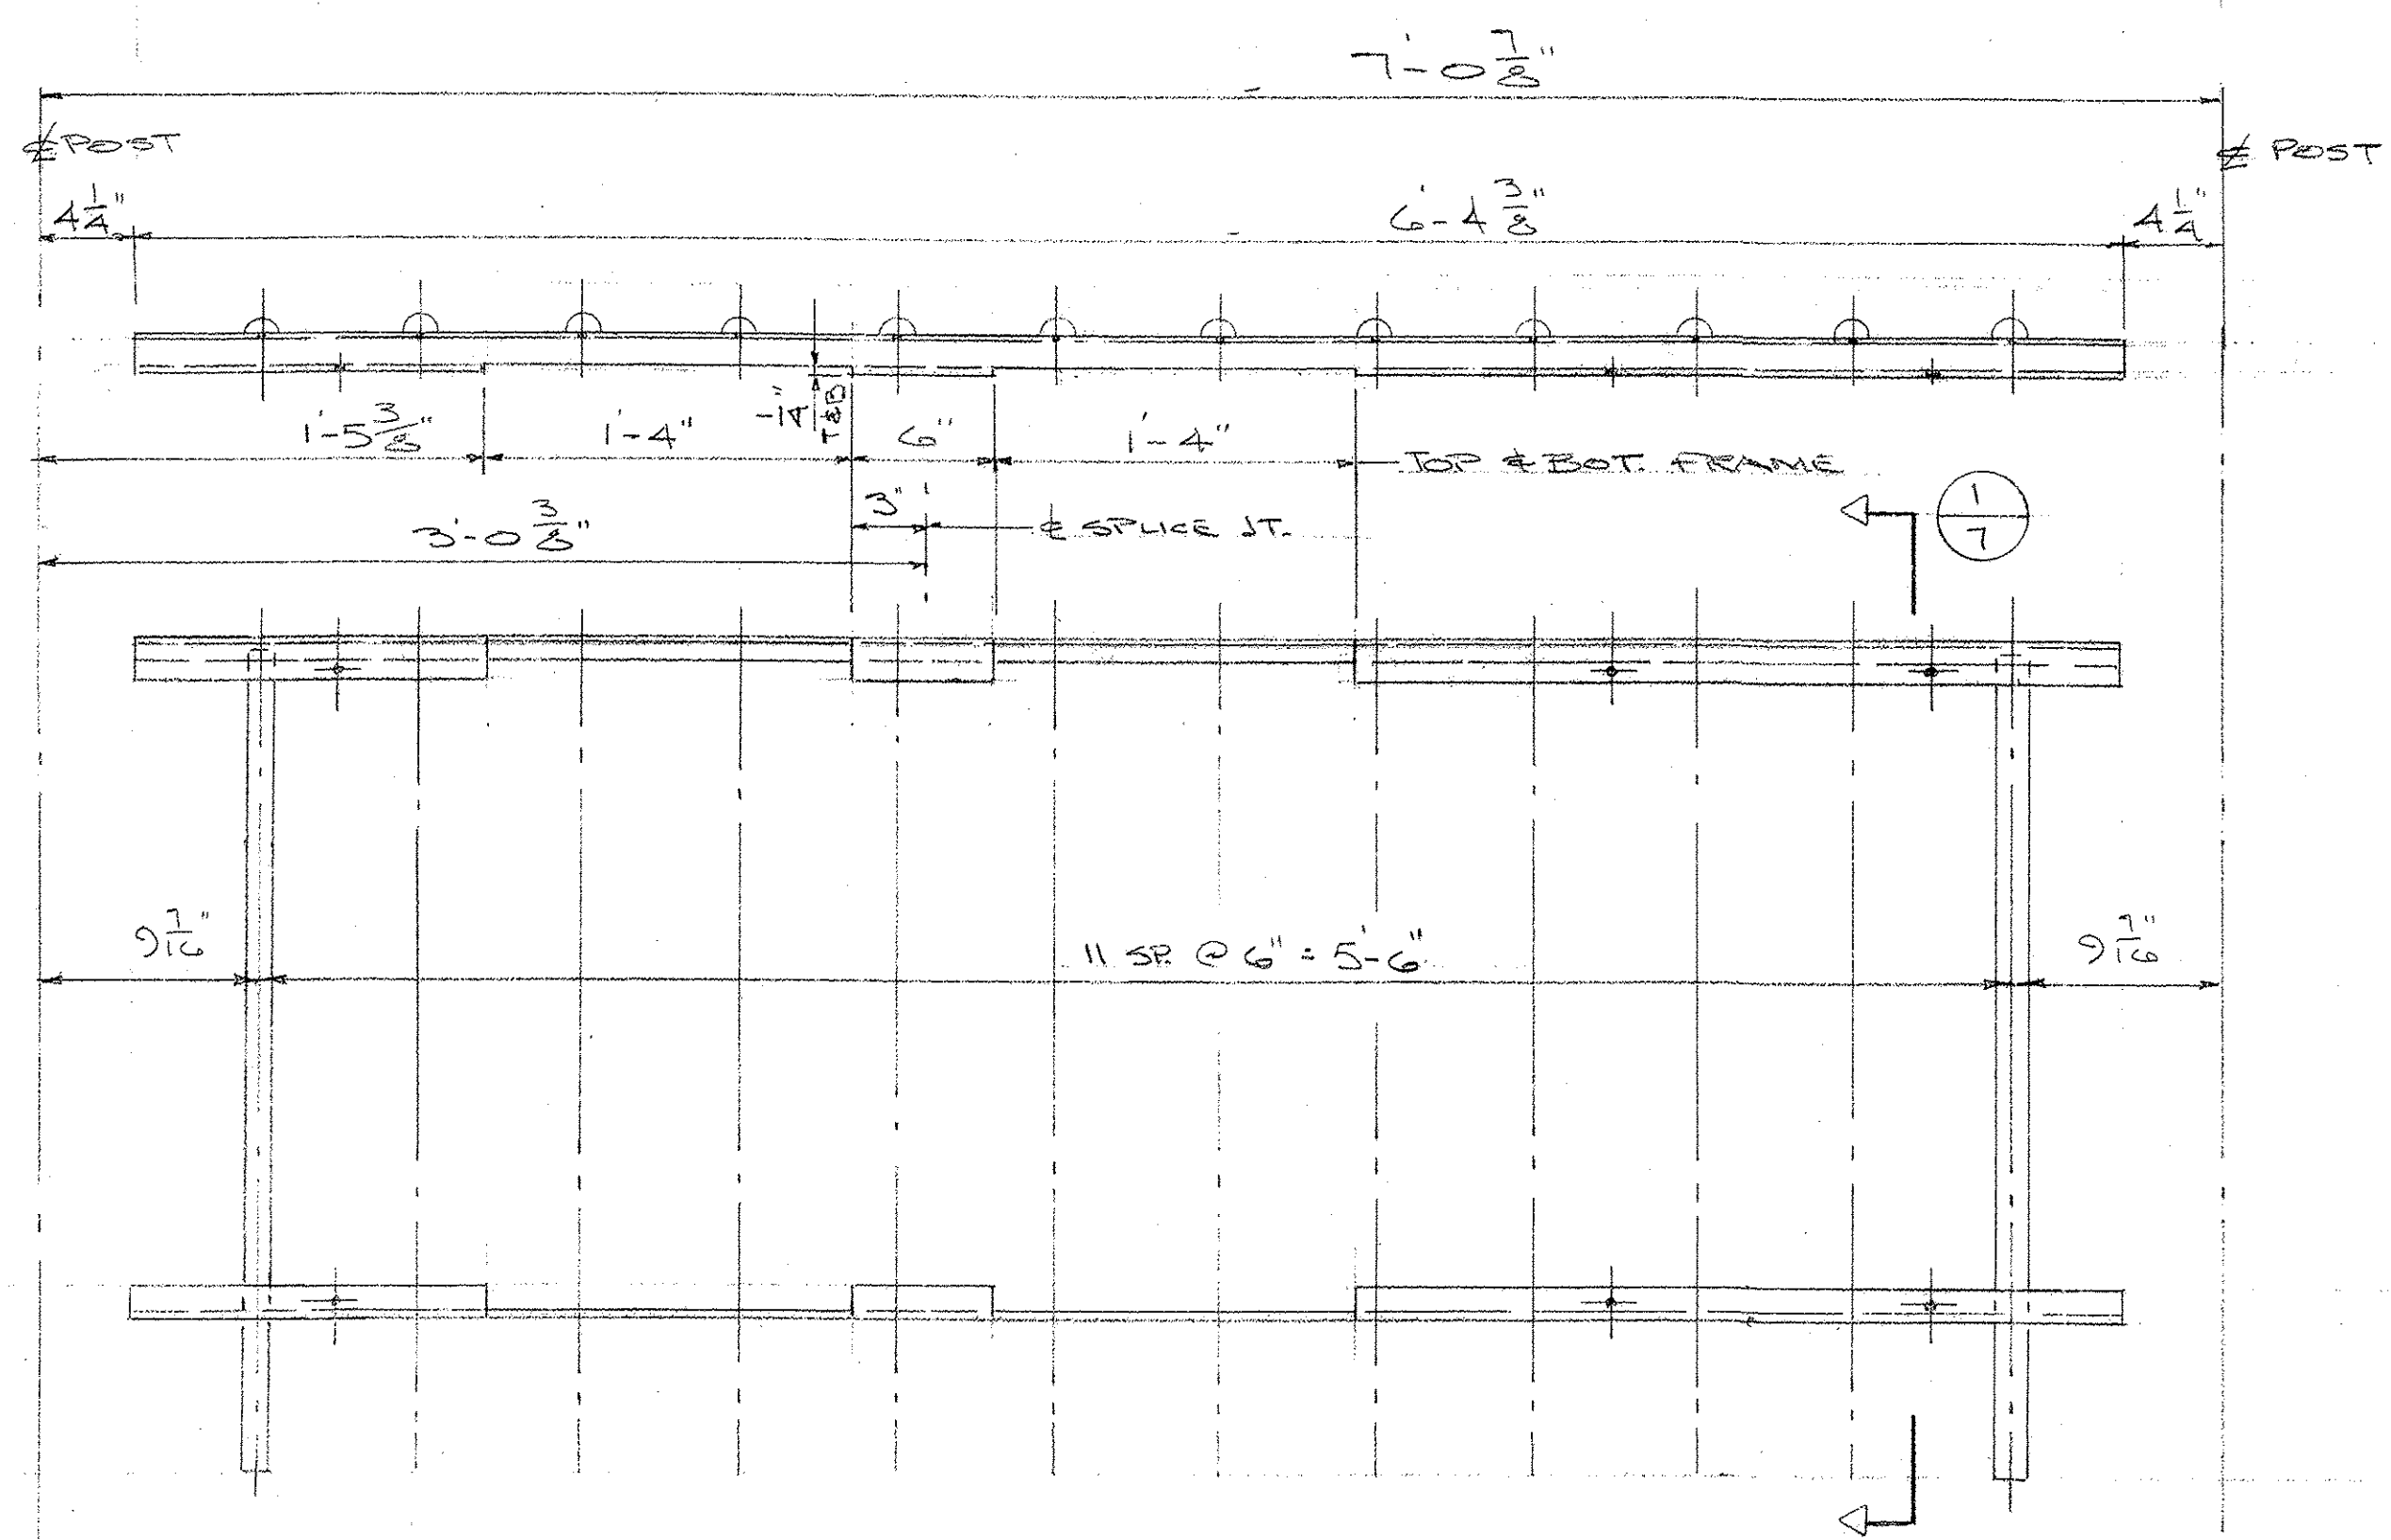

(1) PANEL PP2

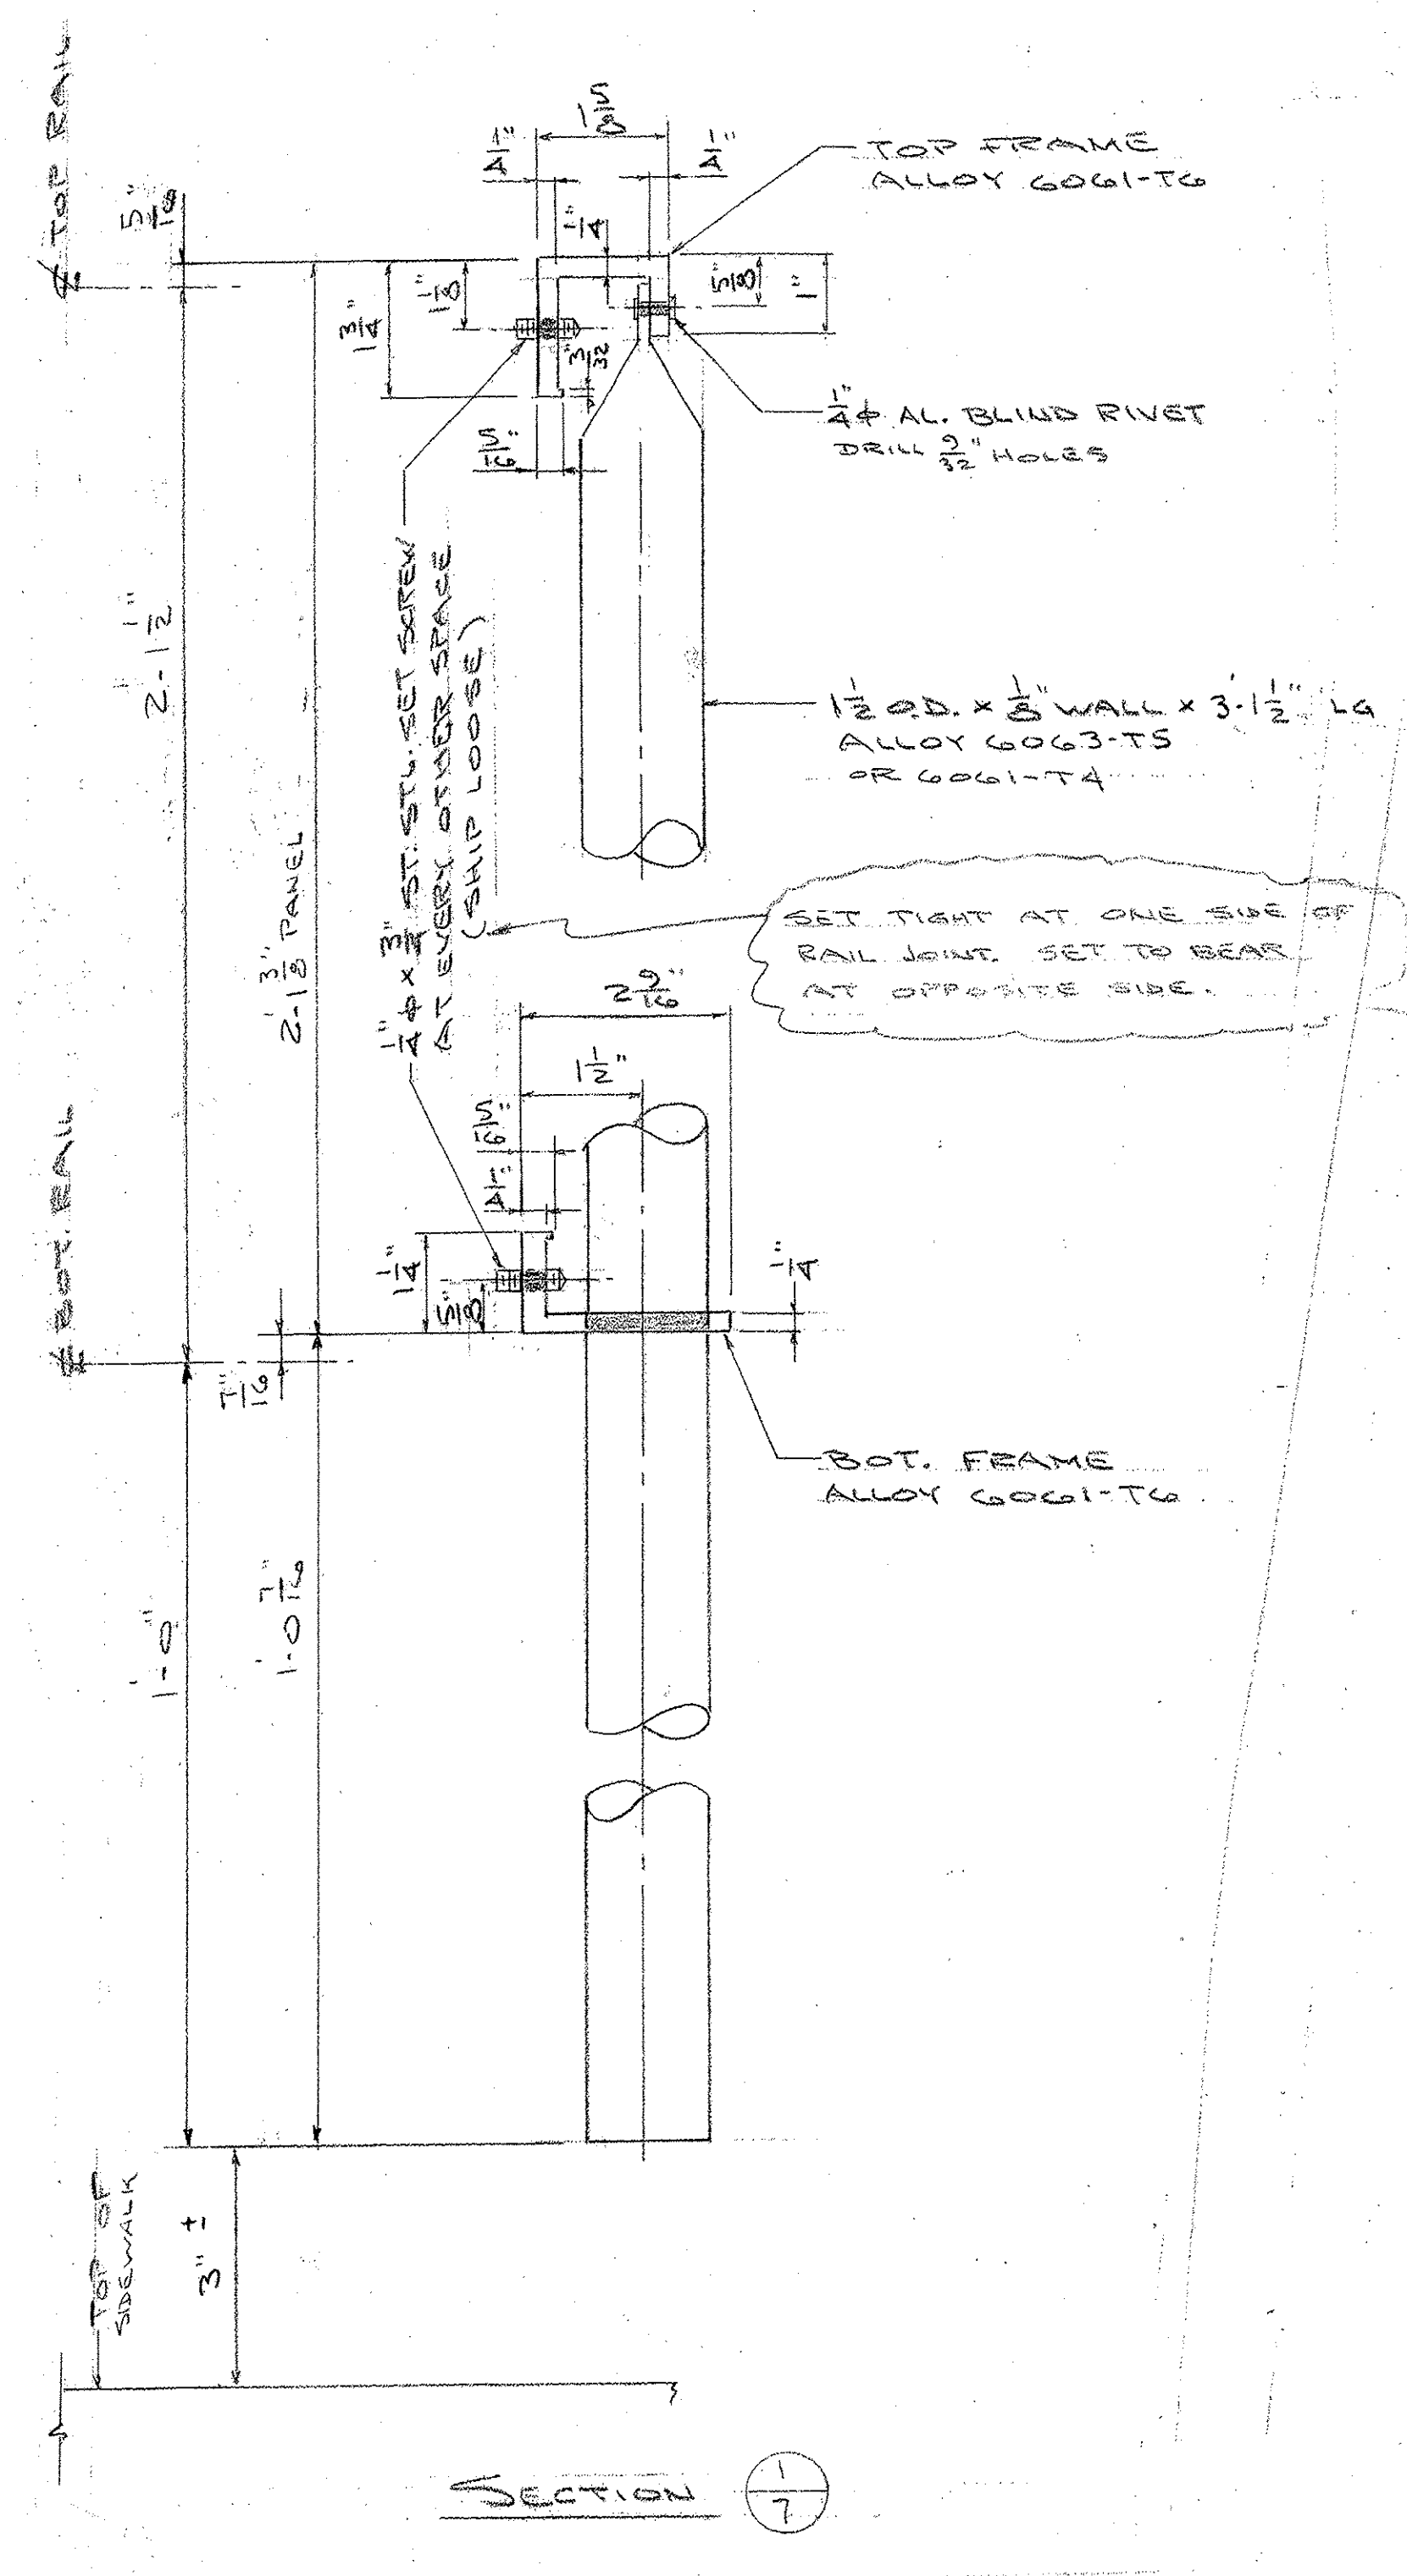

SECTION 1/7

RECEIVED CK'D BY <u>WBS</u> CK'D BY <u>mem</u> JUN 3 3 2009 BY _____ APPROVED <input checked="" type="checkbox"/> DATE 6-16-09		AUCIELLO IRON WORKS INC 560 MAIN ST. HUDSON, MA (978) 568-8382 VT AGENCY OF TRANSPORTATION WILLIAMSTOWN *BRS 0204 (4) ROUTE 64 OVER BROOK	
2 4/24/09 FOR FABRICATION 1 1-28-09 FOR APPROVAL		AL. BRIDGE & APPROACH RAILING SURFACE PREP: NONE FINISH: MILL FINISH FOR F.R. LAFAYETTE, INC. DR: <u>WBS</u> 01-19-09 DWG. NO. <u>BR-2950</u> CHK: <u>WBS</u> 1-22-09 JOB NO. <u>RS1005-1001</u> SHEET 8 OF 8	