



# TYPICAL SECTIONS & DESIGN DATA

ITEM 406.25 BITUMINOUS CONCRETE PAVEMENT  
 LEVELING COURSE, TYPE III OR IV (24' WIDE @ 218 TON/MI.)  
 AS DIRECTED BY THE ENGINEER  
 1 1/2" WEARING COURSE, TYPE III

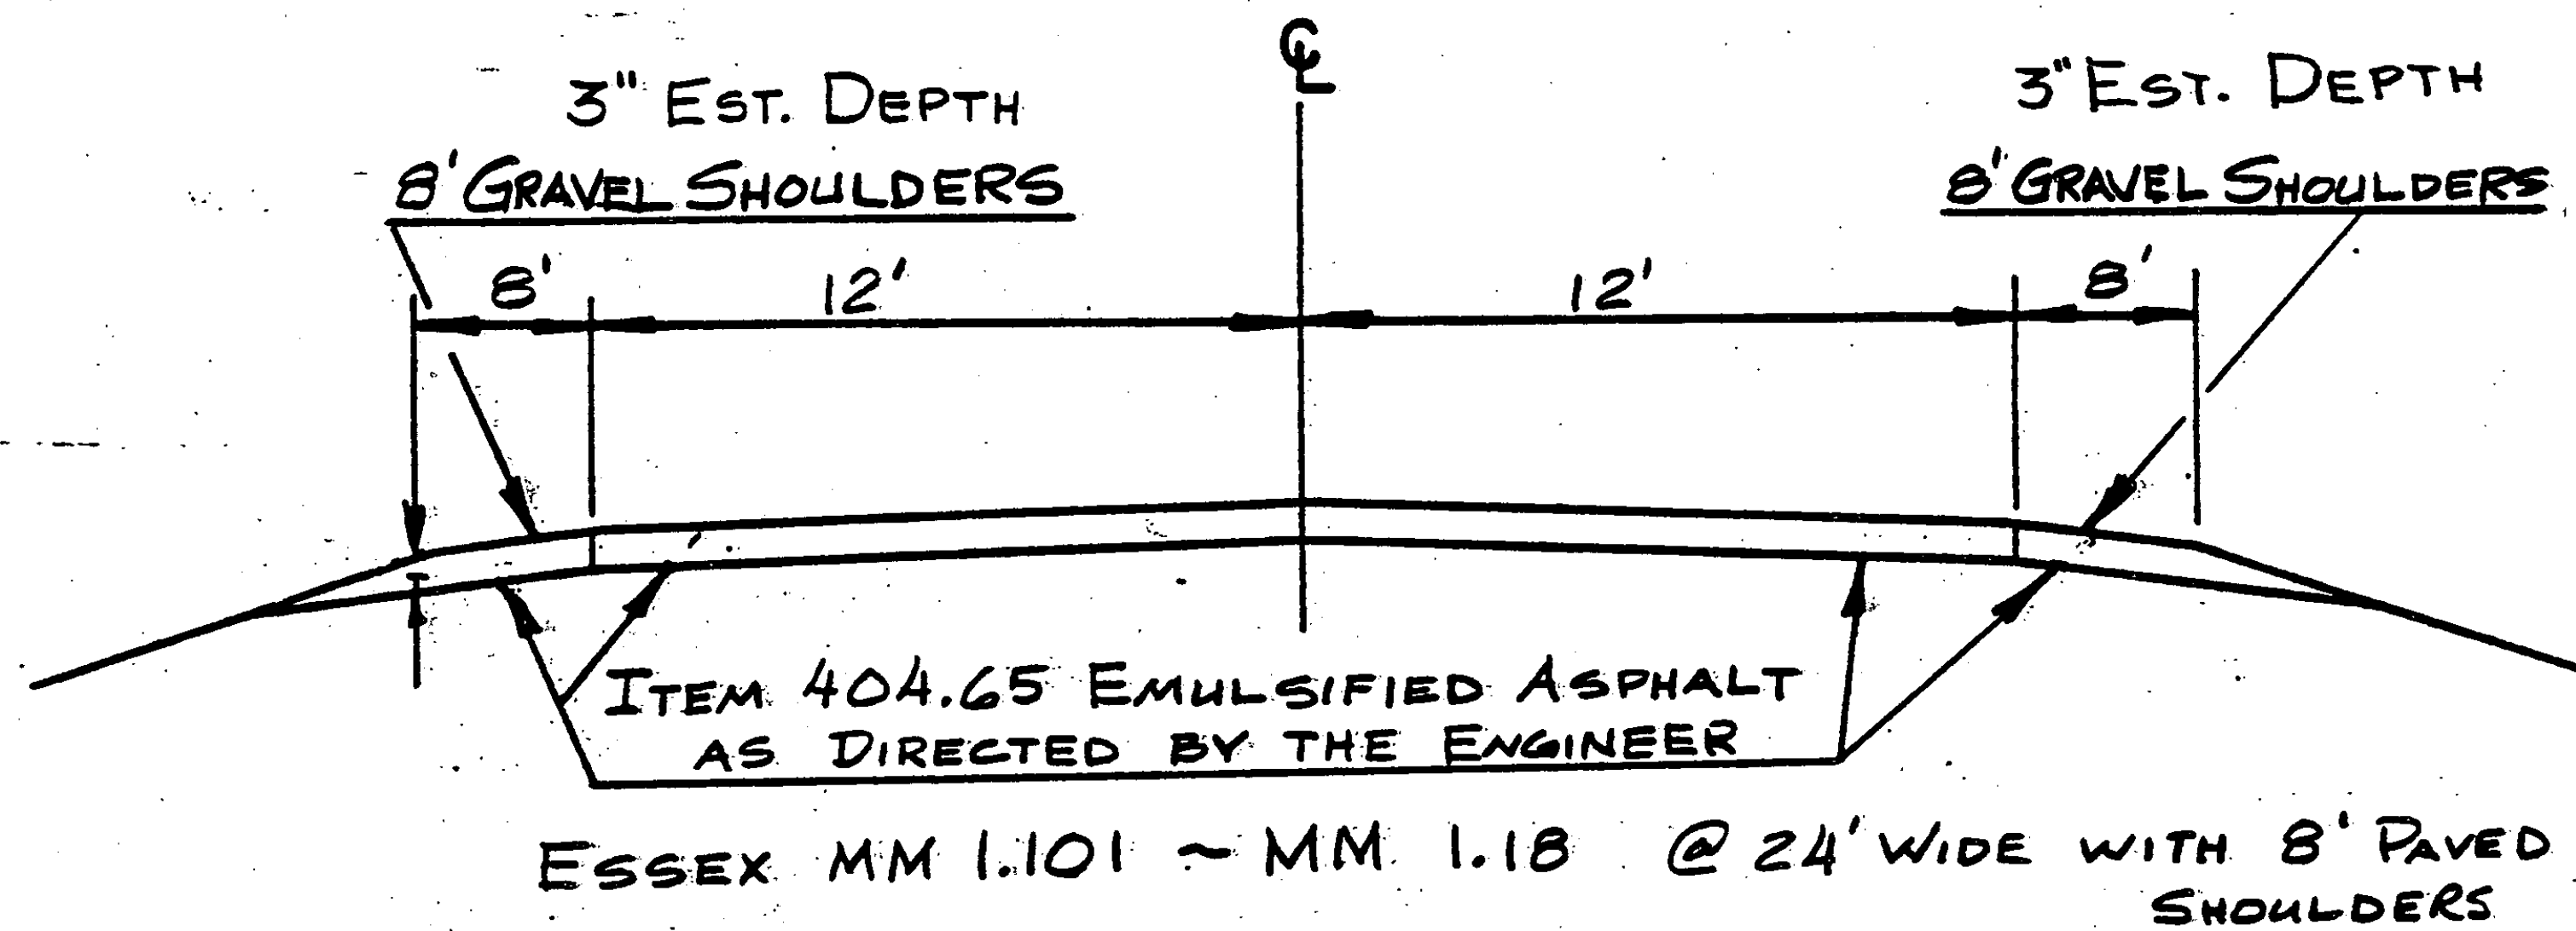

ITEM 406.25 BITUMINOUS CONCRETE PAVEMENT  
 LEVELING COURSE, TYPE III OR IV (30' WIDE @ 273 TON/MI.)  
 AS DIRECTED BY THE ENGINEER  
 1 1/2" WEARING COURSE, TYPE III

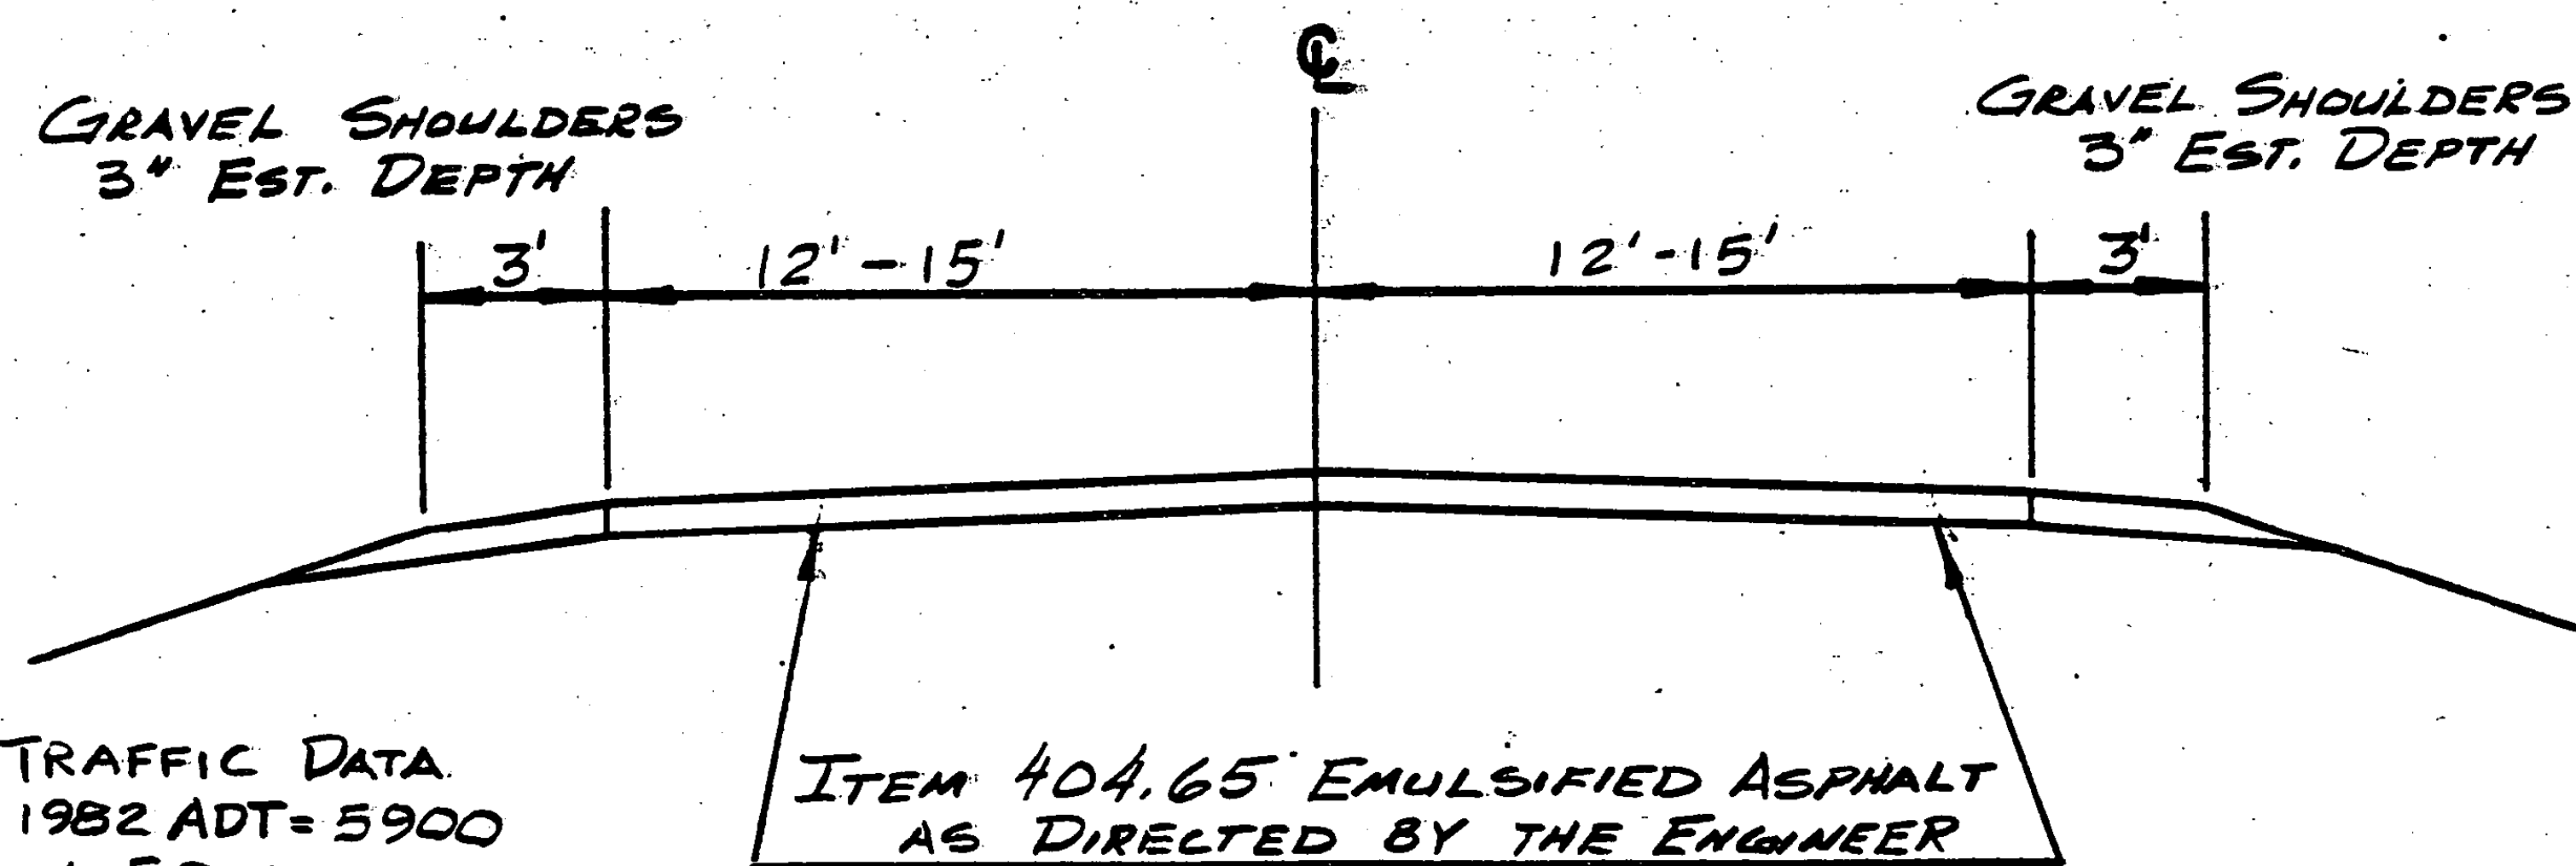

TRAFFIC DATA  
 1982 ADT = 5900  
 V = 50 MPH

ESSEX MM 1.18 ~ MM 3.517 @ 24' WIDE  
 COLCHESTER MM 0.00 ~ MM 2.13 @ 24' WIDE  
 COLCHESTER MM 2.13 ~ MM 2.20 @ TAPER 24'-30' WIDE  
 COLCHESTER MM 2.20 ~ MM 2.431 @ 30' WIDE

PROJECT ESSEX - COLCHESTER

NO. HMA 2450  
 SHEET 3 OF 12