
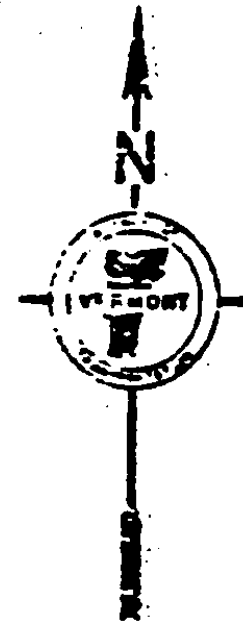


# PROJECT DESCRIPTION AND LOCATION

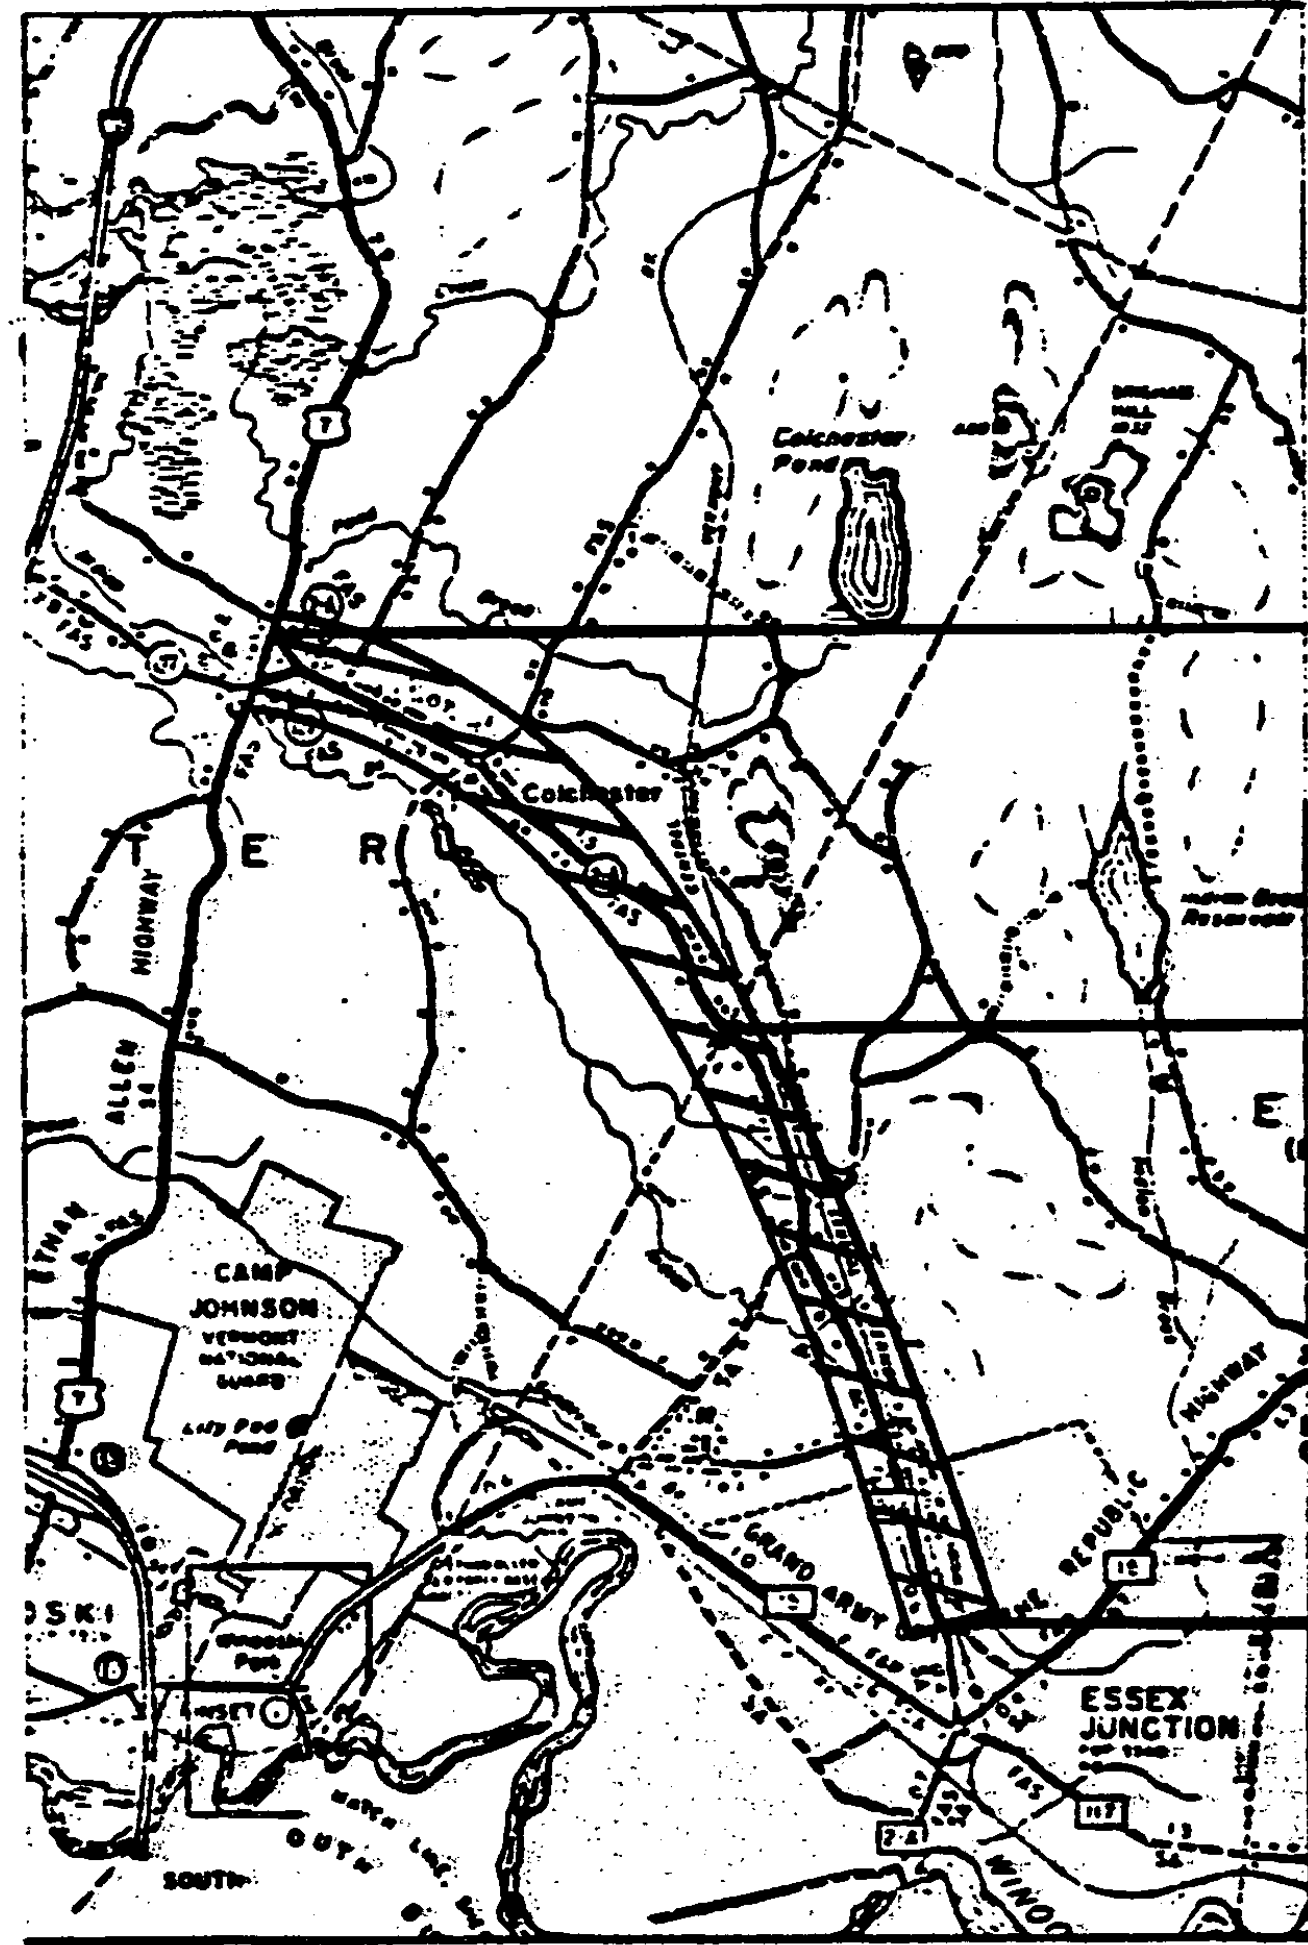

END PROJECT MM 2.431  
COLCHESTER

T.L. COLCHESTER MM 0.00  
ESSEX MM 3.517

BEGIN PROJECT MM 1.101  
VILLAGE OF ESSEX JUNCTION

BEGINNING ON VT. ROUTE 2-A IN THE VILLAGE OF  
ESSEX JUNCTION, 2.416 MILES SOUTHERLY OF THE  
COLCHESTER - ESSEX TOWN LINE, AT MM 1.101 AND  
EXTENDING NORTHERLY 4.847 MILES TO COLCHESTER  
MM 2.431 AT THE INTERSECTION OF VT. ROUTE 2-A  
WITH U.S. ROUTE 7.

LENGTH OF PROJECT: 25592 FT.  
4.847 mi.

PROJECT ESSEX - COLCHESTER

NO. HMA 2450

SHEET 2 OF 12 SHEETS