


TYPICAL SECTIONS & DESIGN DATA


ITEM 406.25 BITUMINOUS CONCRETE PAVEMENT
 LEVELING COURSE, TYPE III OR IV (24' WIDE @ 218 Ton/mi.)
 AS DIRECTED BY THE ENGINEER
 1 1/2" WEARING COURSE, TYPE III

TAPER OUTSIDE SHOULDER
 EDGE TO 1/2" TYP.

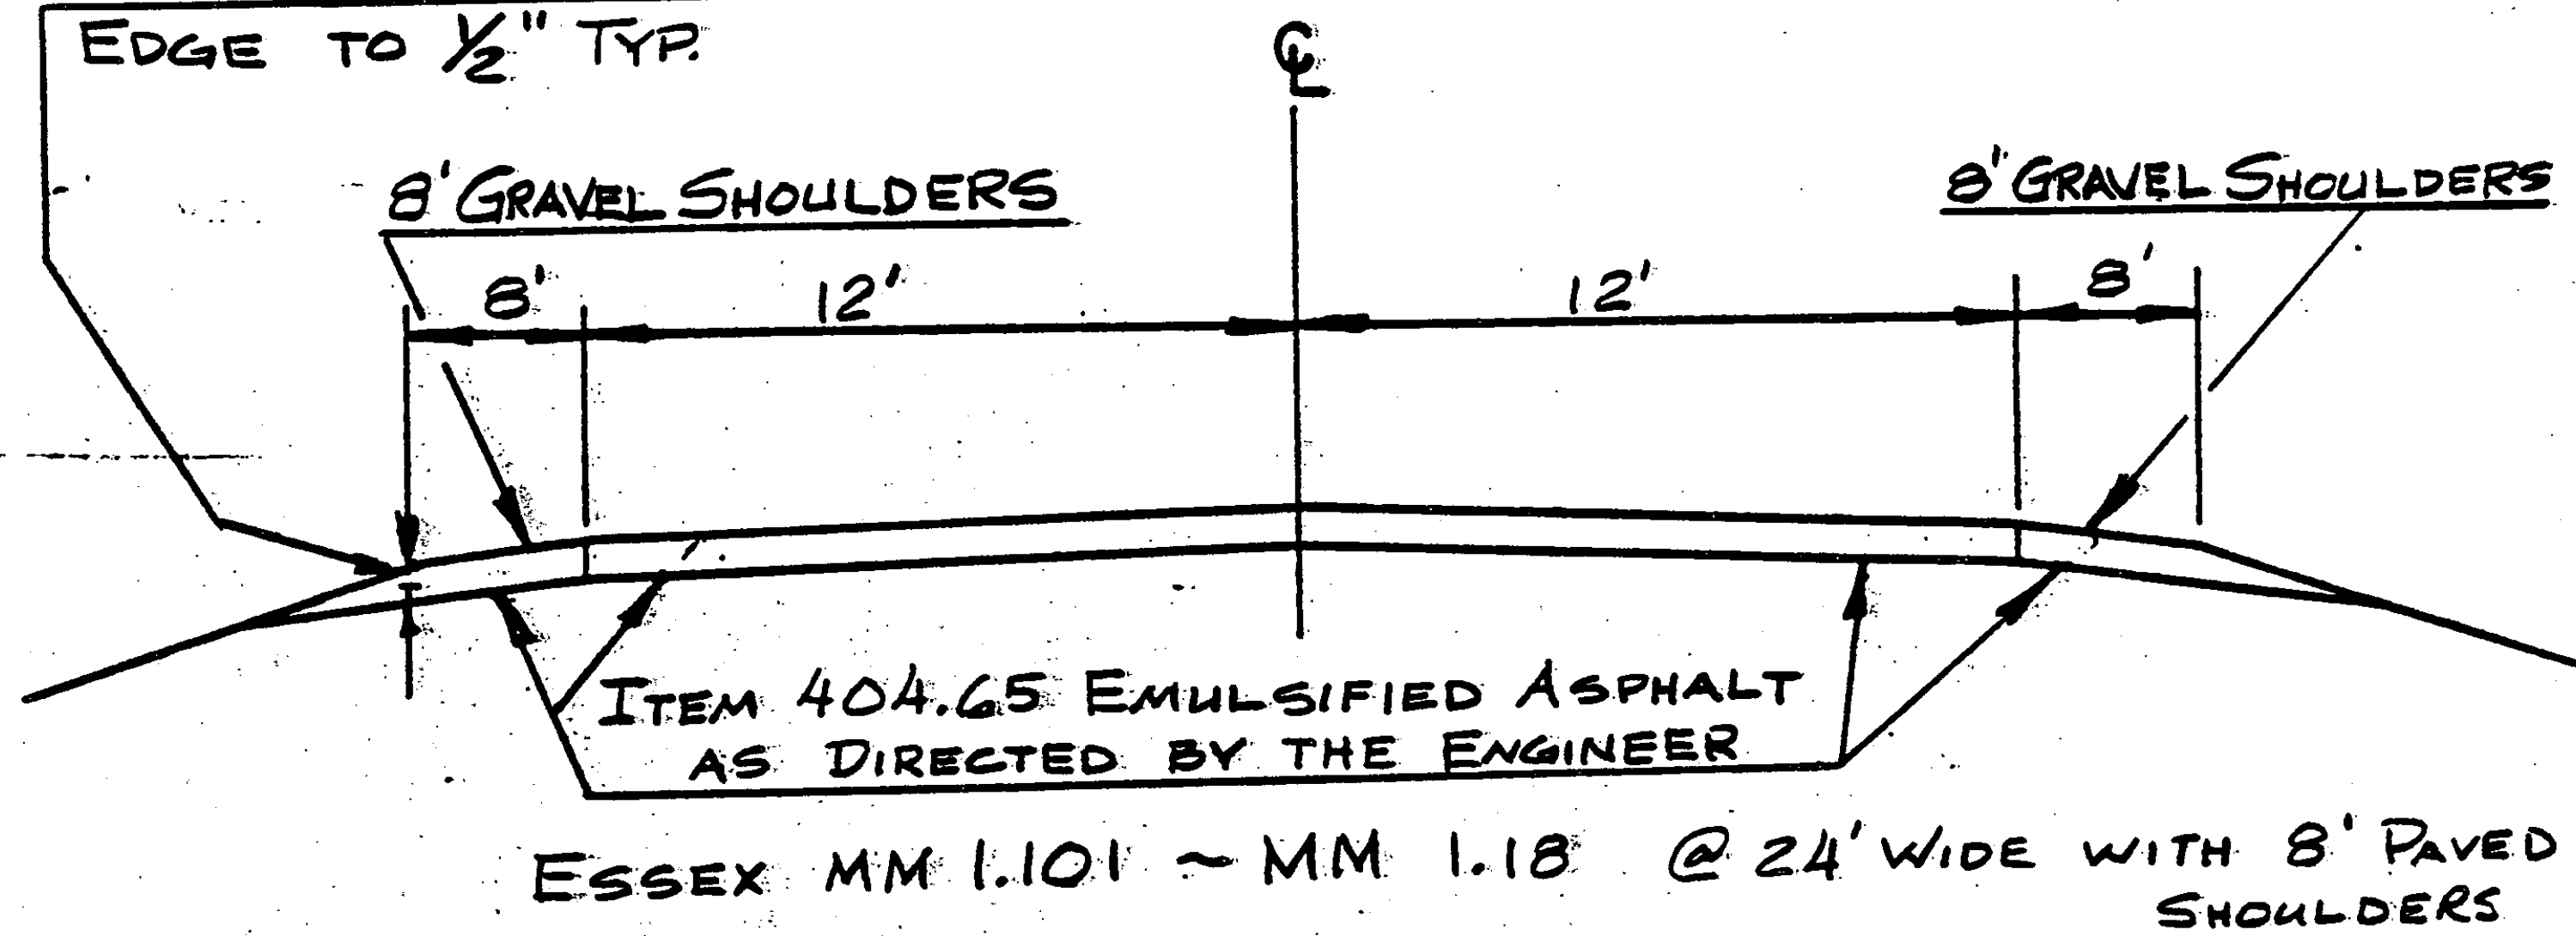

ESSEX MM 1.101 ~ MM 1.18 @ 24' WIDE WITH 8' PAVED SHOULDERS

ITEM 406.25 BITUMINOUS CONCRETE PAVEMENT
 LEVELING COURSE, TYPE III OR IV (30' WIDE @ 273 Ton/mi.)
 AS DIRECTED BY THE ENGINEER
 1 1/2" WEARING COURSE, TYPE III

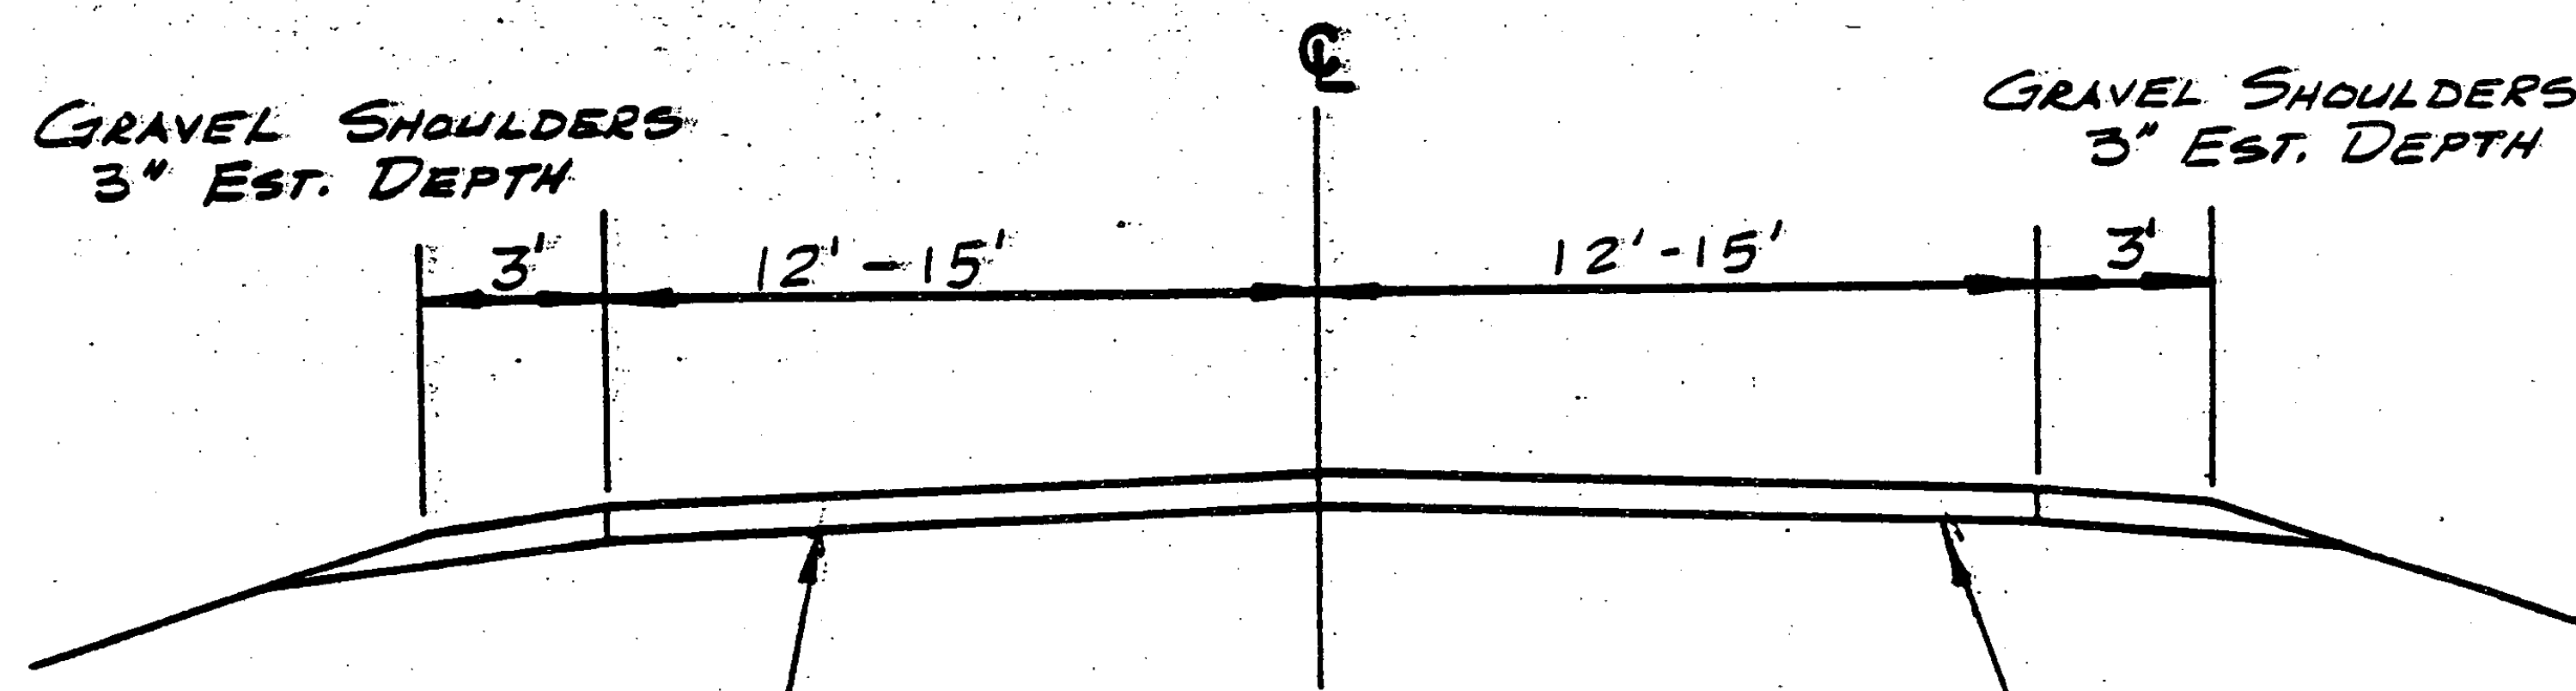

TRAFFIC DATA
 1982 ADT=5900
 V=50 MPH

ITEM 404.65 EMULSIFIED ASPHALT
 AS DIRECTED BY THE ENGINEER

ESSEX MM 1.18 ~ MM 3.517 @ 24' WIDE
 COLCHESTER MM 0.00 ~ MM 2.13 @ 24' WIDE
 COLCHESTER MM 2.13 ~ MM 2.20 @ TAPER 24'-30' WIDE
 COLCHESTER MM 2.20 ~ MM 2.431 @ 30' WIDE

PROJECT ESSEX - COLCHESTER

NO. HMA 2450
 SHEET 3 OF 12