


# PROJECT DESCRIPTION AND LOCATION

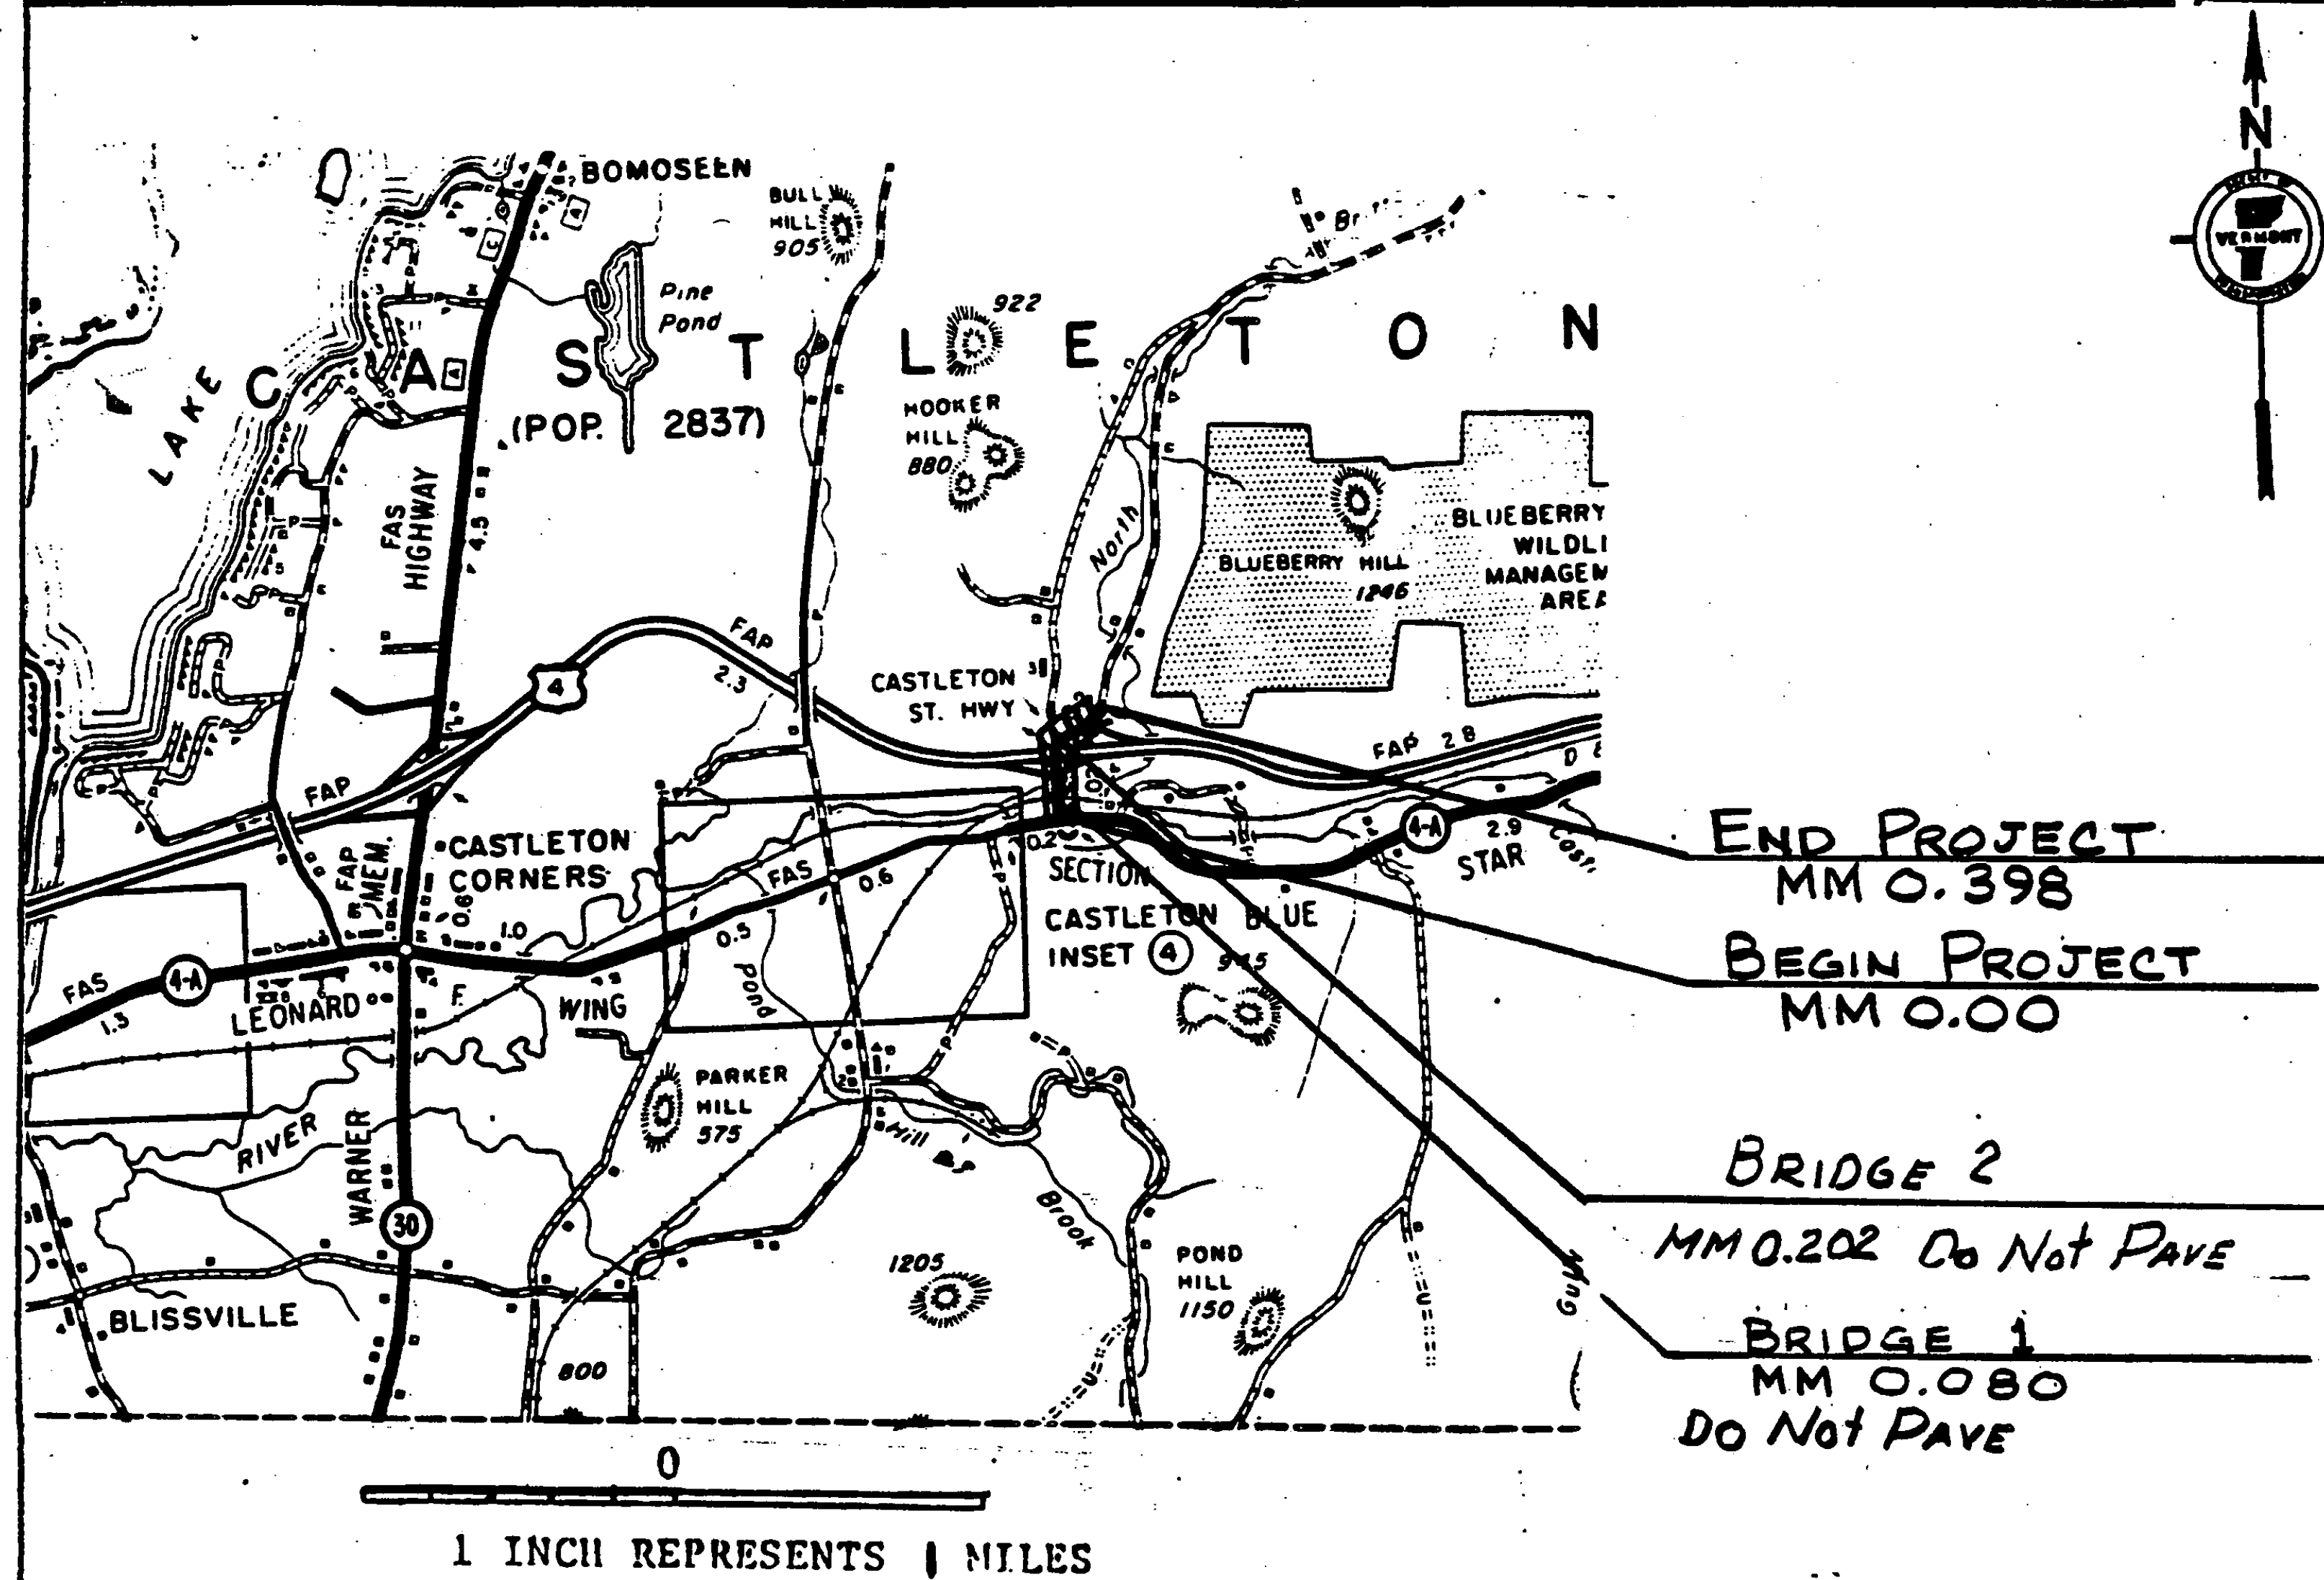

BEGINNING AT THE JUNCTION OF VT. RTE. 4-A AND CASTLETON STATE HIGHWAY AND EXTENDING NORTHERLY 0.398 MILES.

LENGTH OF PROJECT: 0.398 MILES  
2104 FEET