


# TYPICAL SECTIONS & DESIGN DATA

ITEM 406.25 BITUMINOUS CONCRETE PAVEMENT  
LEVELING COURSE, TYPE III OR IV (22' WIDE @ 150  $\frac{\text{TONS}}{\text{MT.}}$ )  
AS DIRECTED BY THE ENGINEER  
WEARING COURSE,  $\frac{3}{4}$ " TYPE IV

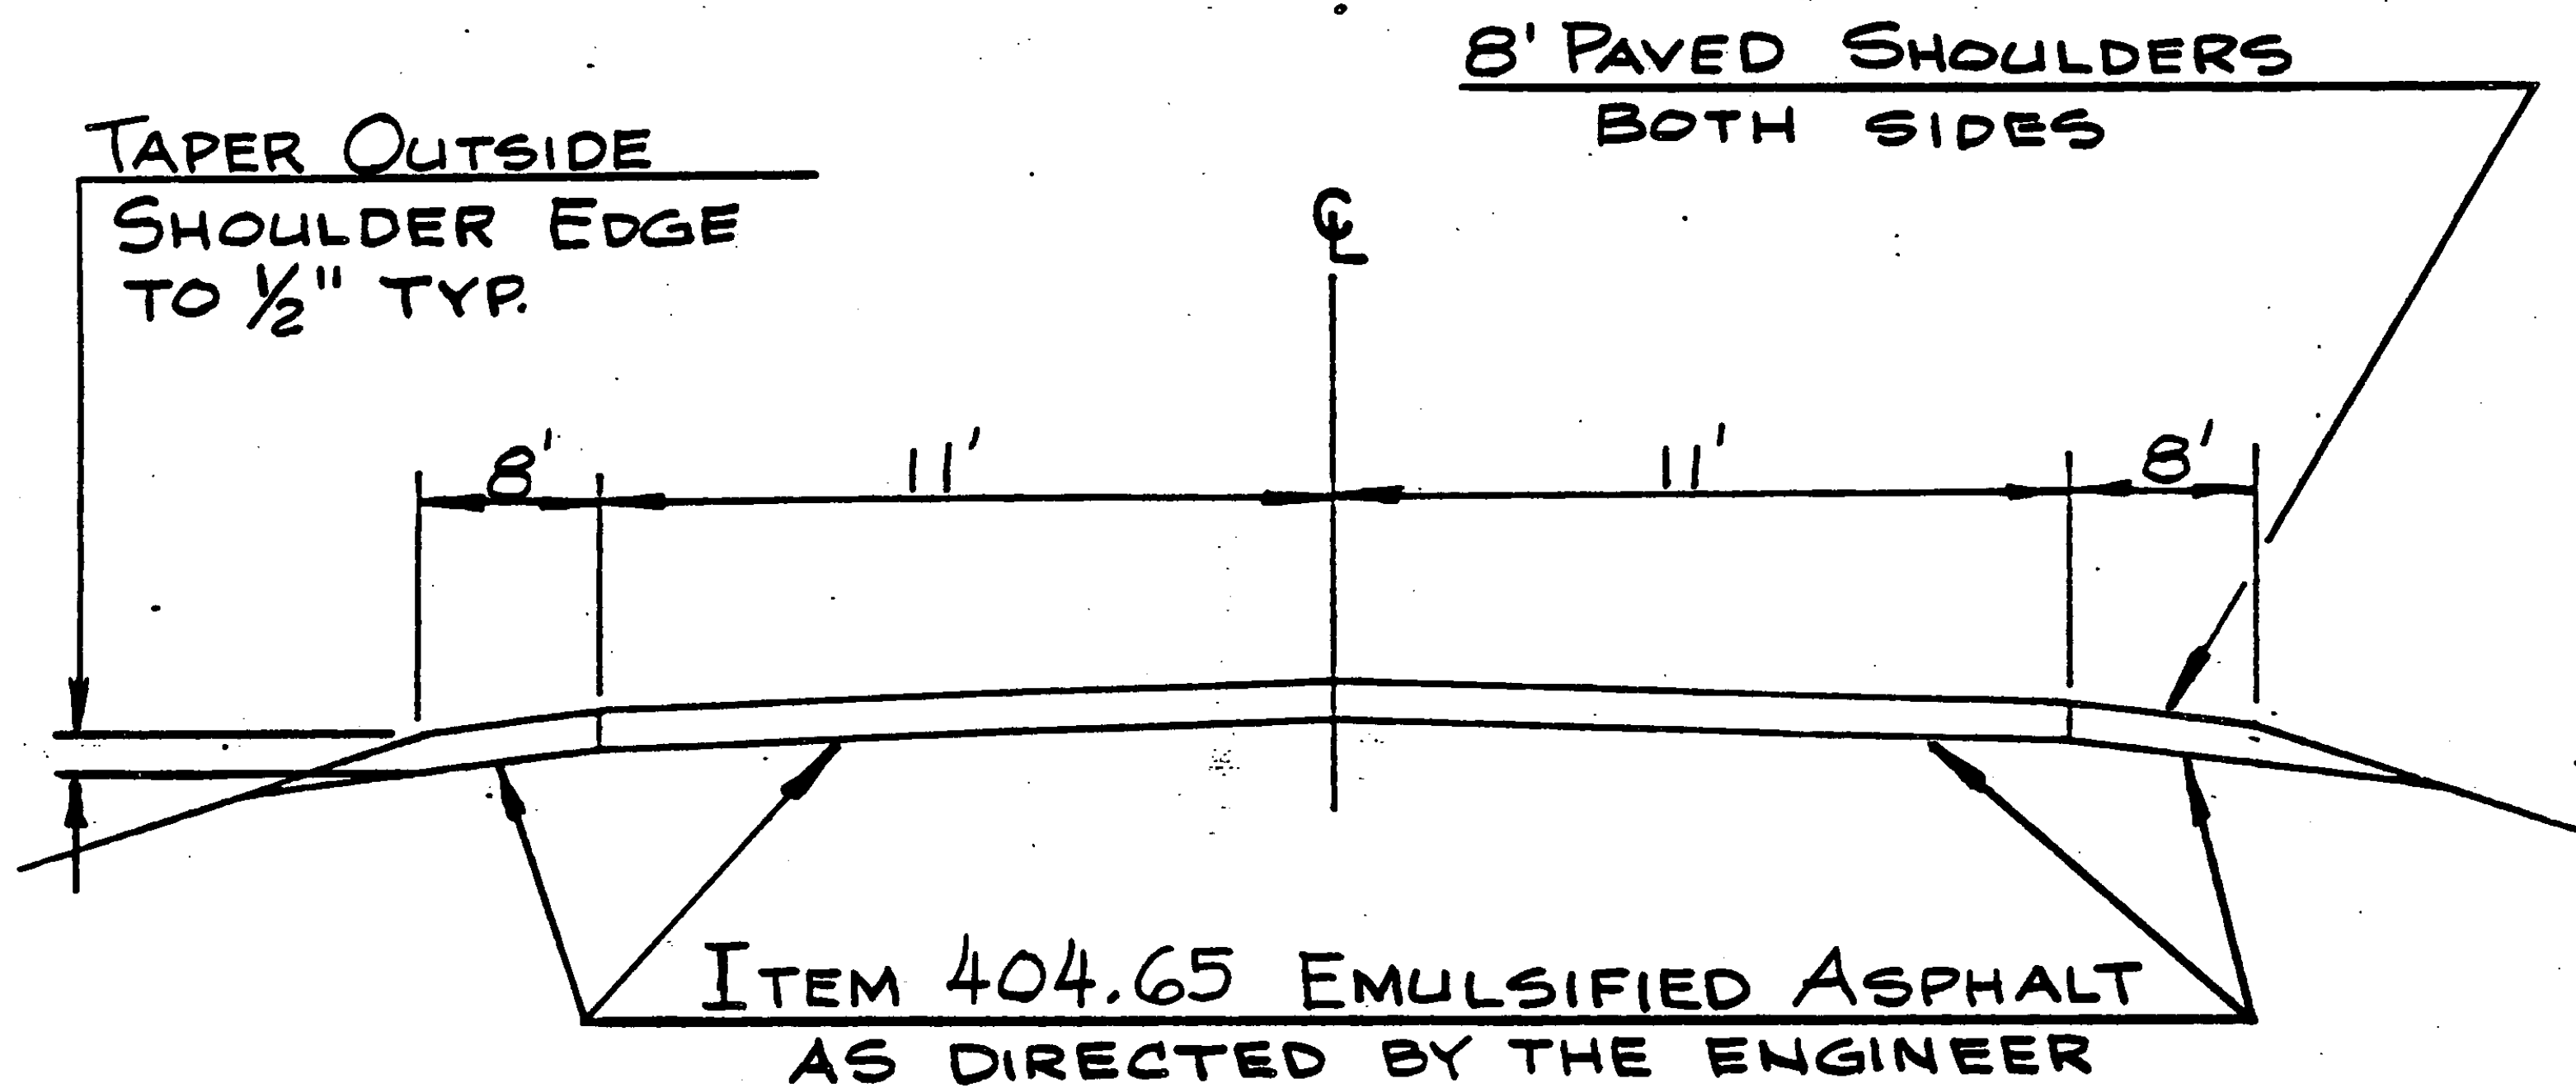

CASTLETON MM 0.00 - MM 0.398

TRAFFIC DATA  
1982 ADT = 1630  
V = 50 MPH