


Vt. 4A

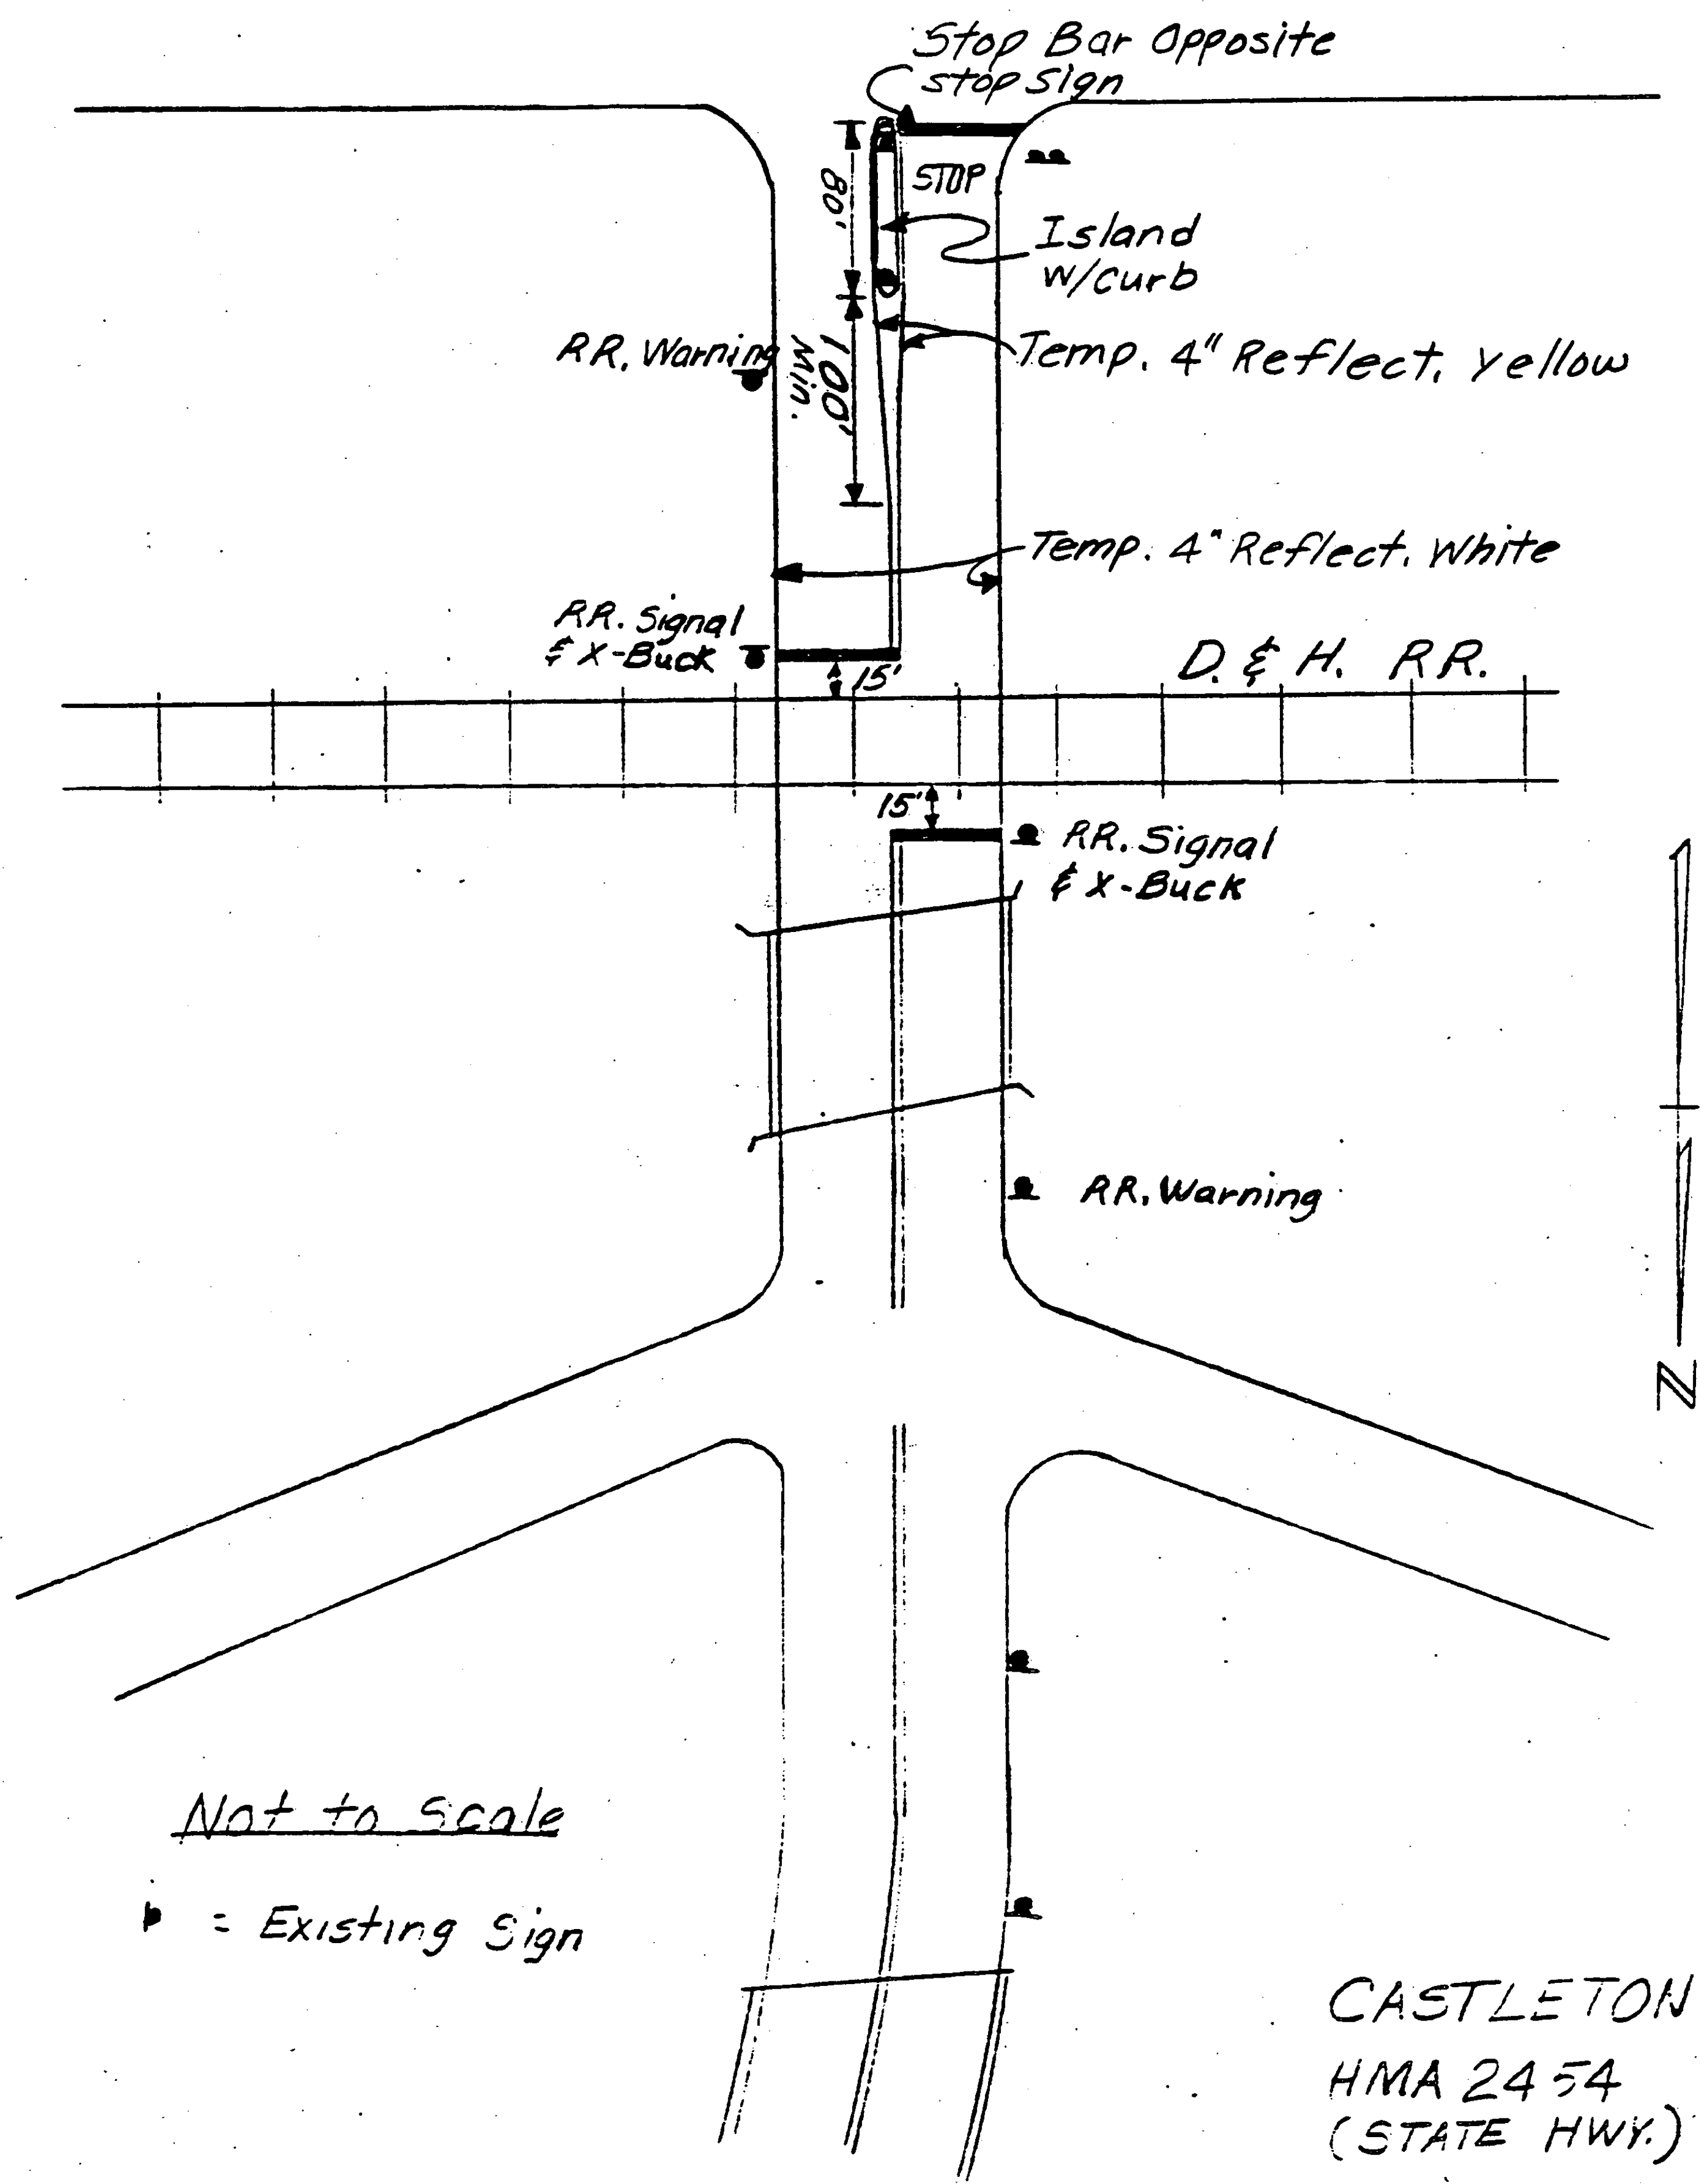

Not to scale

• = Existing Sign

CASTLETON  
HMA 2454  
(STATE HWY.)

Sheet 12 of 16