
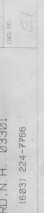
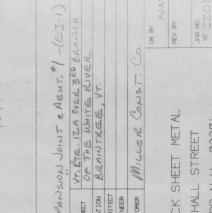
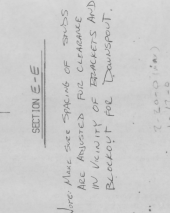


FIELD ADJUST CHART	
TEMP.	DIM. "A"
0°F	1 7/8"
15°F	1 3/4"
30°F	1 5/8"
45°F	1 1/2"
60°F	1 3/8"
75°F	1 1/4"
90°F	1 1/8"
105°F	1"

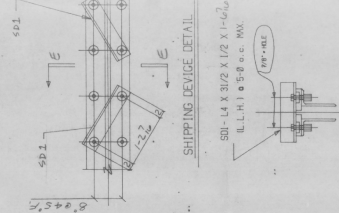

DATE SUB.	DATE APP.	DATE RECD.	LOCATION	PROJECT
			CONCORD, N. H.	MERRIMACK SHEET METAL
			119 HALL STREET	
			CONCORD, N. H.	03301
			TEL. (603) 224-7766	

2. IS THEORETICAL - PLAY
ON THE MIND (PEOPLES)