


# TYPICAL SECTIONS & DESIGN DATA

ITEM 406.25 BITUMINOUS CONCRETE PAVEMENT  
Leveling course, Type III or IV (327 Tons/Mile)  
AS DIRECTED BY THE ENGINEER  
3/4" Wearing course (+1/4") Type IV

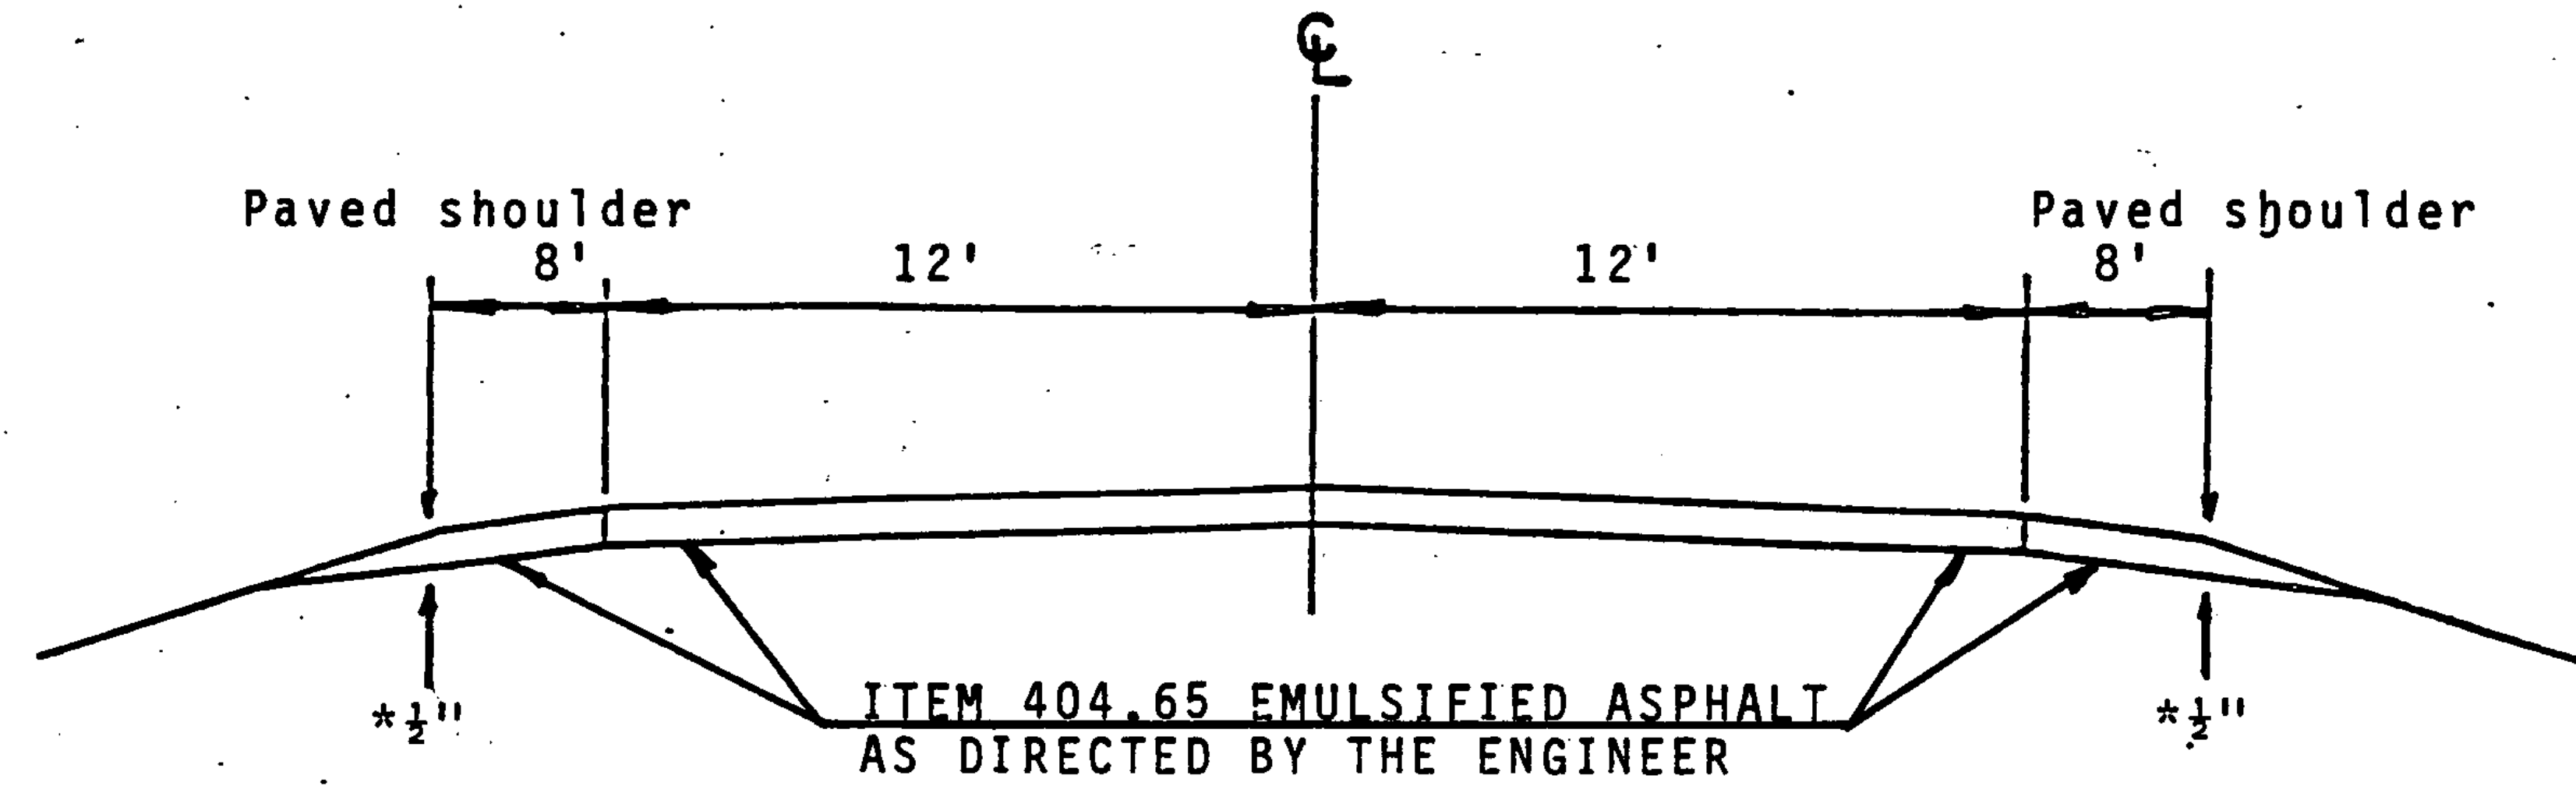

MM 1.315 - MM 3.700

TRAFFIC DATA  
1982 ADT = 2190  
V = 50 MPH

\*Shoulder to be tapered from full depth to 1/2"

PROJECT BERKSHIRE

NO. F 034-1(15)S  
SHEET 3 OF 11