


# PROJECT DESCRIPTION AND LOCATION

END PROJECT

WALLINGFORD  
MM 0.450

BEGIN PROJECT

Mt. Holly MM 1.626

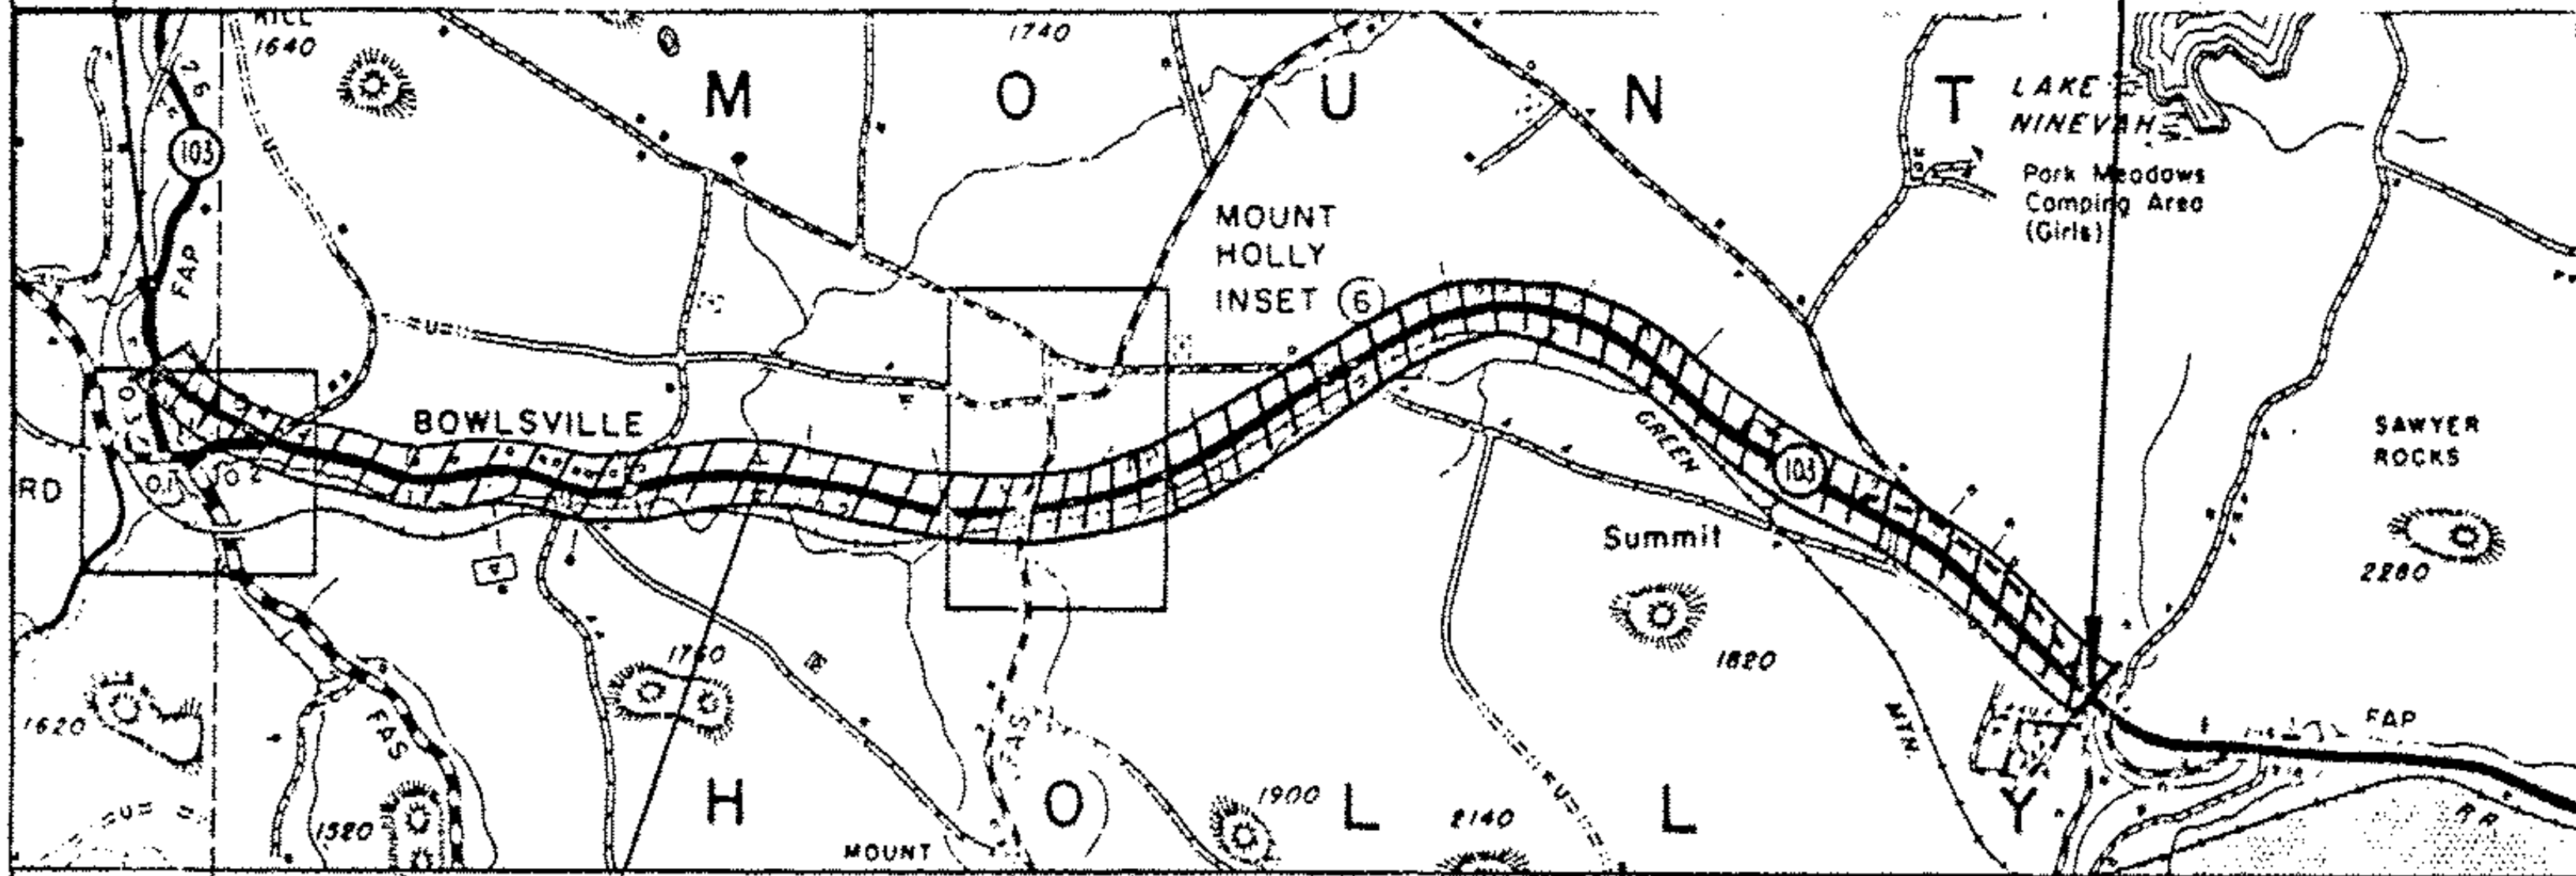

1977

BRIDGE No. 42 @ MM 6.026  
Do NOT PAVE

TRAFFIC DATA  
1982 ADT = 3260  
V = 50 MPH

WALLINGFORD MM 0.00  
Mt. Holly MM 7.683

Mt. Holly  
LUDLOW

BEGINNING ON VT. 103 IN THE TOWN OF MOUNT HOLLY, 1.626 MILES WESTERLY OF THE MT. HOLLY - LUDLOW TOWN LINE, THENCE CONTINUING WESTERLY ALONG VT. 103 6.51 MILES TO WALLINGFORD MM 0.450.

LENGTH OF PROJECT: 34357 FT.  
6.507 mi.