


# TYPICAL SECTIONS & DESIGN DATA

ITEM 406.25 BITUMINOUS CONCRETE PAVEMENT  
 LEVELING COURSE, TYPE III OR IV (24' WIDE @ 164  $\frac{\text{TON}}{\text{MI.}}$ )  
 AS DIRECTED BY THE ENGINEER  
 - 1" WEARING COURSE, TYPE III

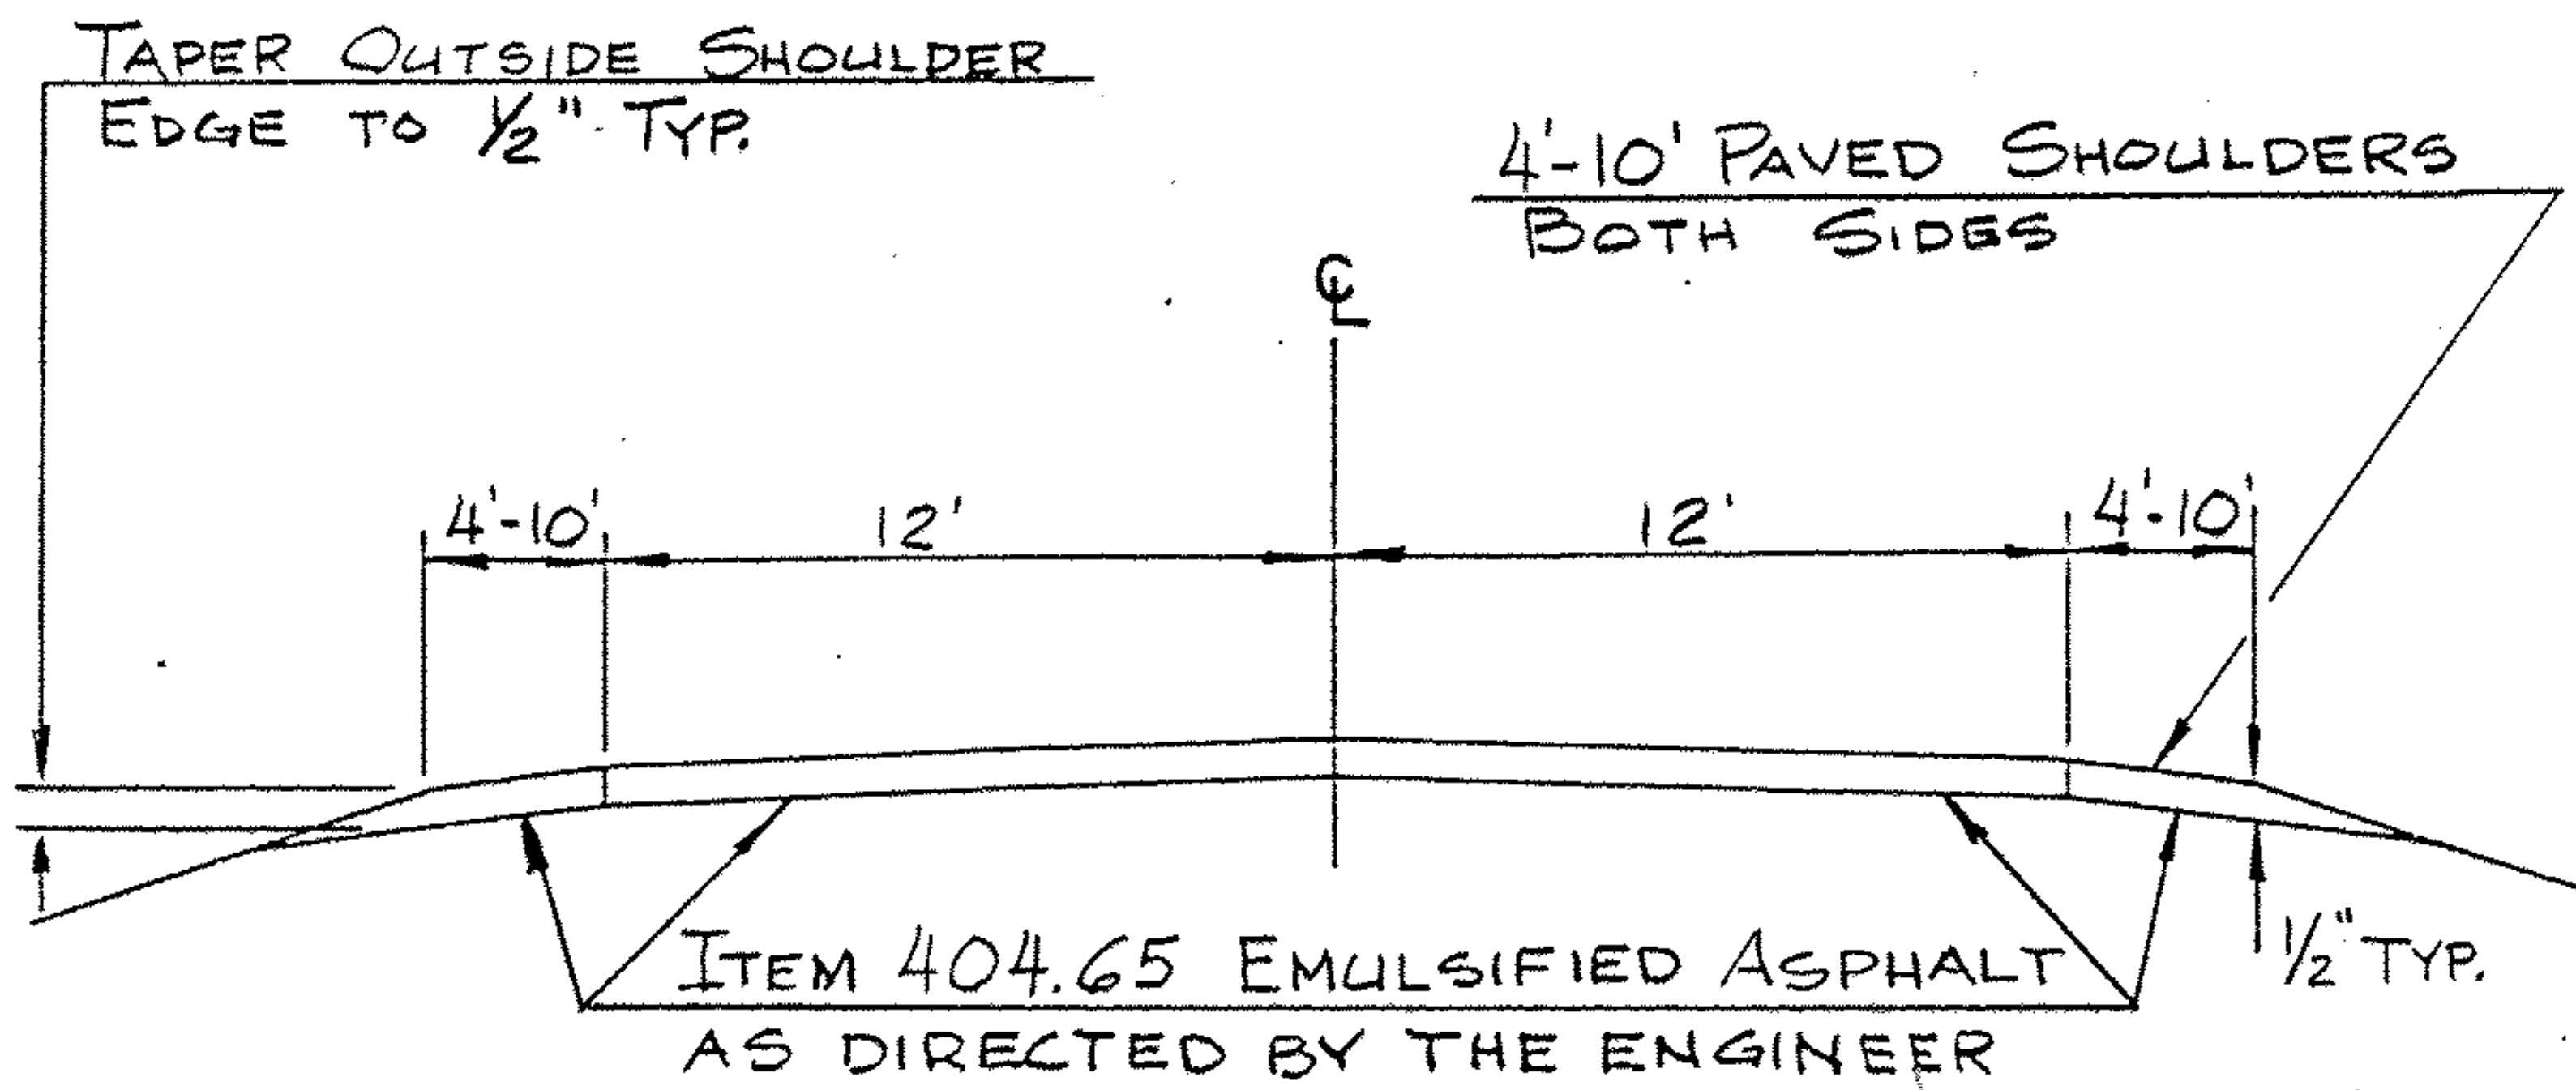

## MOUNT HOLLY

MM 1.626 - MM 1.805 @ 24' WIDE WITH 10' PAVED SHOULDERS

MM 2.565 - MM 5.105 @ 24' WIDE WITH 10' PAVED SHOULDERS

MM 5.105 - MM 6.105 @ 24' WIDE WITH 8' PAVED SHOULDERS

MM 6.425 - MM 7.683  $\frac{1}{2}$  @ 24' WIDE WITH 4' PAVED SHOULDERS

## WALLINGFORD

MM 0.00 - MM 0.450 @ 24' WIDE WITH 4' PAVED SHOULDERS