


# TYPICAL SECTIONS & DESIGN DATA

## ITEM 406.25 BITUMINOUS CONCRETE PAVEMENT

- LEVELING COURSE, TYPE III OR IV (34' WIDE @ 232 TON/MI.) AS DIRECTED BY THE ENGINEER.
- 1" WEARING COURSE, TYPE III

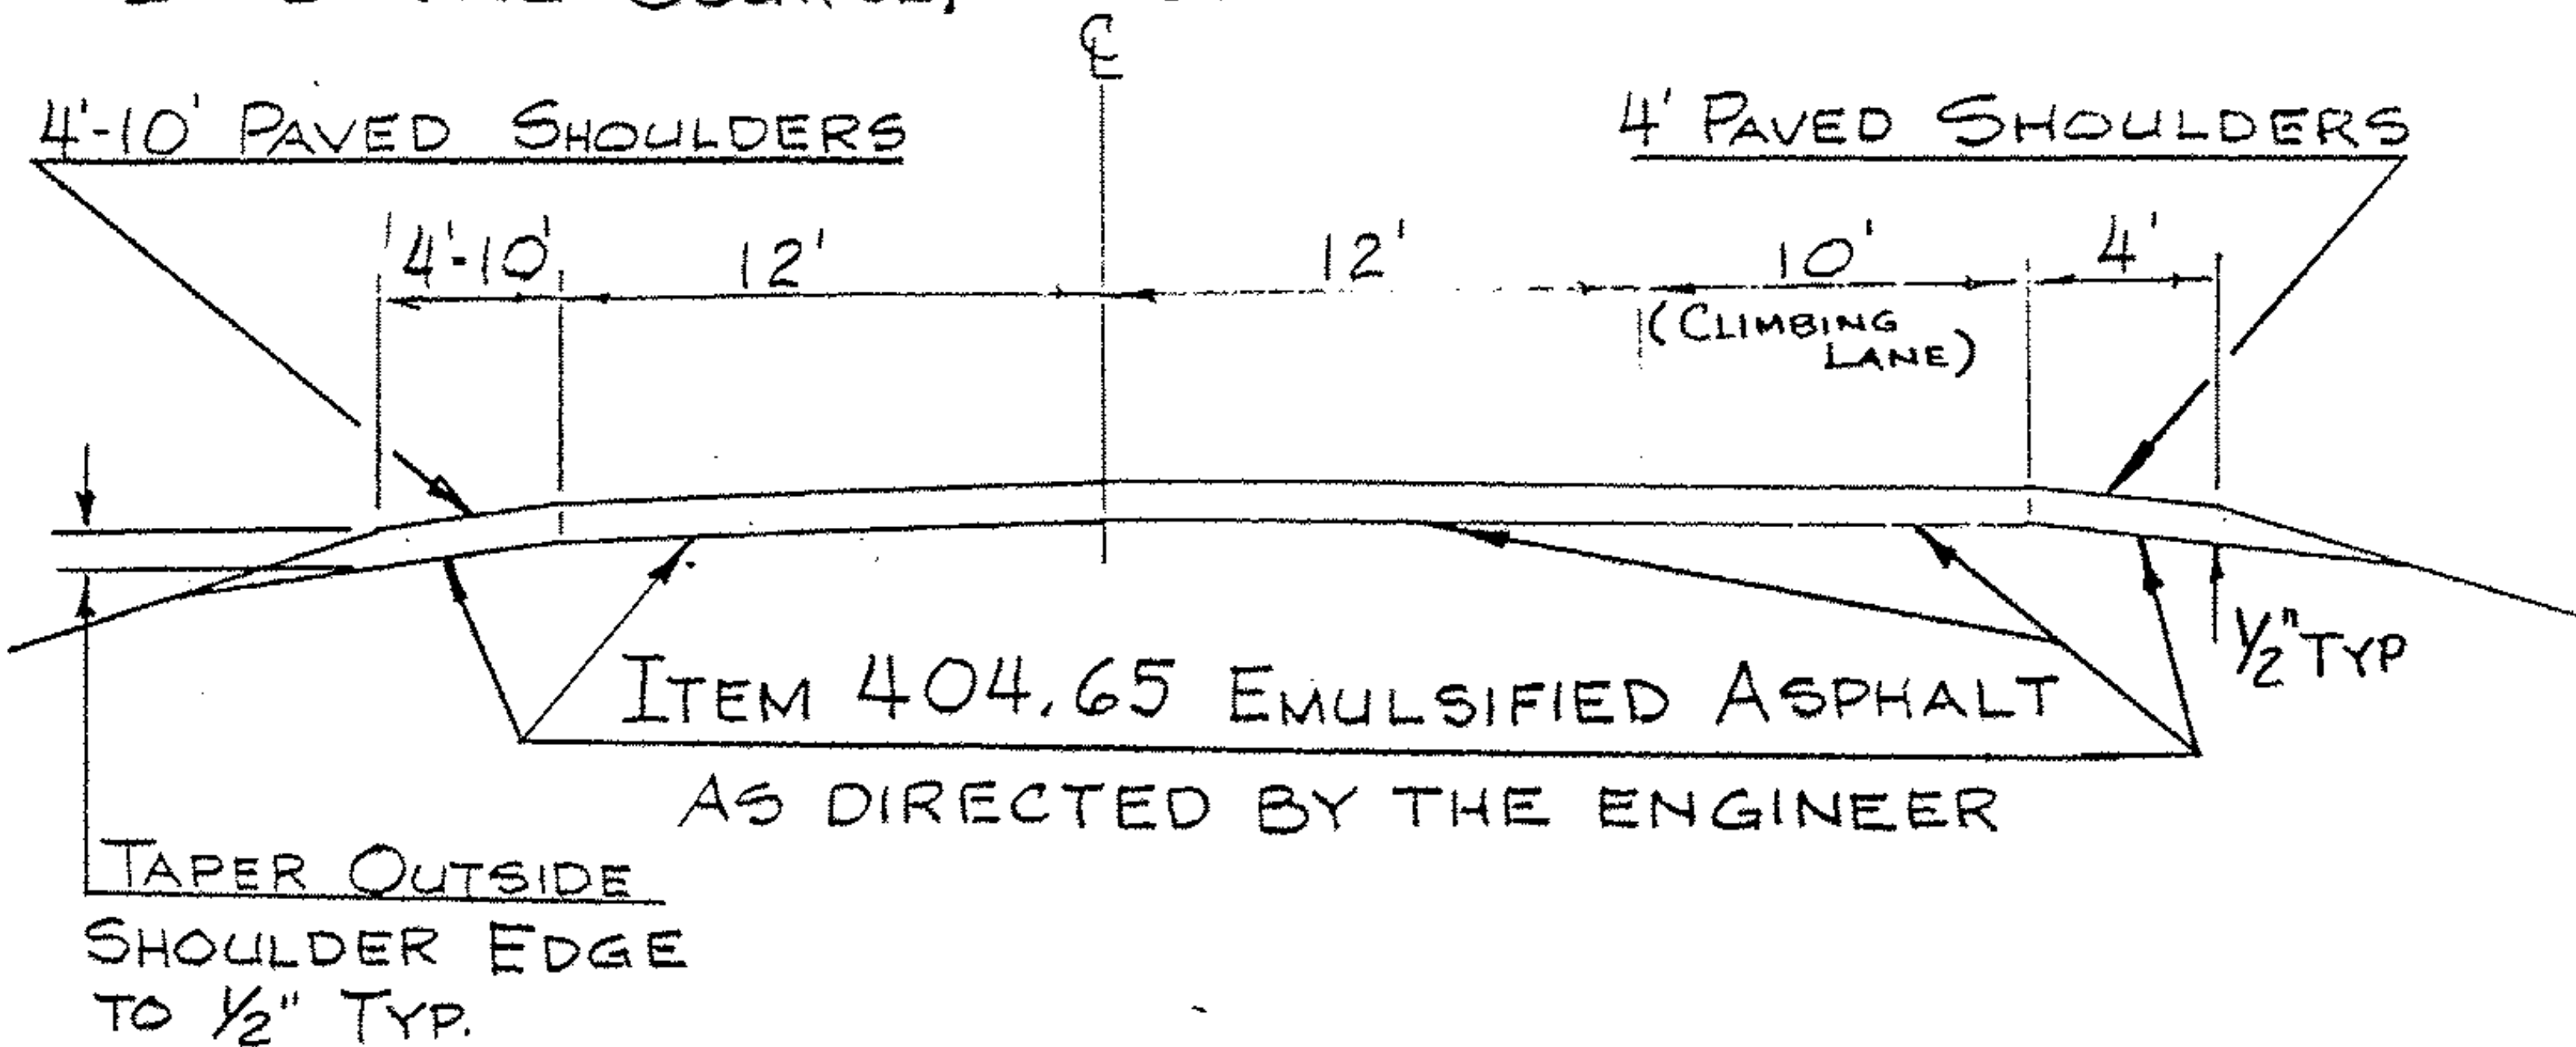

### MOUNT HOLLY - CLIMBING LANE

MM 1.805 - MM 2.565 @ 34' WIDE WITH A 10' AND A

4' PAVED SHOULDER

MM 6.105 - MM 6.425 @ 34' WIDE WITH 4' PAVED SHOULDERS