


PROJECT DESCRIPTION AND LOCATION

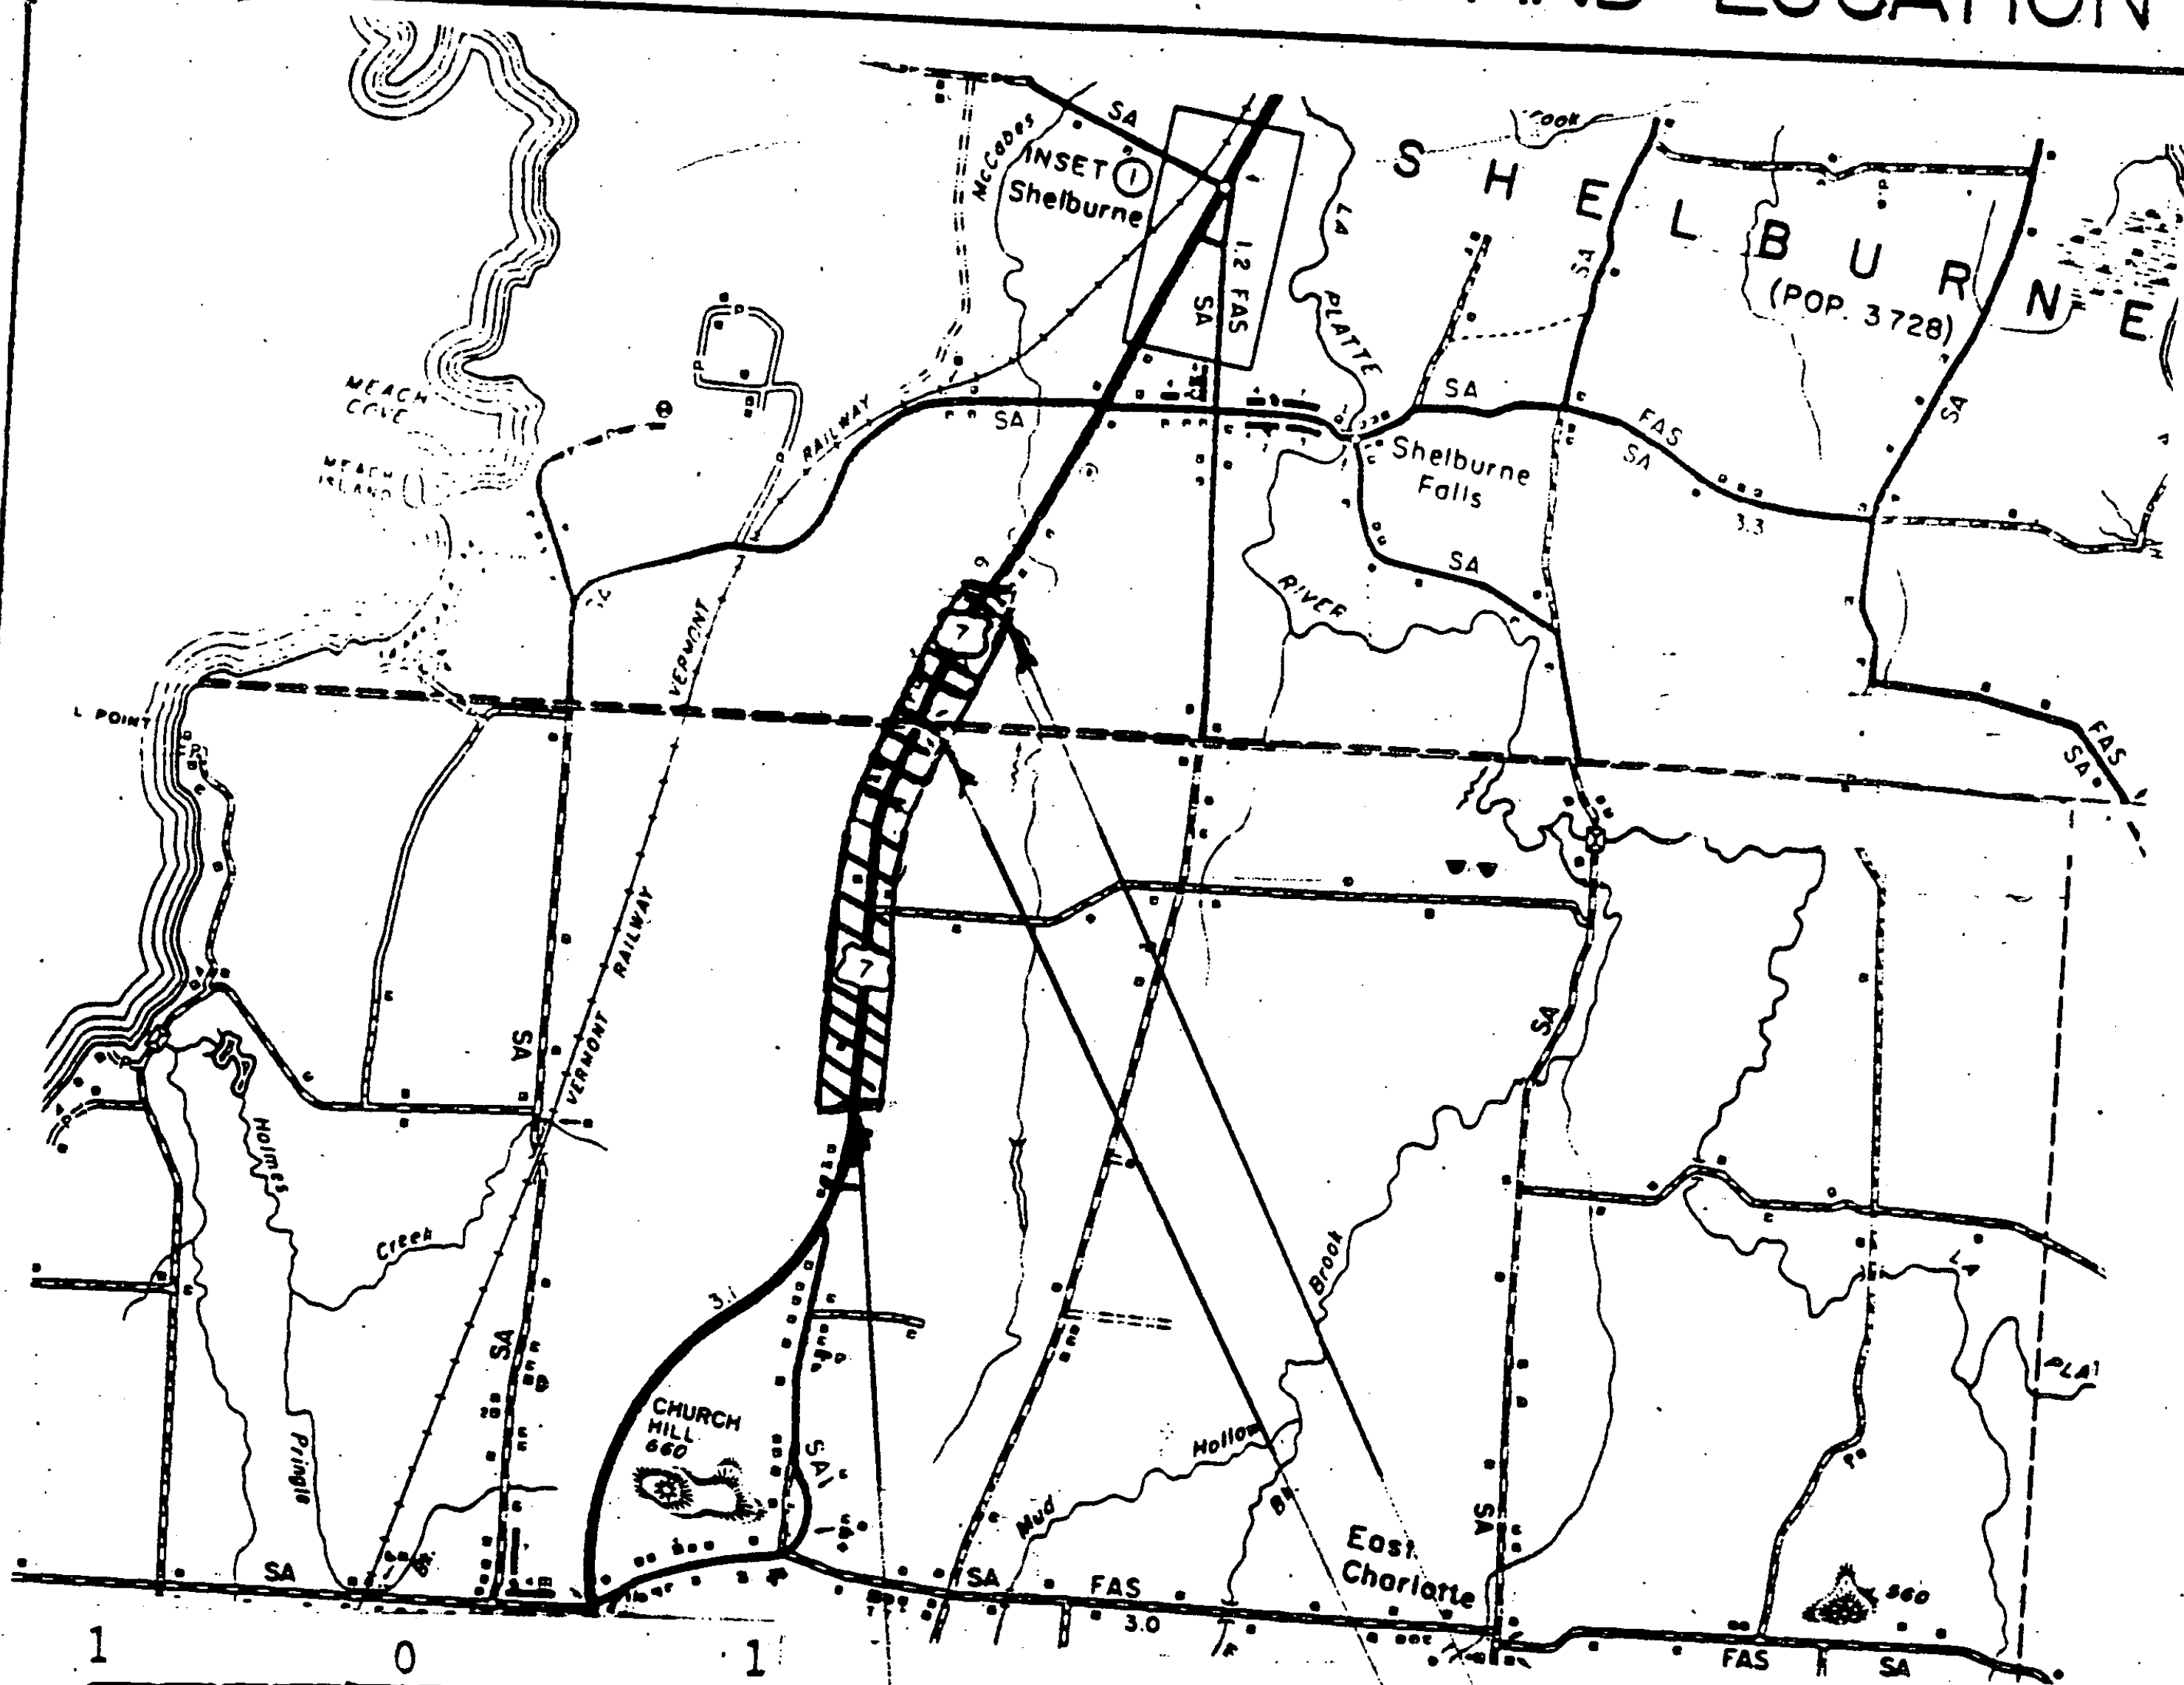

BEGIN PROJECT
 CHARLOTTE MM 5.340

END PROJECT
 SHELBURNE MM 0.504
 Shelburne MM 0.000
 Charlotte MM 6.549

On US 7, Beginning 1.209 miles southerly of the Shelburne-Charlotte town line at MM 5.340 in Charlotte and extending northerly 1.714 Miles to MM 0.504 in Shelburne

Work includes cutting and filling of joints over old portland cement pavement and bituminous concrete pavement overlay.

LENGTH OF PROJECT
 1.714 Miles
 9048 Feet

PROJECT CHARLOTTE-SHELBURNE

NO. F 019-4(15)S

SHEET 2 OF 11 SHEETS