


* Centerline treatment shall consist of a minimum of 400 feet of solid line in advance of the intersection and shall be paired with either a solid or dashed line depending on sight distance availability in the opposing lane.

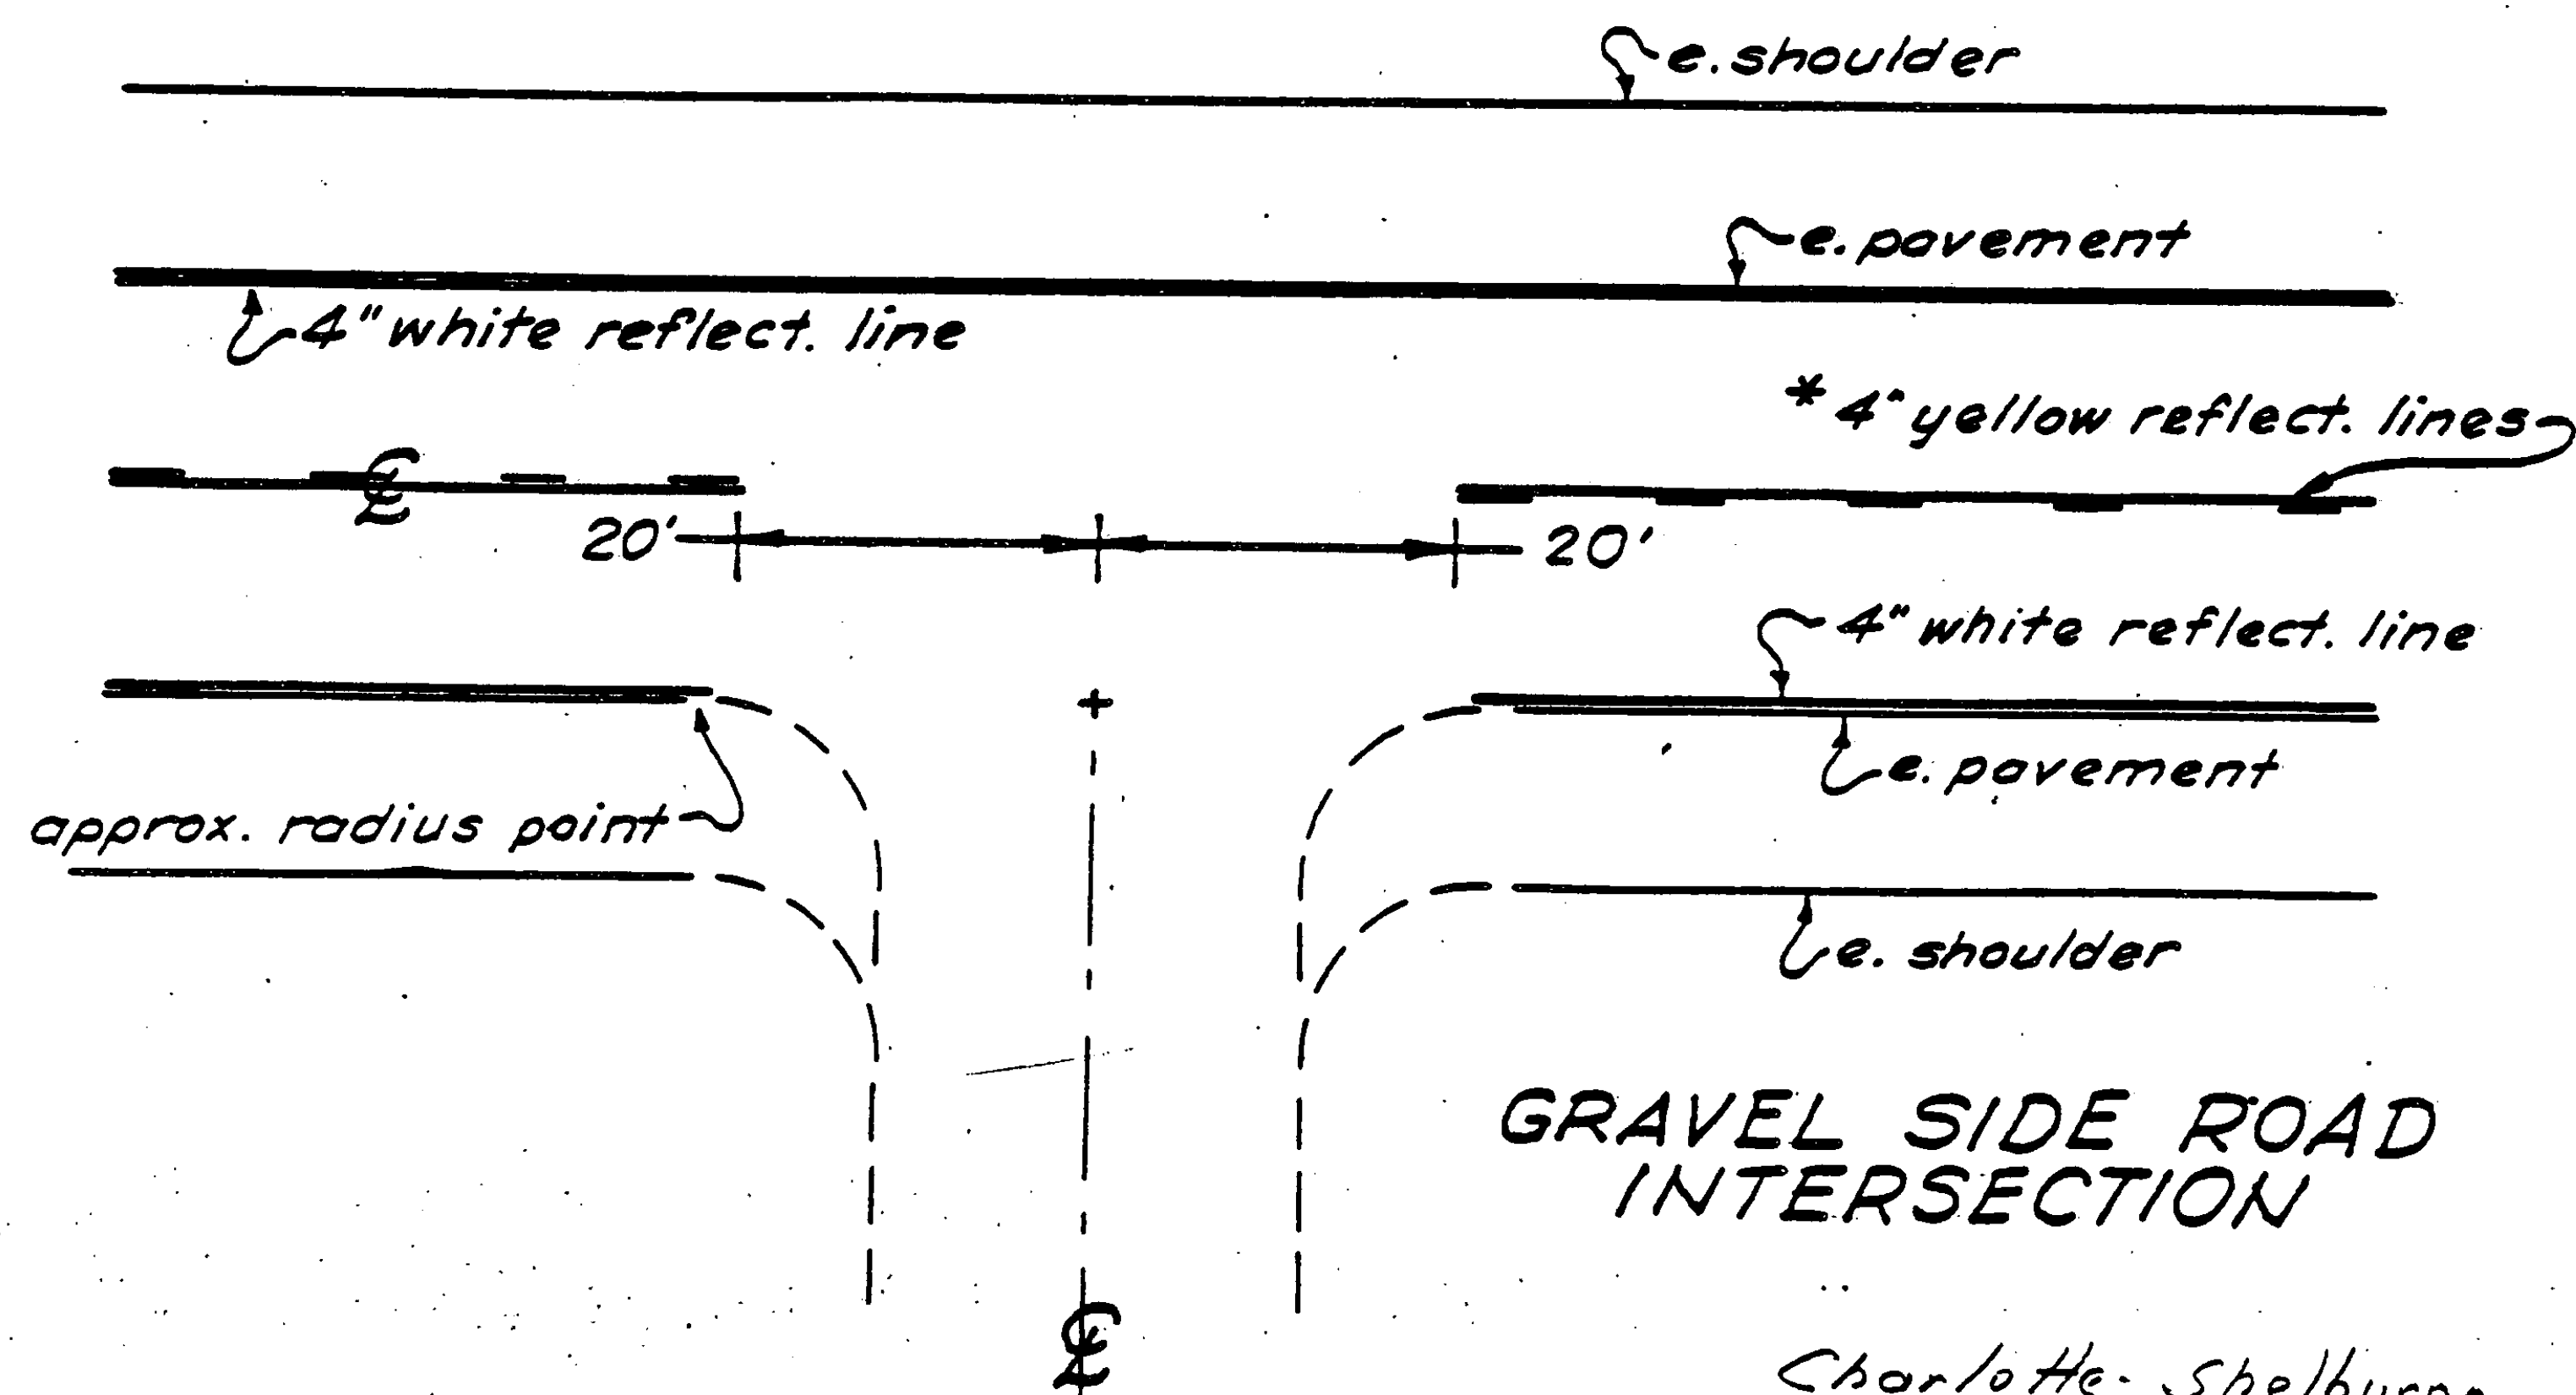

Charlotte Shelburne
F 019-4(15)5
Sheet 10 of 11.