


PROJECT DESCRIPTION AND LOCATION

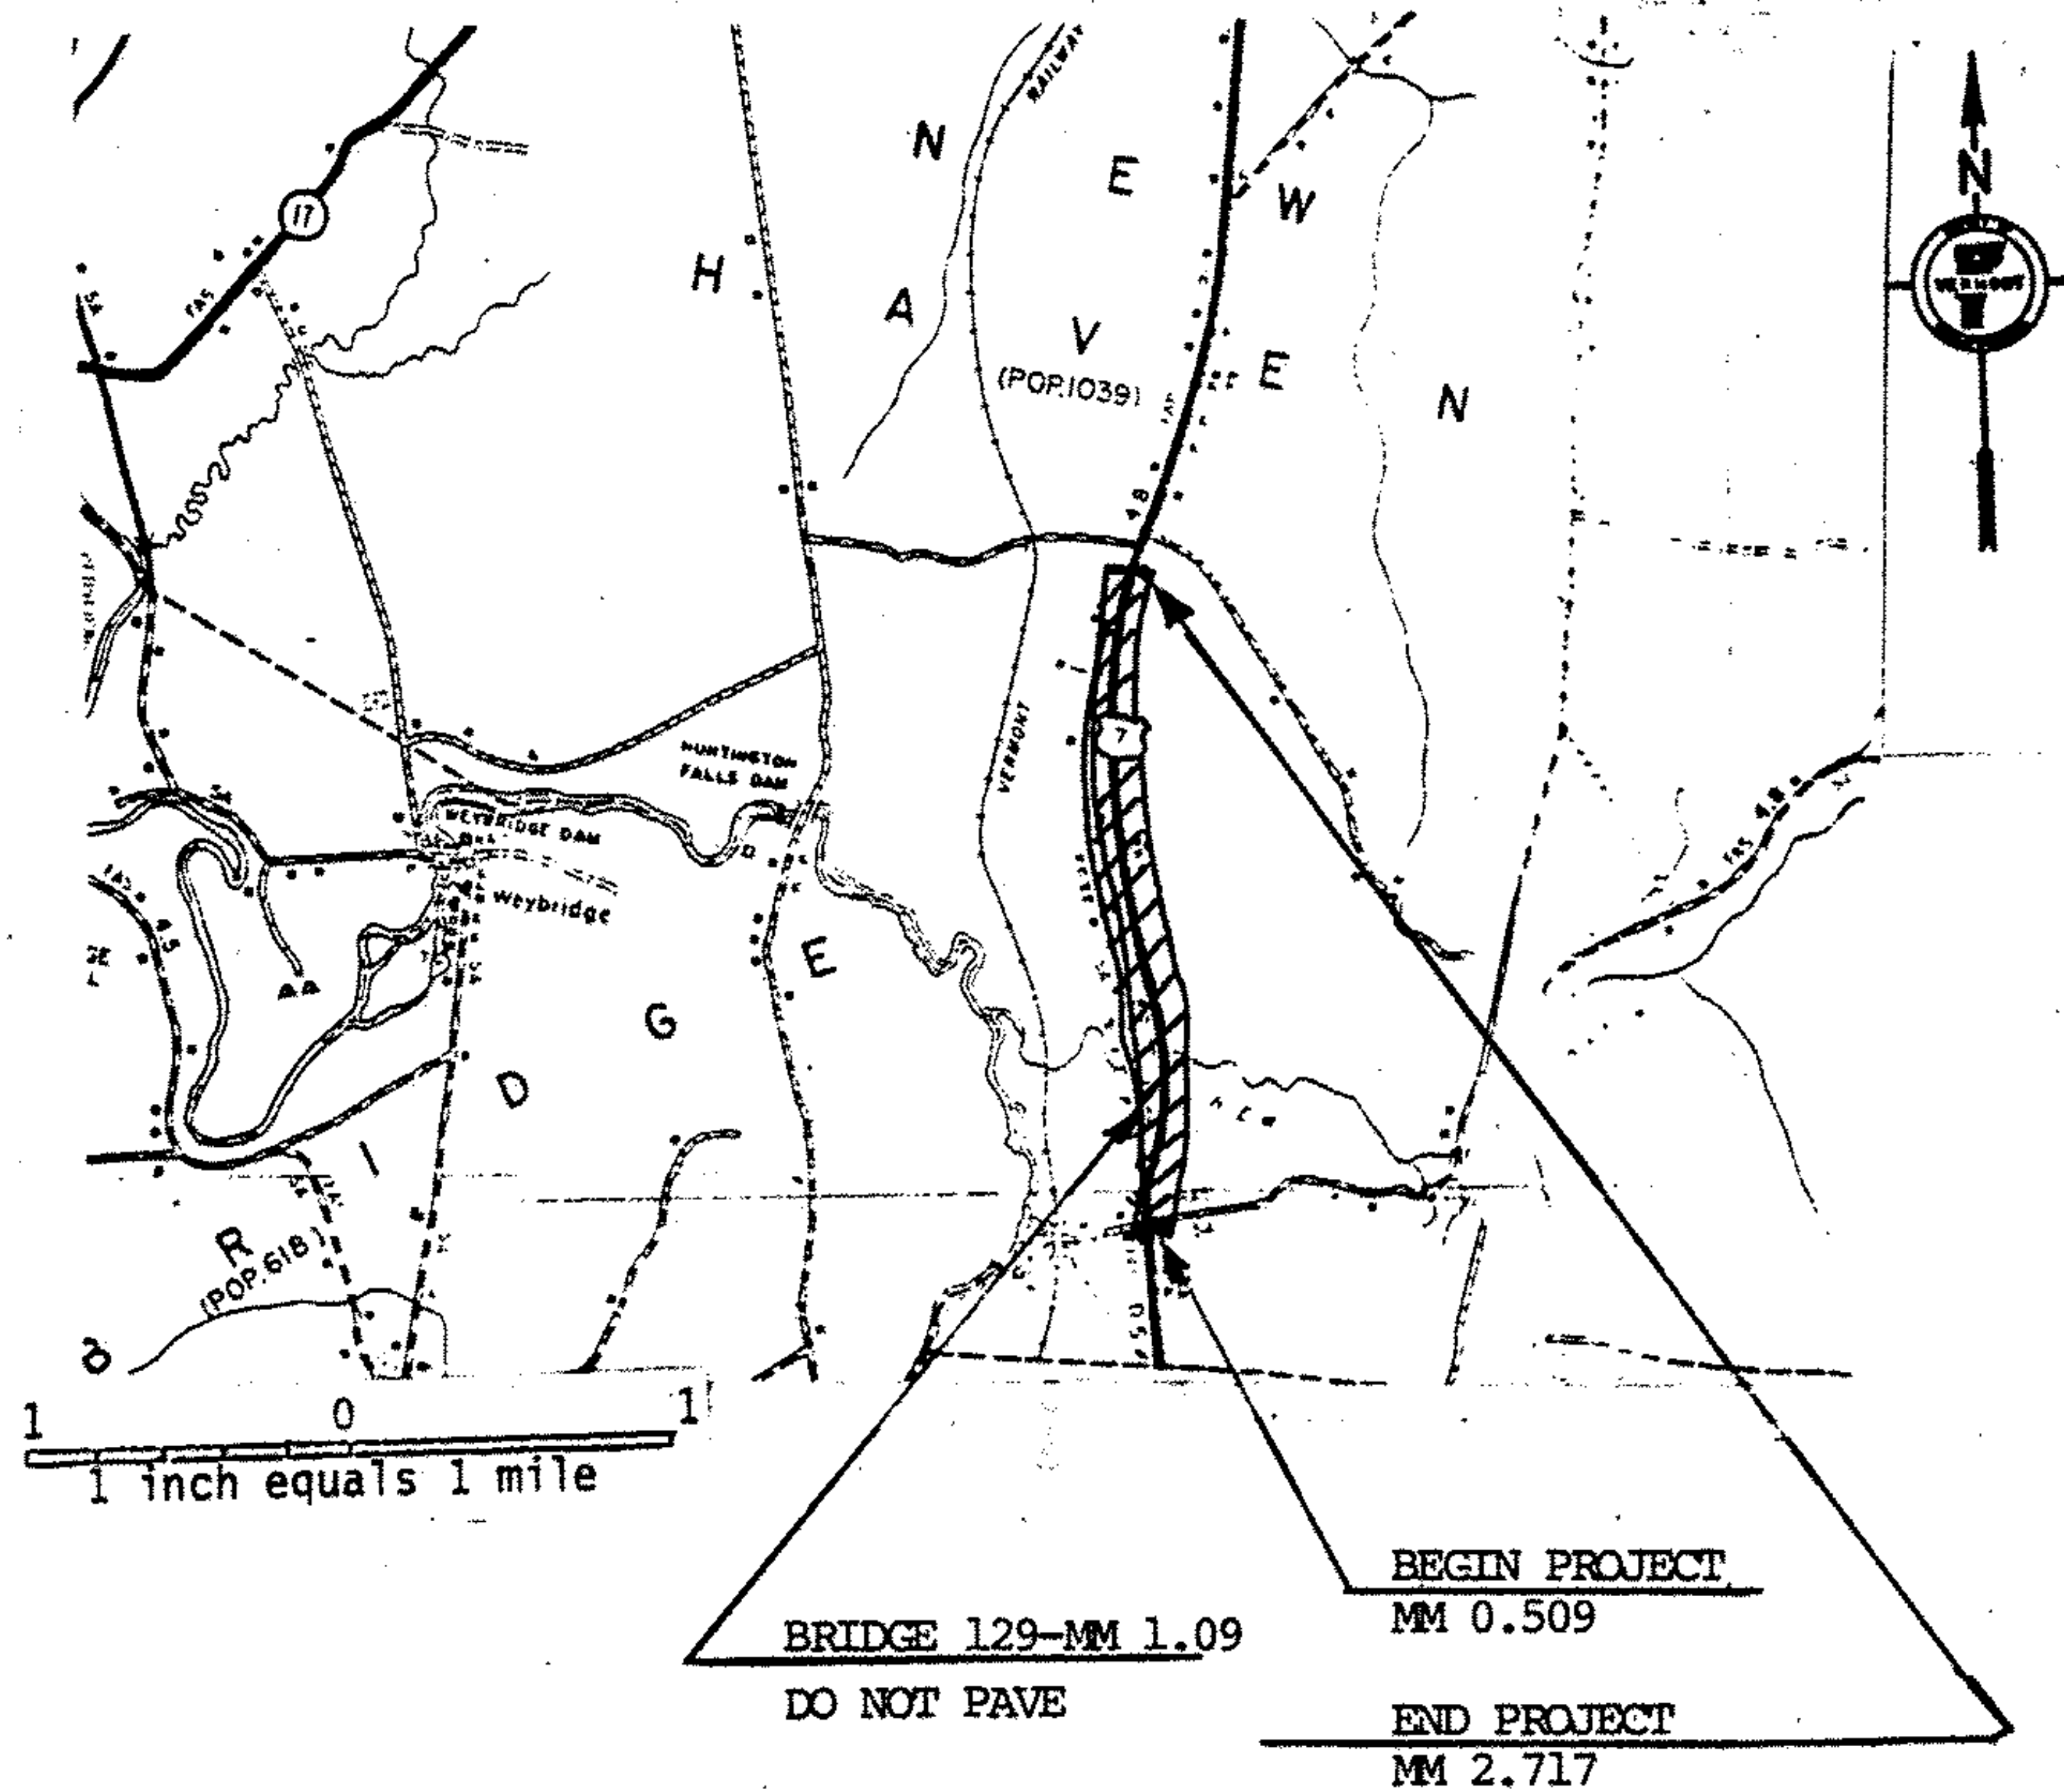

On US-7, Beginning 0.509 miles from the Middlebury-New Haven Town Line
at MM 0.509 and extending northerly 2.208 miles to MM 2.717

LENGTH OF PROJECT
2.208 Miles.
11,663 Feet