



TYPICAL SECTIONS & DESIGN DATA

ITEM 406.25 BITUMINOUS CONCRETE PAVEMENT
 Leveling course, Type III or IV (309 Tons/Mile)
 AS DIRECTED BY THE ENGINEER
 1½" Wearing course, (+¼") Type III

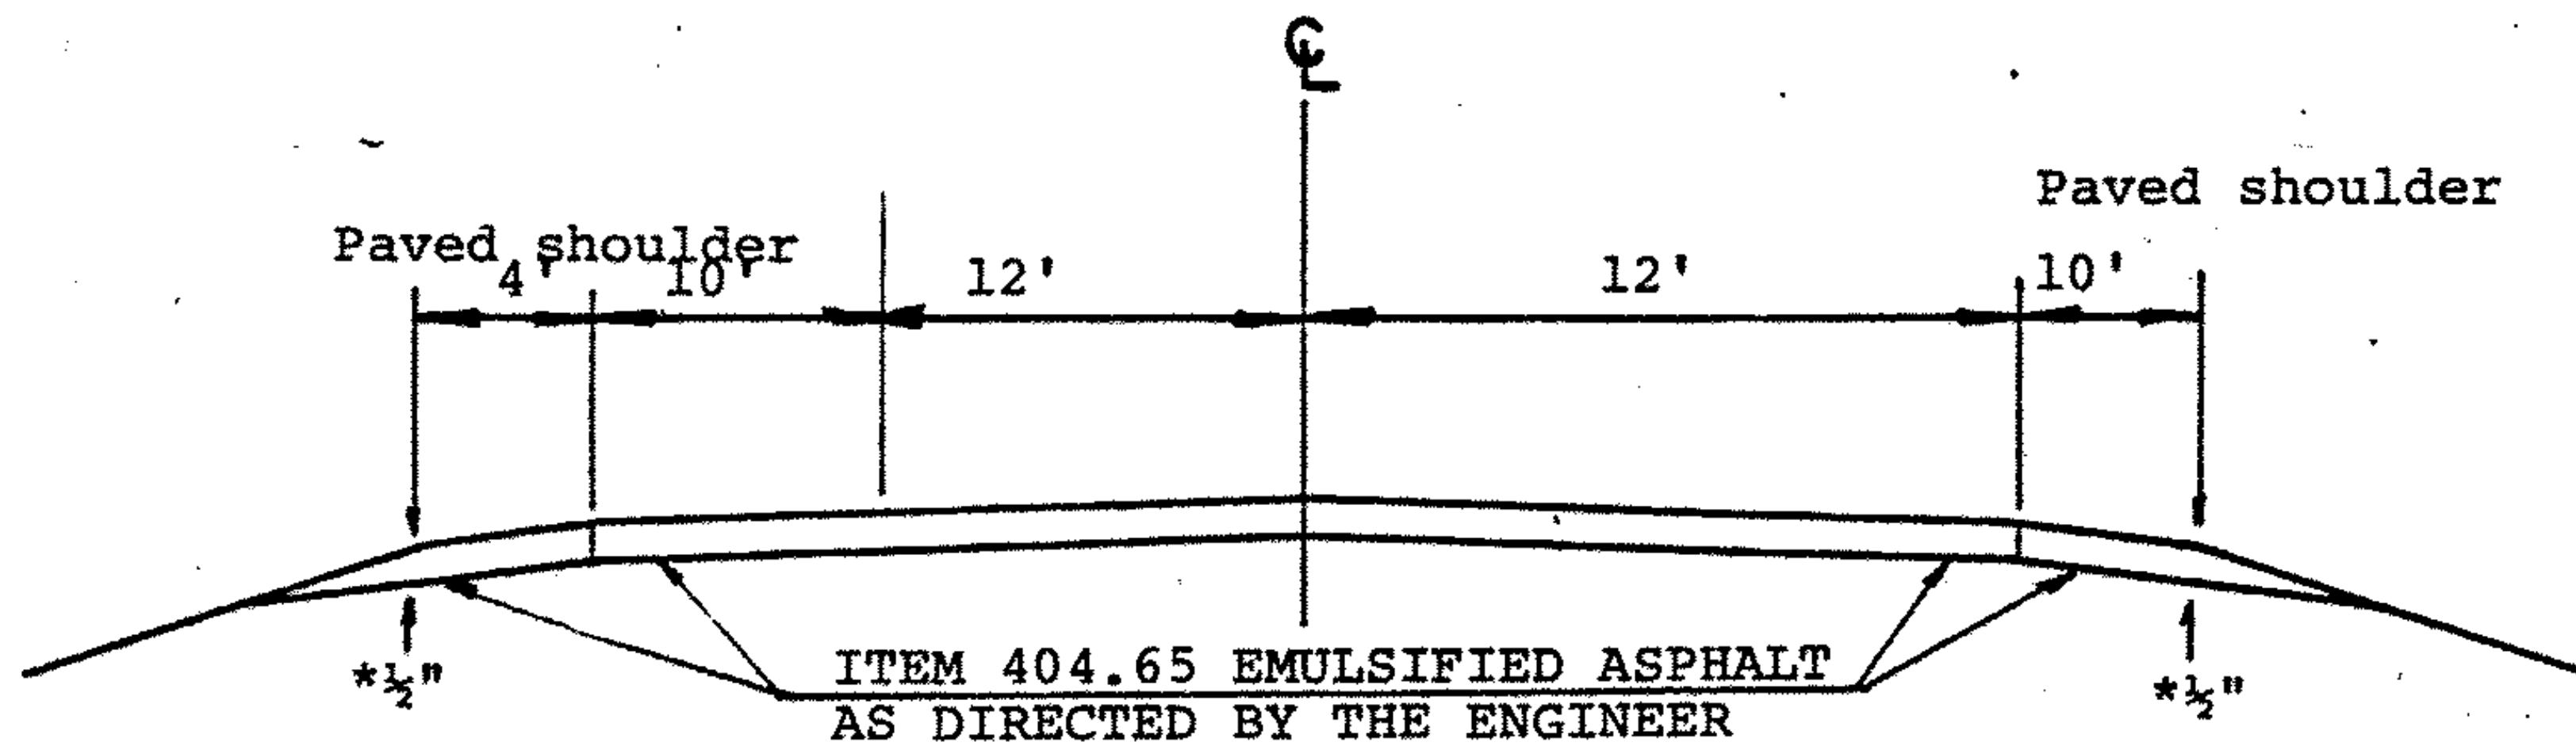

MM 0.509 - MM 0.800

ITEM 406.25 BITUMINOUS CONCRETE PAVEMENT
 Leveling course, Type III or IV (218 Tons/Mile)
 AS DIRECTED BY THE ENGINEER
 1½" Wearing course (+¼") Type III

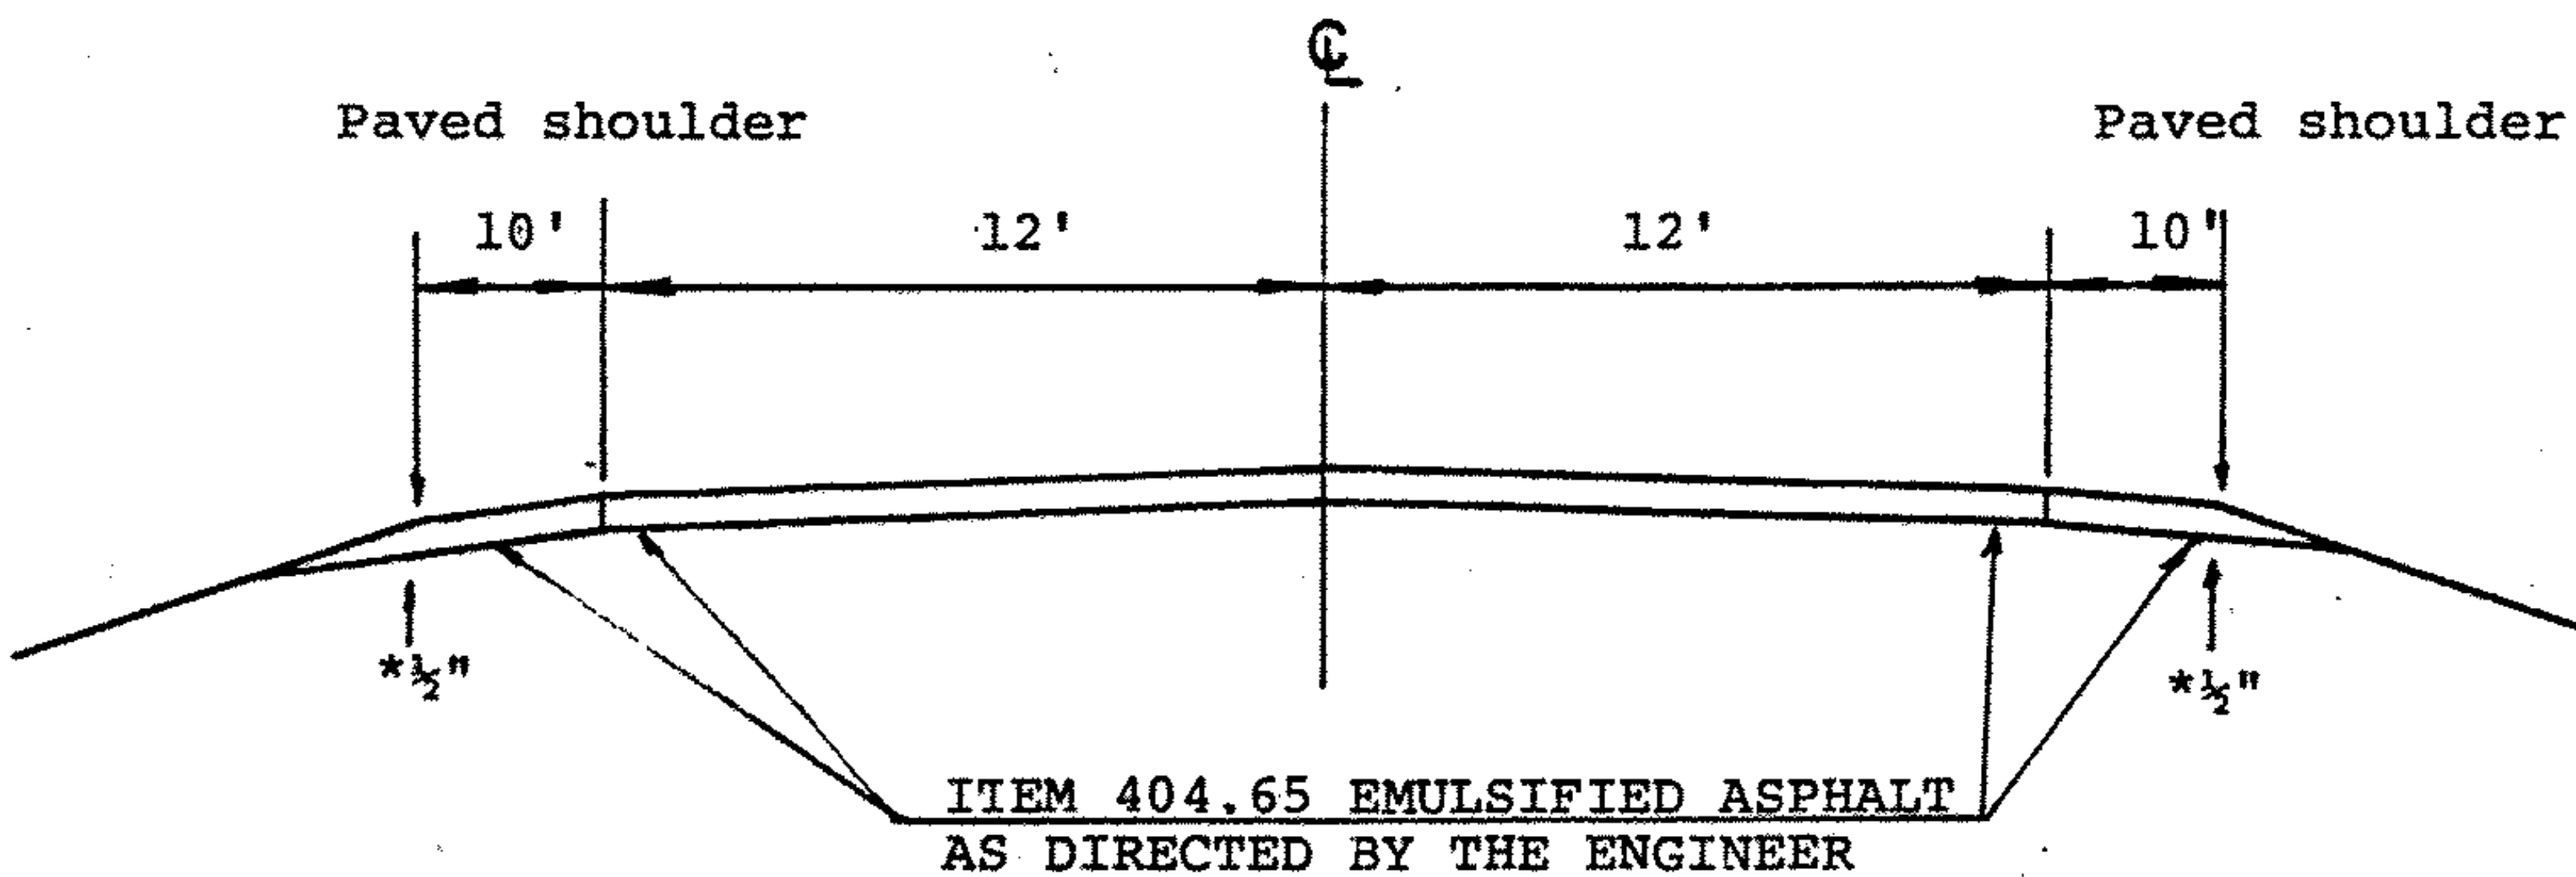

MM 0.800 - MM 1.500
 MM 2.030 - MM 2.717

TRAFFIC DATA
 1982 ADT - 4890
 V = 50 MPH

*Shoulder to be tapered from full depth to ¼"

PROJECT NEW HAVEN

NO. F 019-3(36)S
 SHEET 3 OF 10