


TYPICAL SECTIONS & DESIGN DATA

ITEM 406.25 BITUMINOUS CONCRETE PAVEMENT
Leveling course, type III or IV (218 Tons/Mile)
AS DIRECTED BY THE ENGINEER
1½" Wearing course (+½") Type III

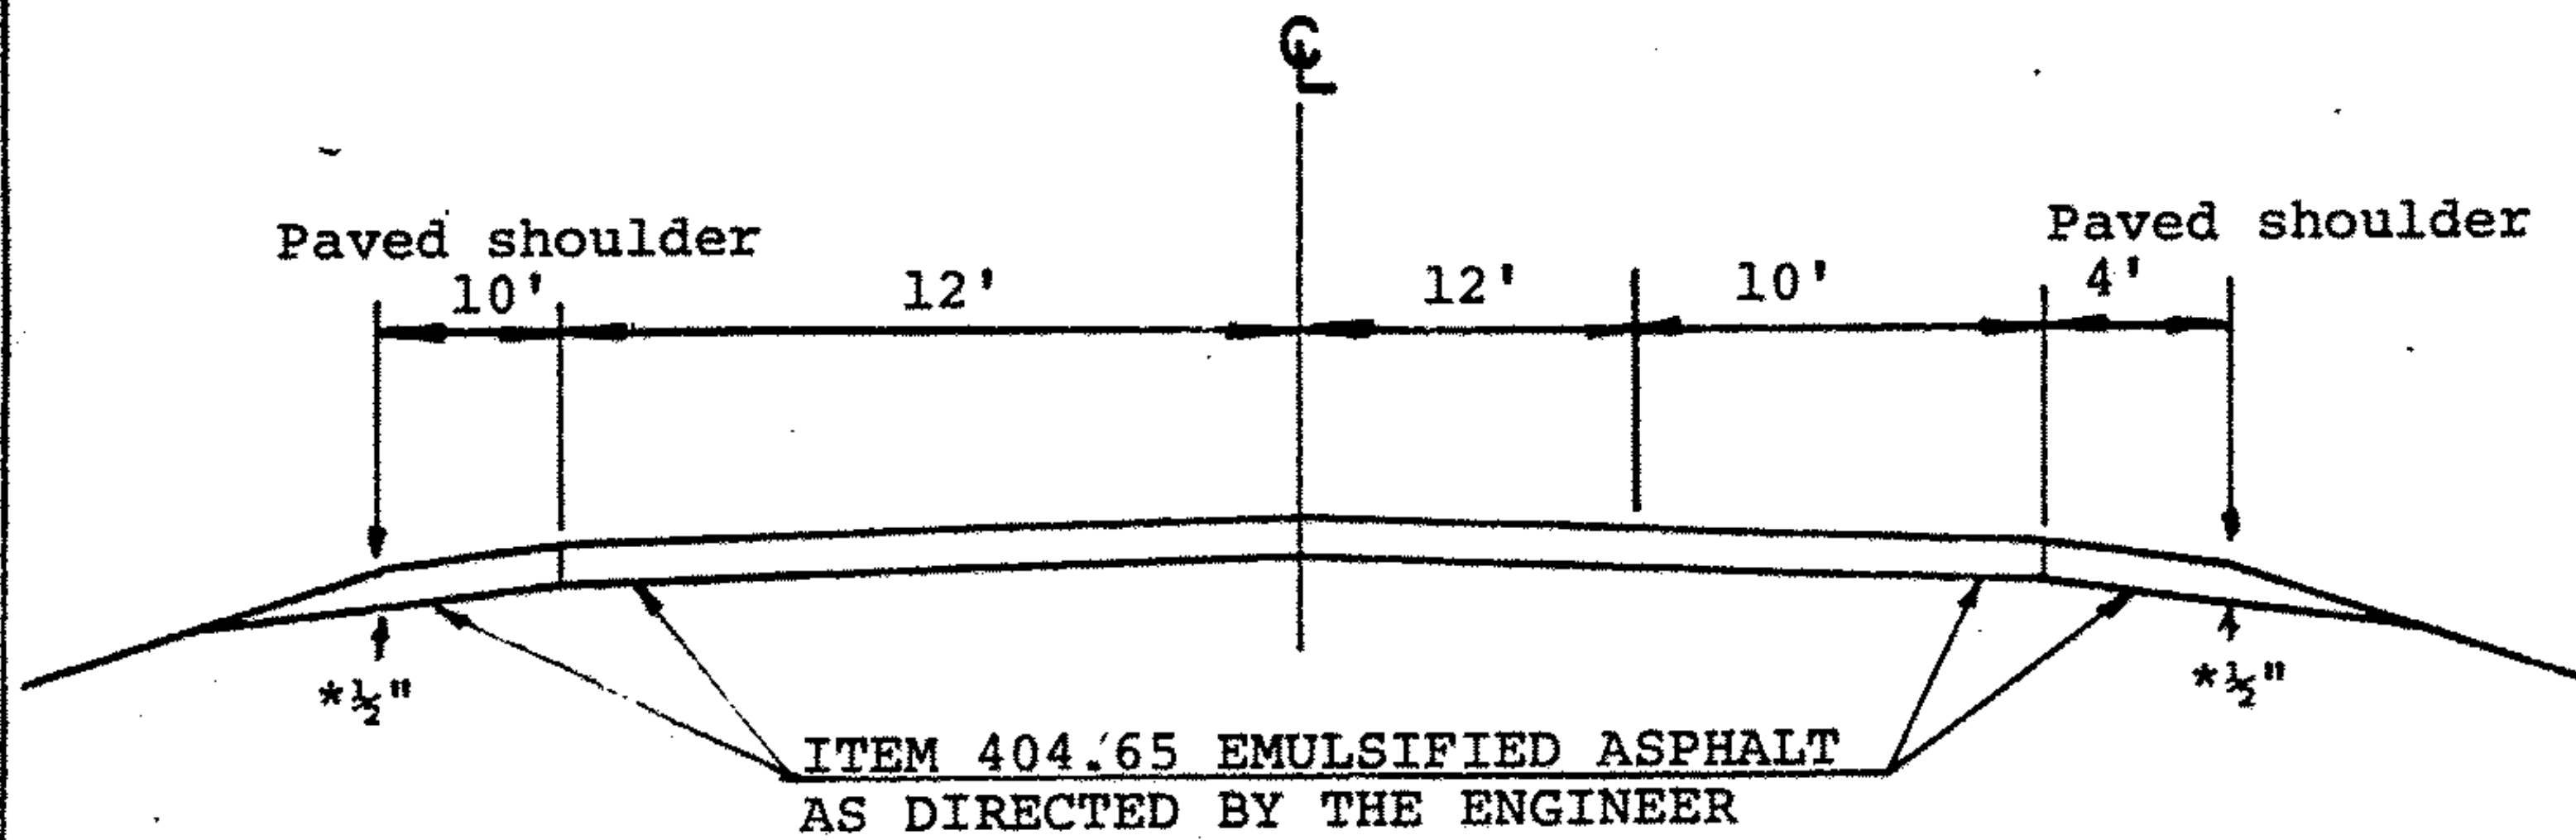

MM 1.500 - MM 2.030

* Shoulders to be tapered from full depth to ½"

PROJECT NEW HAVEN

NO. F 019-3(36)S

SHEET 3A OF 10 SHEETS