


TYPICAL SECTIONS & DESIGN DATA

Item 406.25 Bituminous Concrete Pavement¹
 Leveling Course Type III or Type IV 24' (164 Tons/Mi.)
 AS DIRECTED BY THE ENGINEER
 1½" WEARING COURSE (+¼") TYPE III 24' WIDE

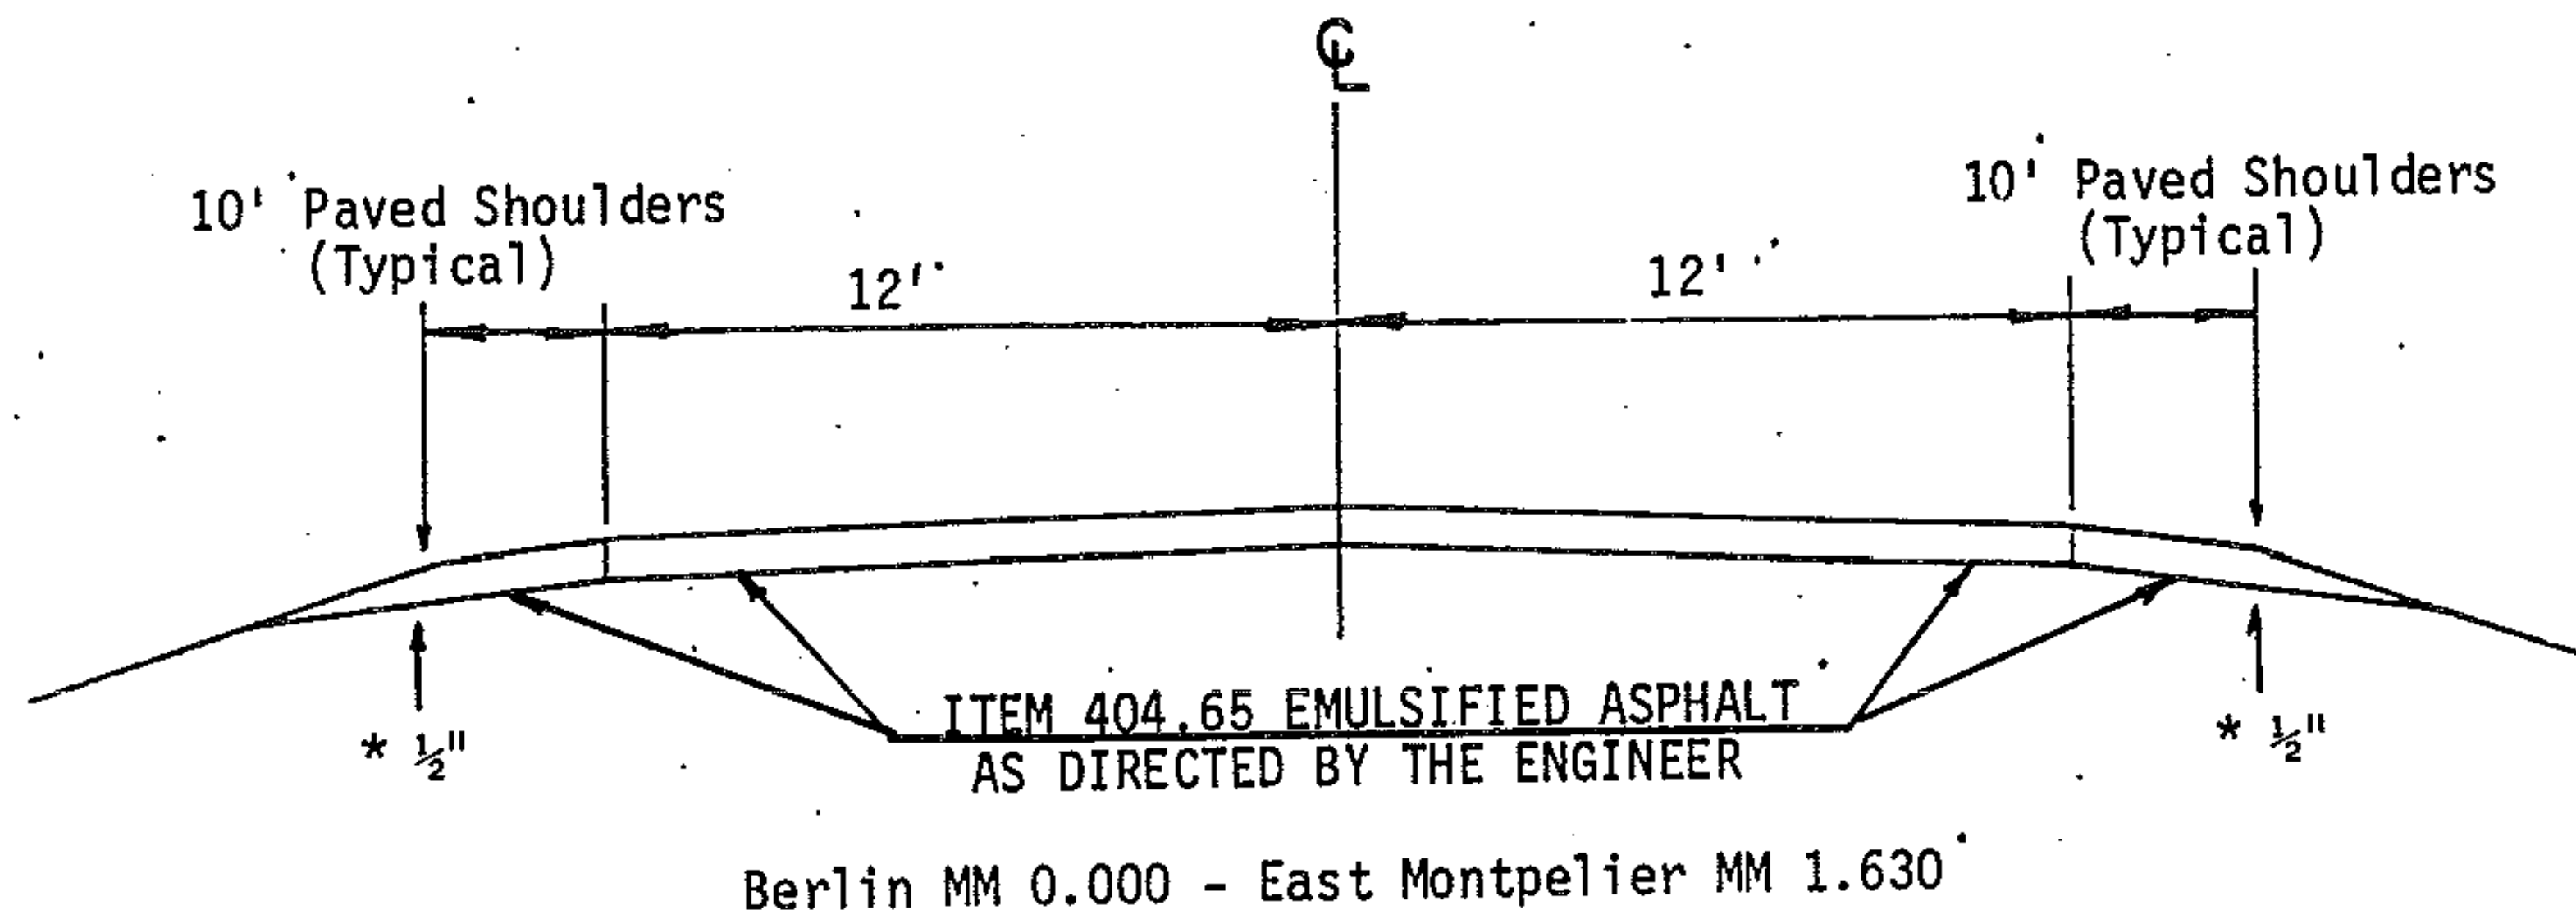

TRAFFIC DATA
 1982 ADT - 5,150
 V = 50 MPH

1 Project also includes 1000 tons of Polyester Modified Bituminous Concrete Pavement to be placed as directed by the Engineer. For details see Special Provisions.

*Shoulder to be tapered from full depth to ½".