
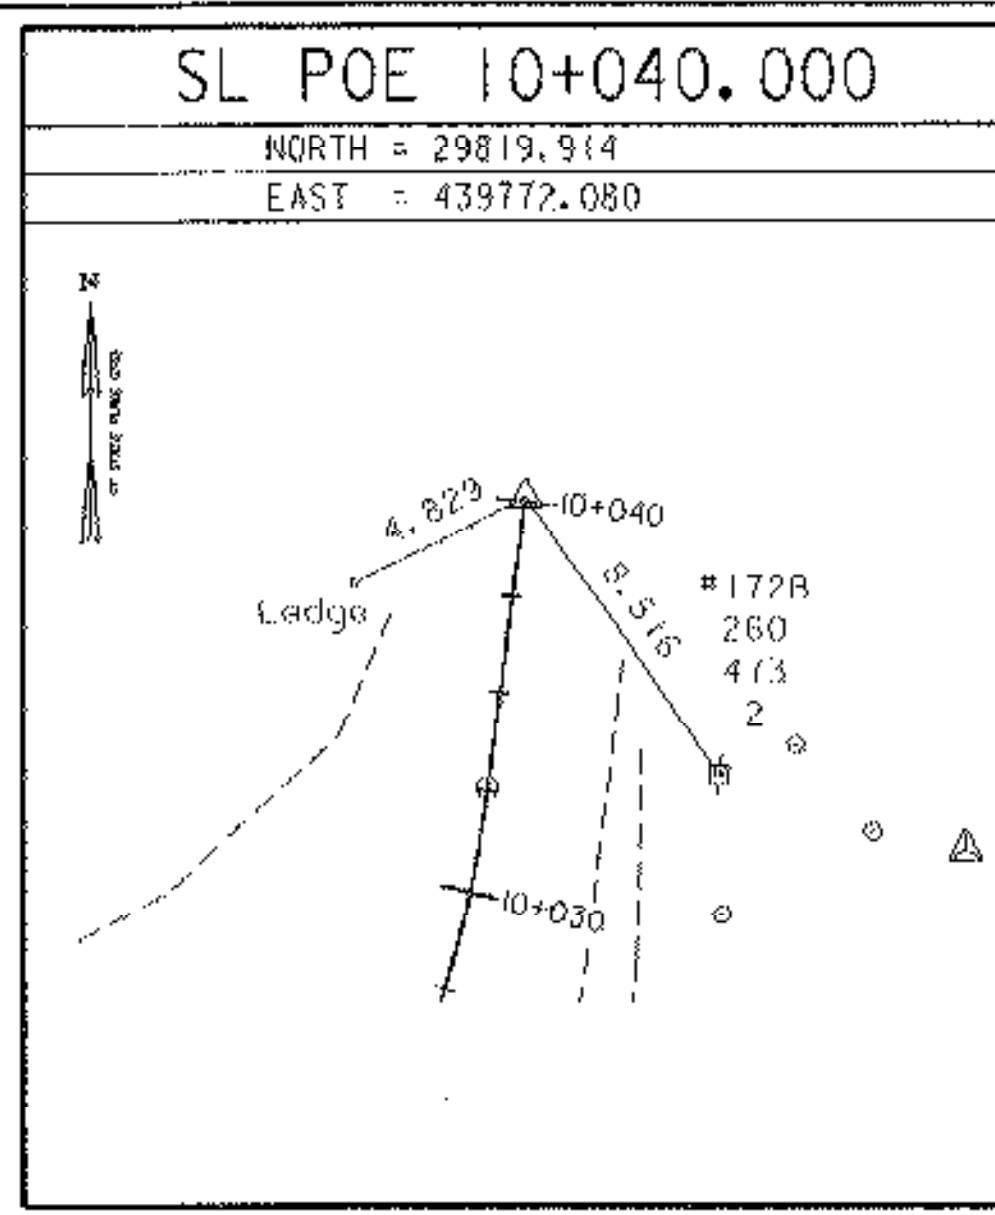
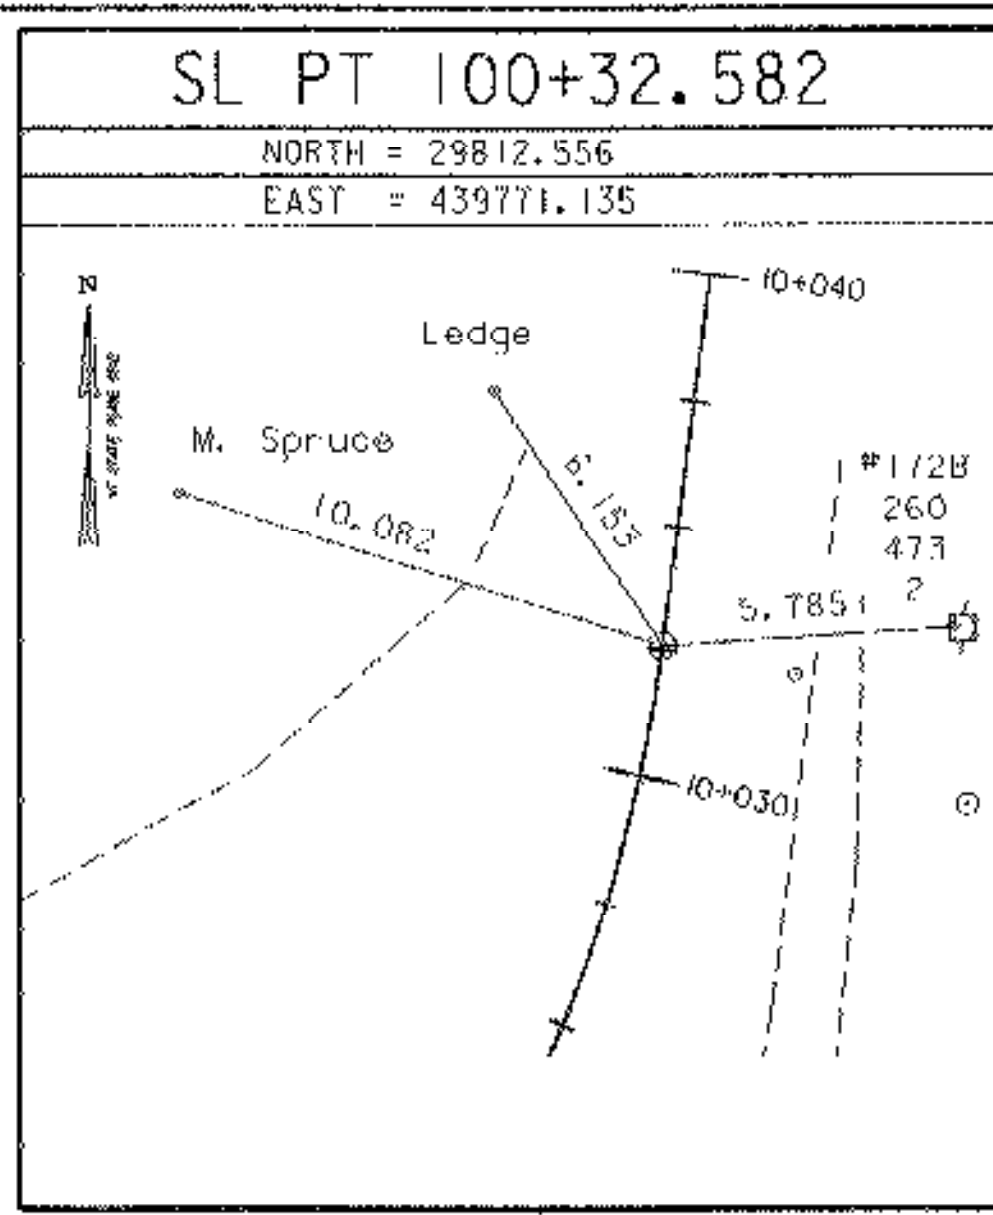
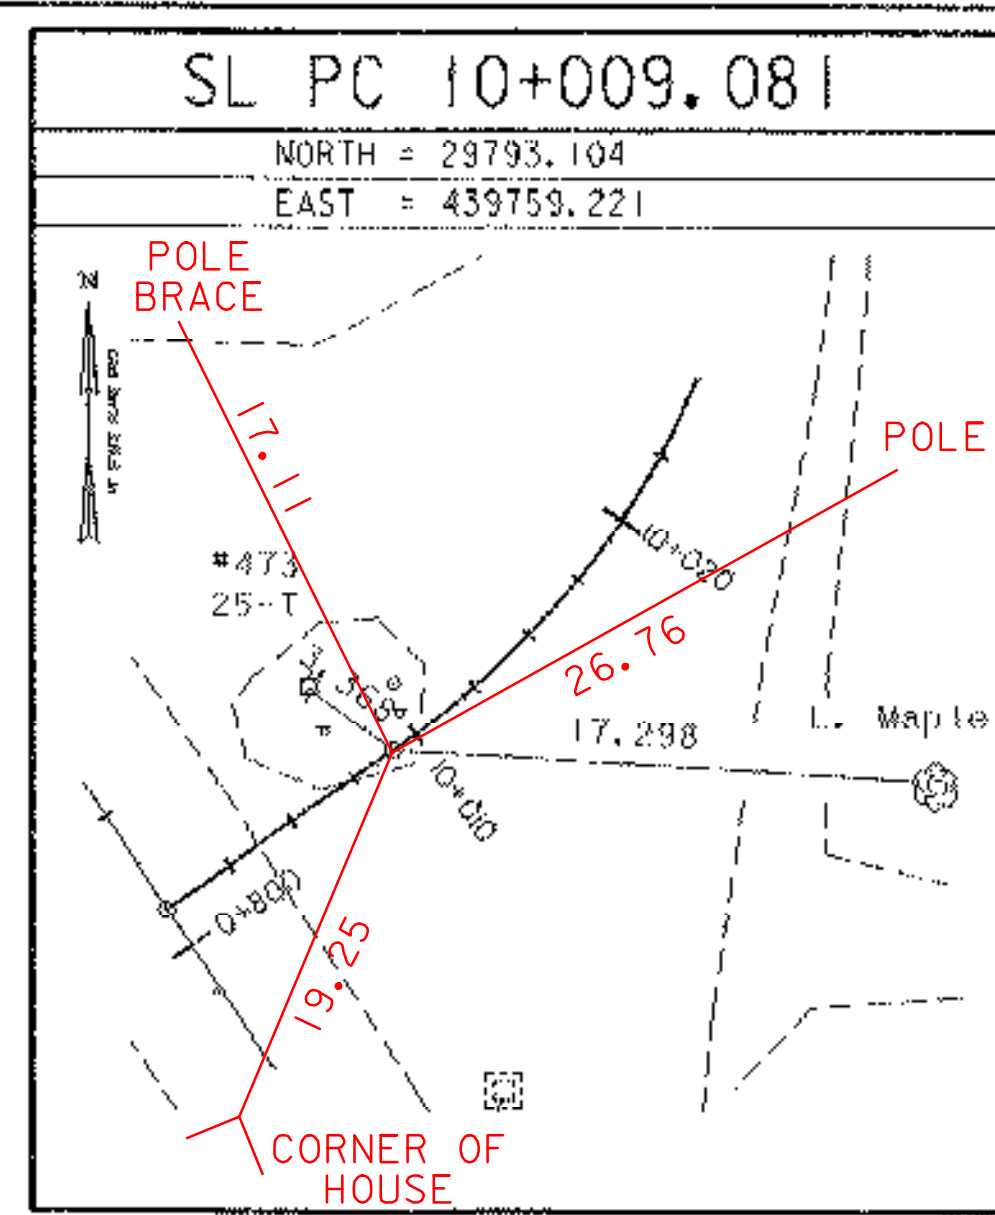


ALIGNMENT TIES

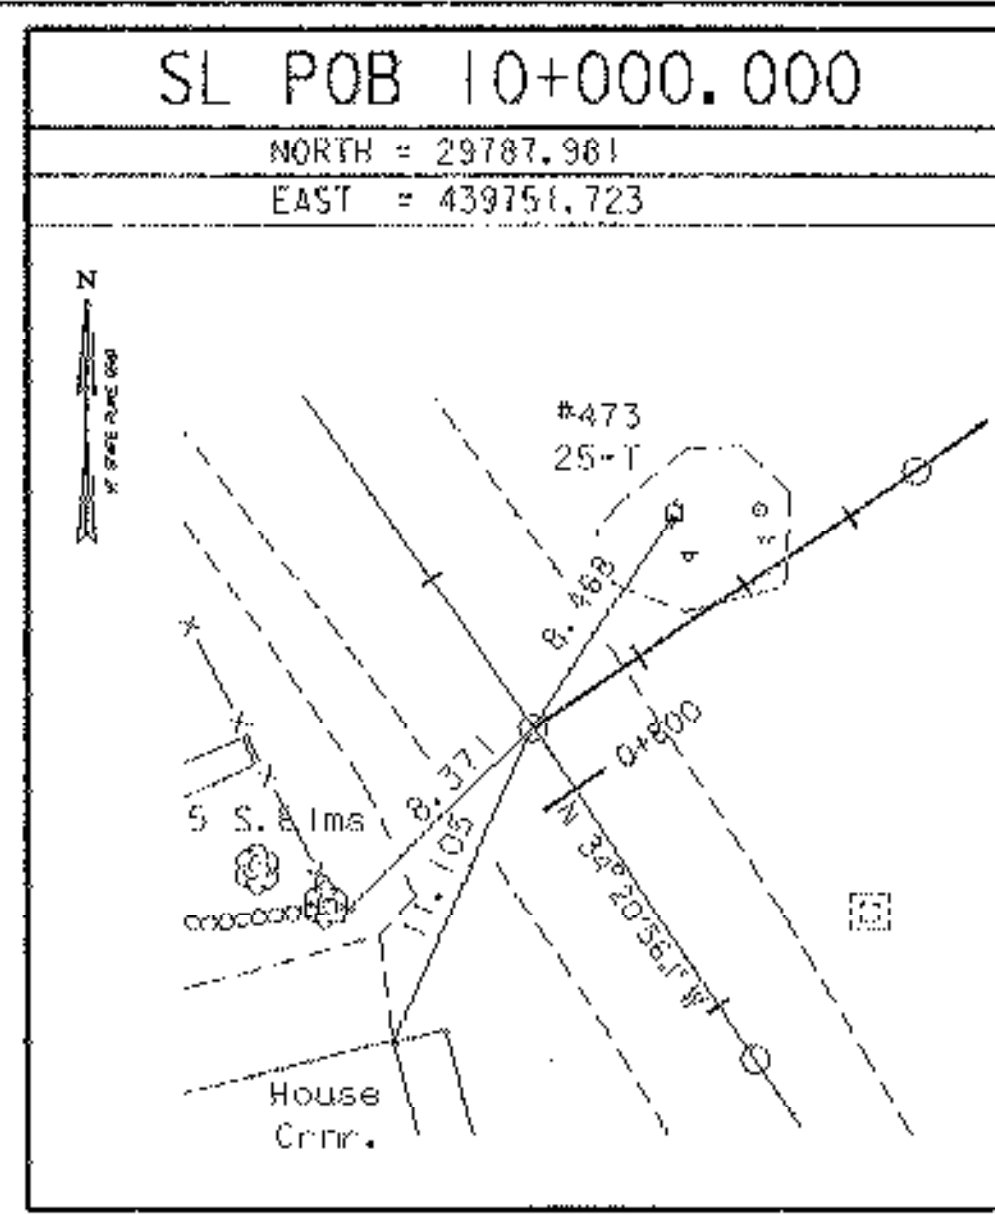

* Alignment Staked 05/08/03 by L. Orvis P.C. & J. Hulett & C. Harding

DATUM	
VERTICAL	NAVD 88
HORIZONTAL	NAD 88 (96)
ADJUSTMENT	Least Sq.

PROJECT NAME:	Pownd	PLOT DATE:	10-MAY-2007
PROJECT NUMBER:	STP RS 0107 (8)	DRAWN BY:	R. Bullock
FILE NAME:	84c028/survey/xc0281.dgn	CHECKED BY:	J. HULETT
PROJECT LEADER:	W. SYMONDS	SHEET	15 OF 65
DESIGNED BY:	L. ORVIS		