


**THE GRAY SHADING SHOWN ON THIS SHEET REPRESENTS AREAS WITHIN THE BOUNDARY OF THE PROJECT DEFINITION FENCE WHICH WILL BE SEEDED, FERTILIZED, AND MULCHED IF DIRECTED BY THE ENGINEER.**

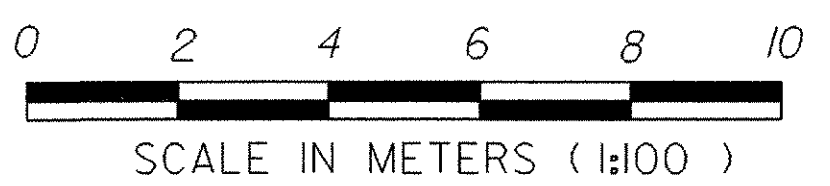

<b>EPSC FINAL CONDITIONS #1</b>	
PROJECT: <b>POWNAL</b>	PROJECT NO. : <b>STP RS 0107(8)</b>
DESIGN FILE NAME: /84c028/str/sc028ecbdr.dgn	PLOT DATE: 10-MAY-2007
IPARM FILE NAME: sc028ecfinal01.i	SURVEY DATE: 09-22-1998
SURVEYED BY: L. ORVIS	DRAWN BY: G. SHANGRAW
SQUAD LEADER: W. SYMONDS	SHEET: 31 OF 65
sc028ecfinal01	