




**ELEVATION WINGWALL 3**

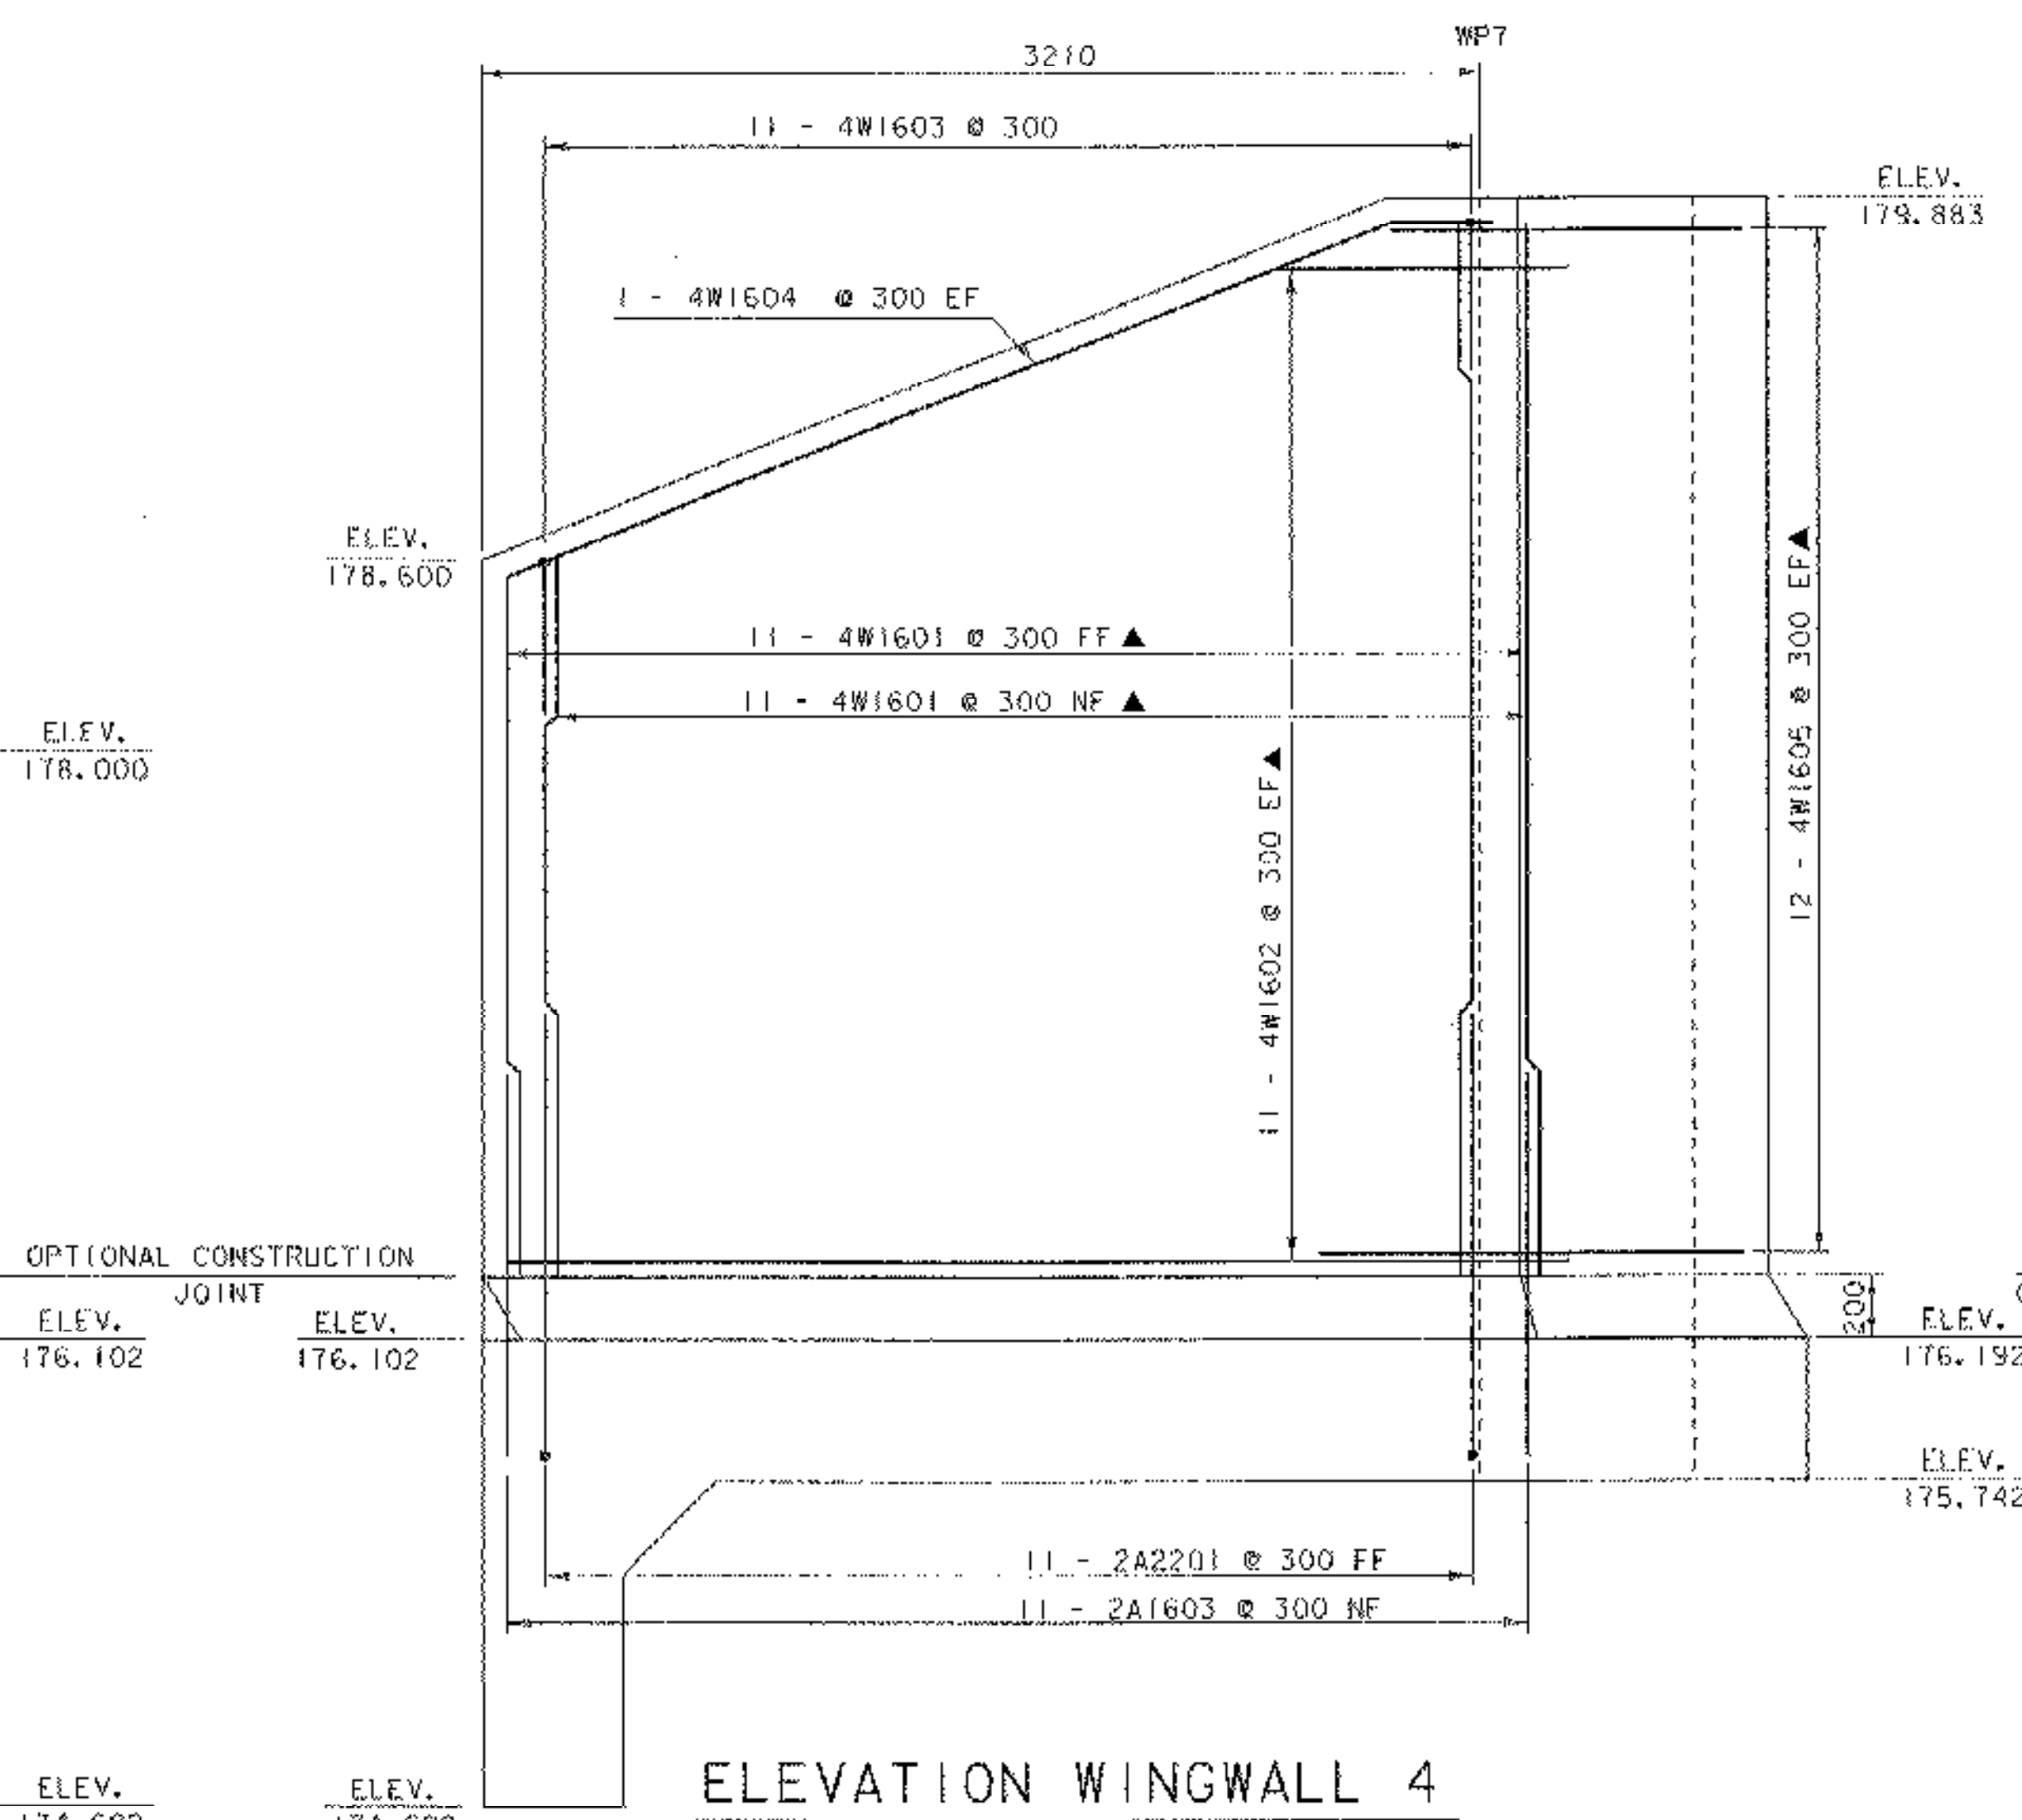

**ELEVATION WINGWALL 4**

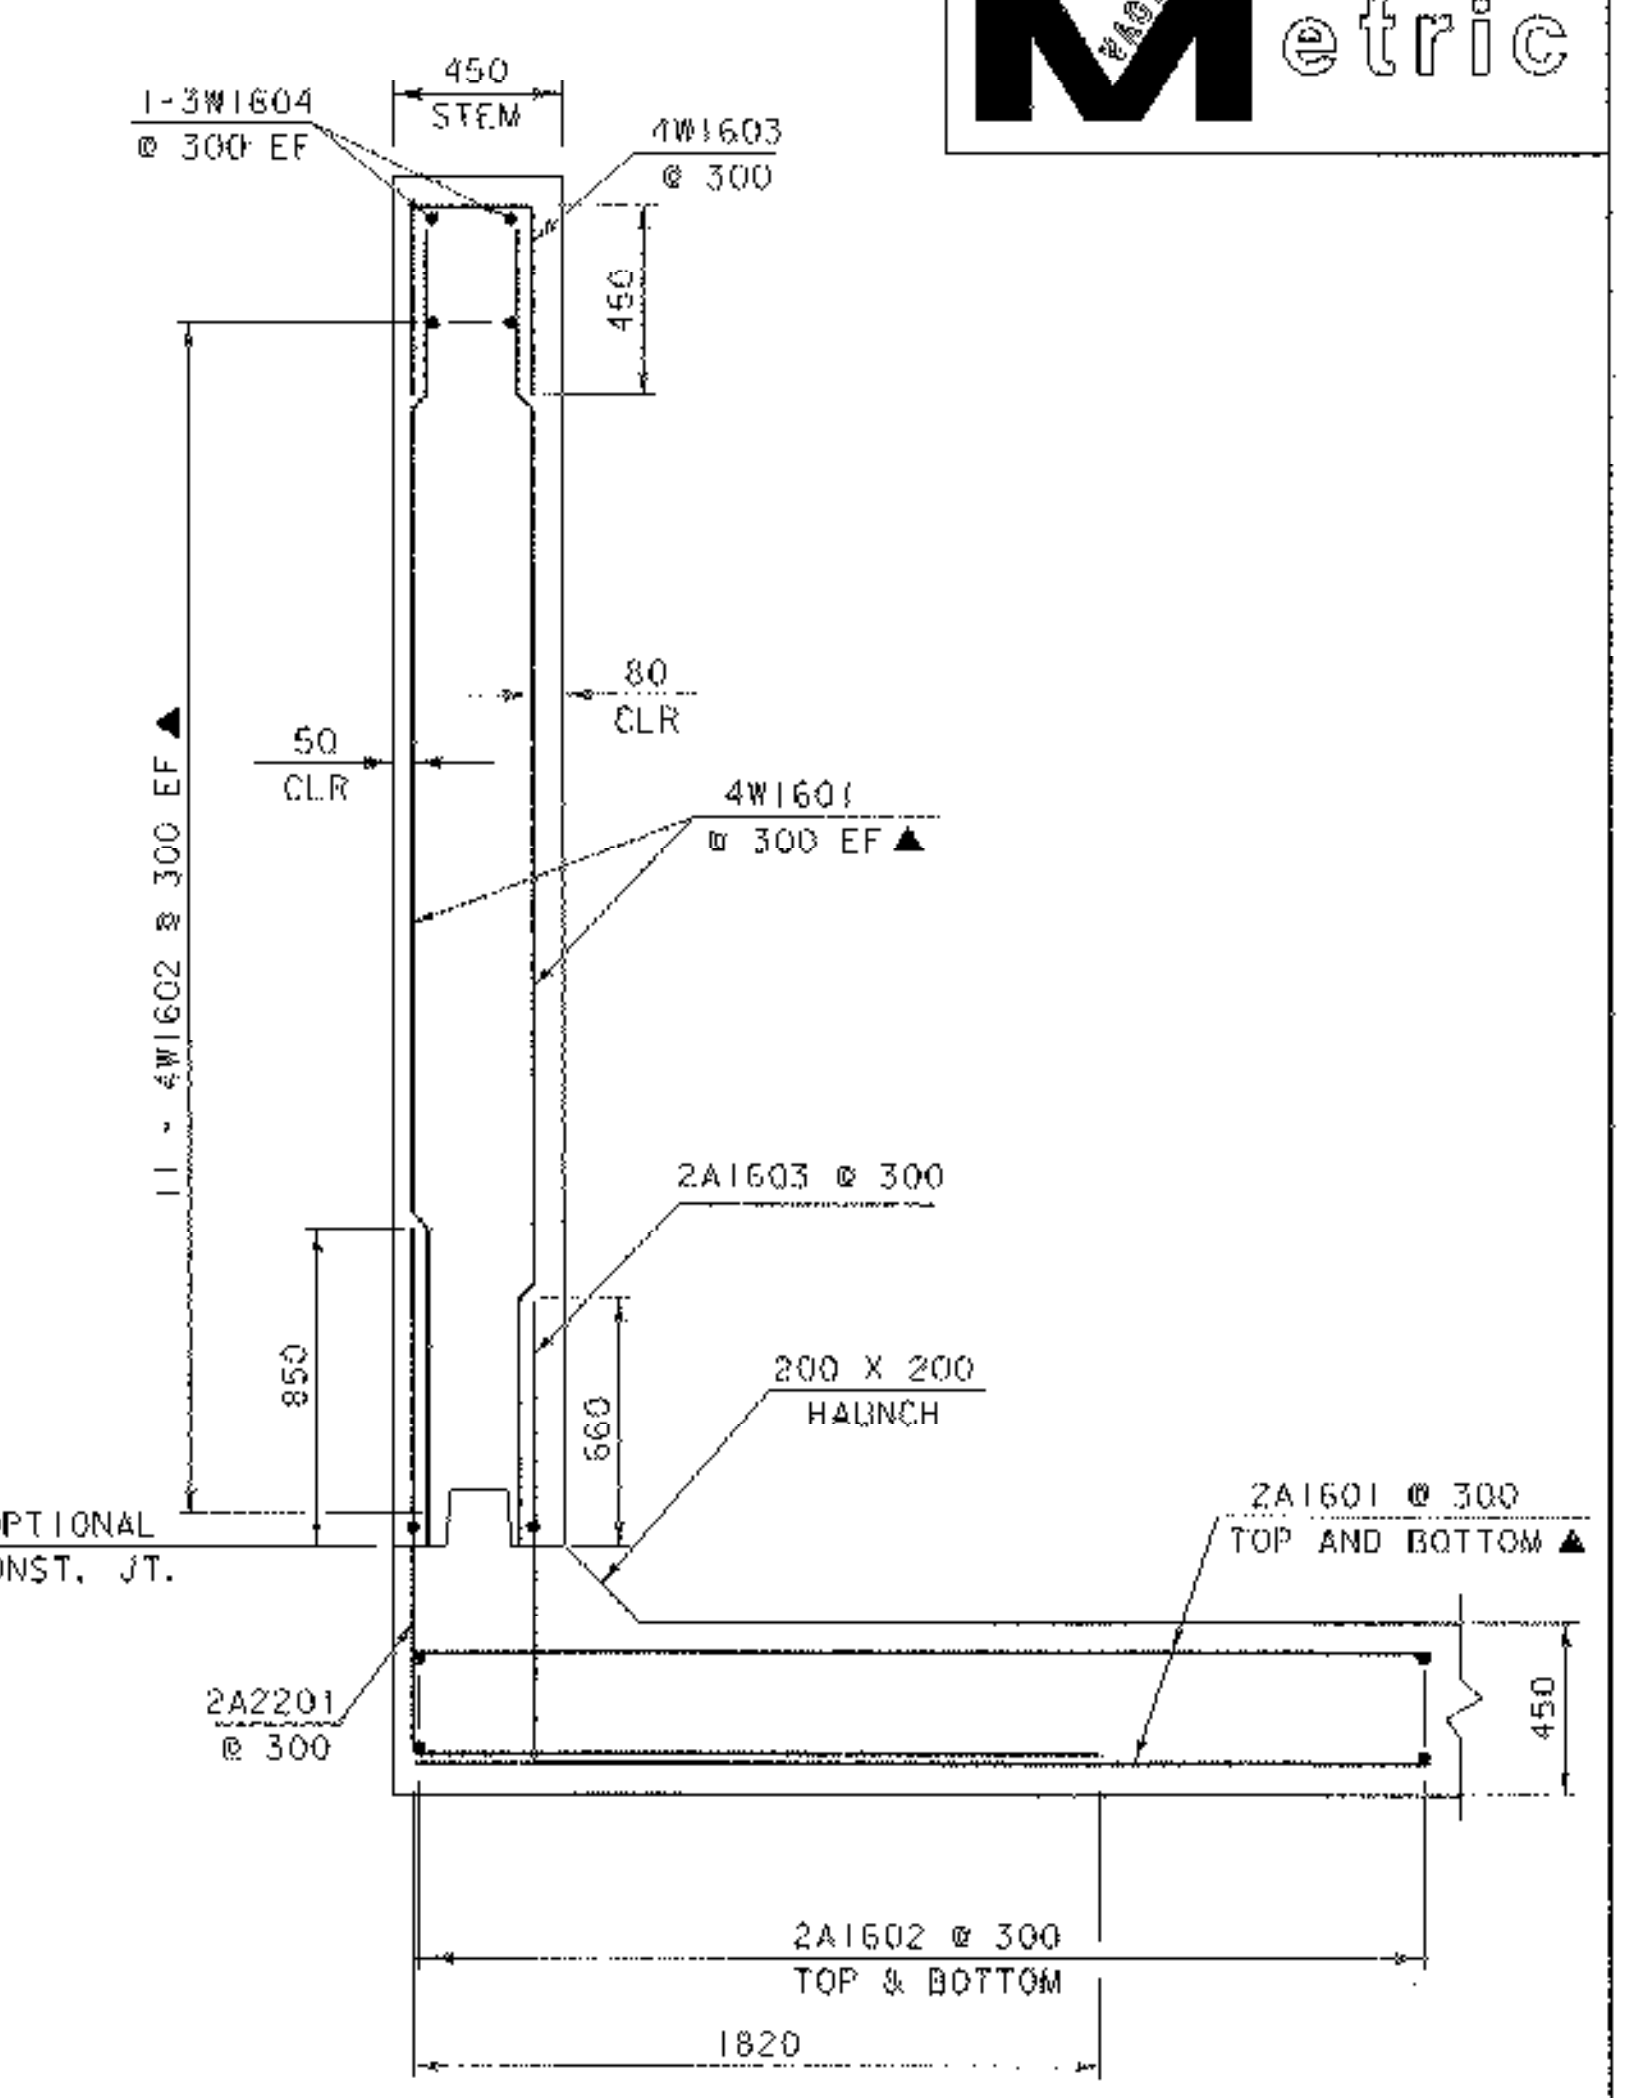


**SECTION A-A**

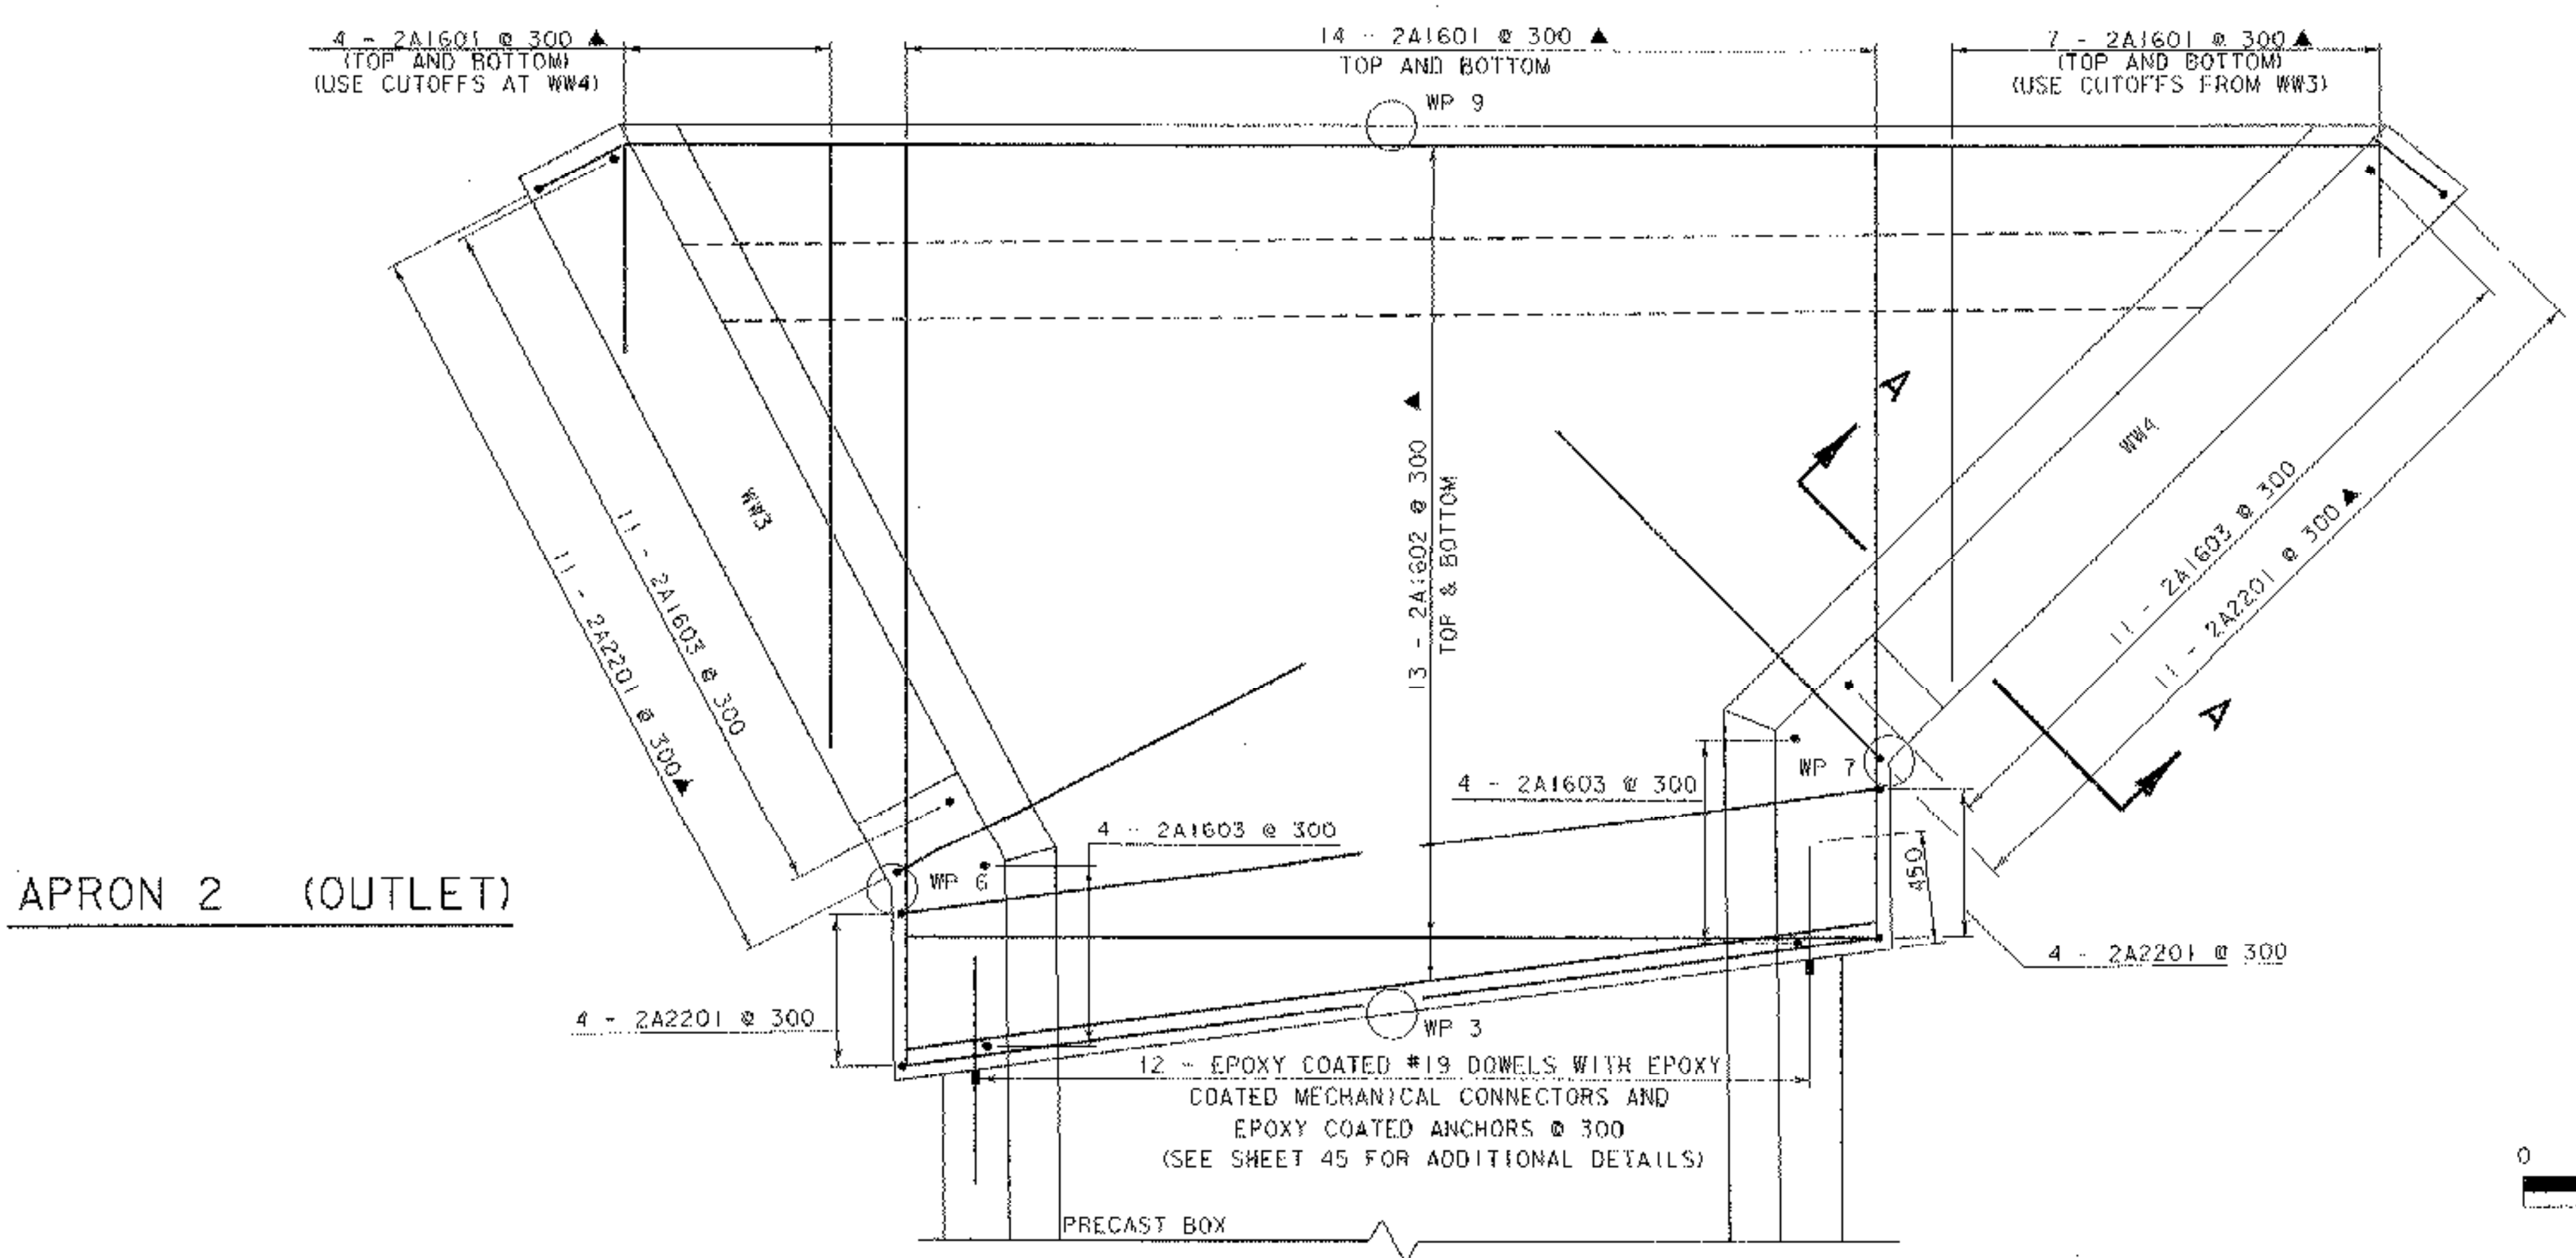

**APRON 2 (OUTLET)**

CHANGED TO PRE-CAST

**NOTE:**  
 NF - NEAR FACE  
 FF - FAR FACE  
 EF - EACH FACE  
 ▲ - CUT TO FIT IN FIELD  
 80 CLR. UNLESS OTHERWISE SPECIFIED ON THE PLANS.

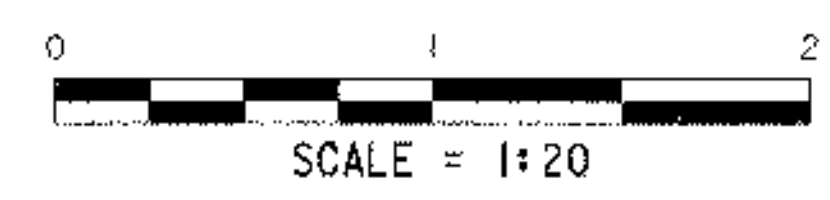

**WINGWALL #3 & #4 DETAILS**

PROJECT NAME:	POWVAL	PLOT DATE:	10-MAY-2007
PROJECT NUMBER:	STP RS 0107 (8)	DRAWN BY:	R. PELLET
FILE NAME:	/846028/str/sc028ww.dgn	CHECKED BY:	T. SUMNER
PROJECT MANAGER:	W. SYMONDS	SHEET	44 OF 65
DESIGNED BY:	T. FILLBACH		
sc028ww2.1			