

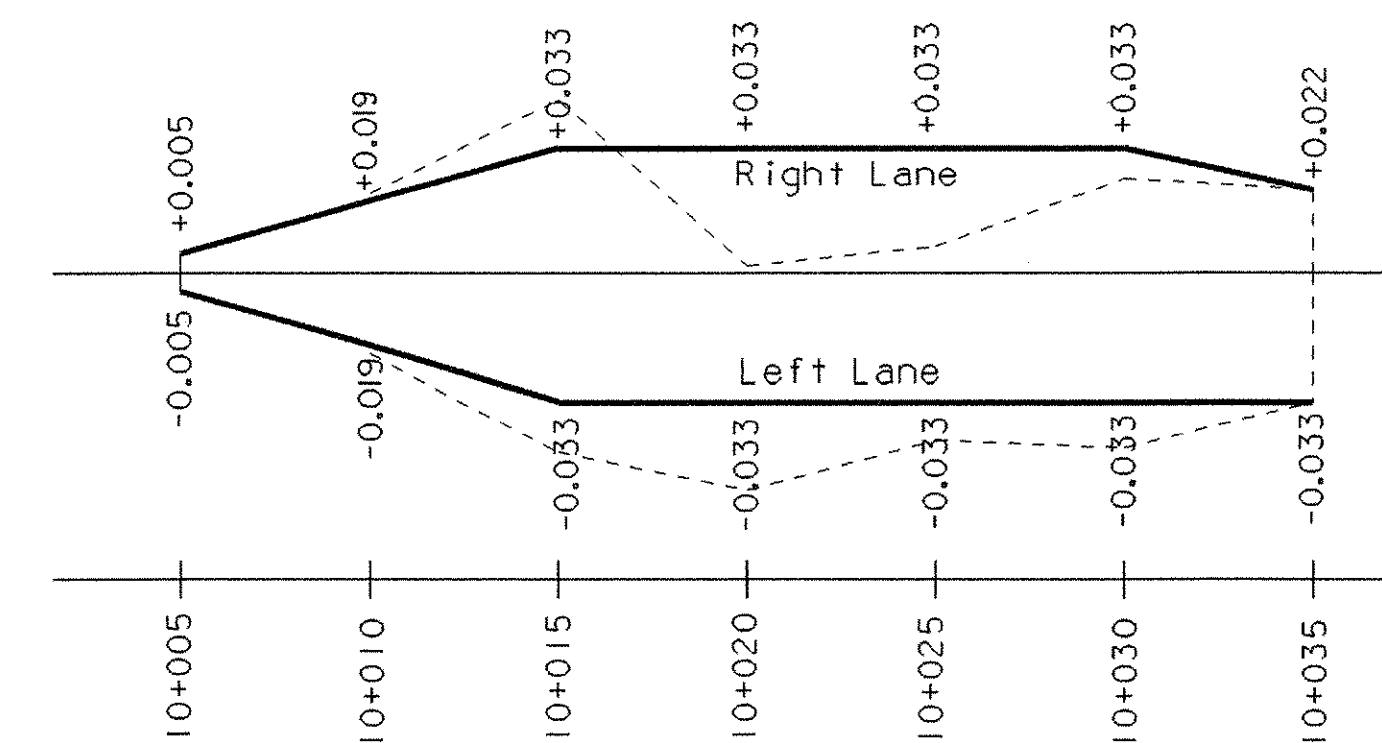



Banking Transition
 Not to Scale

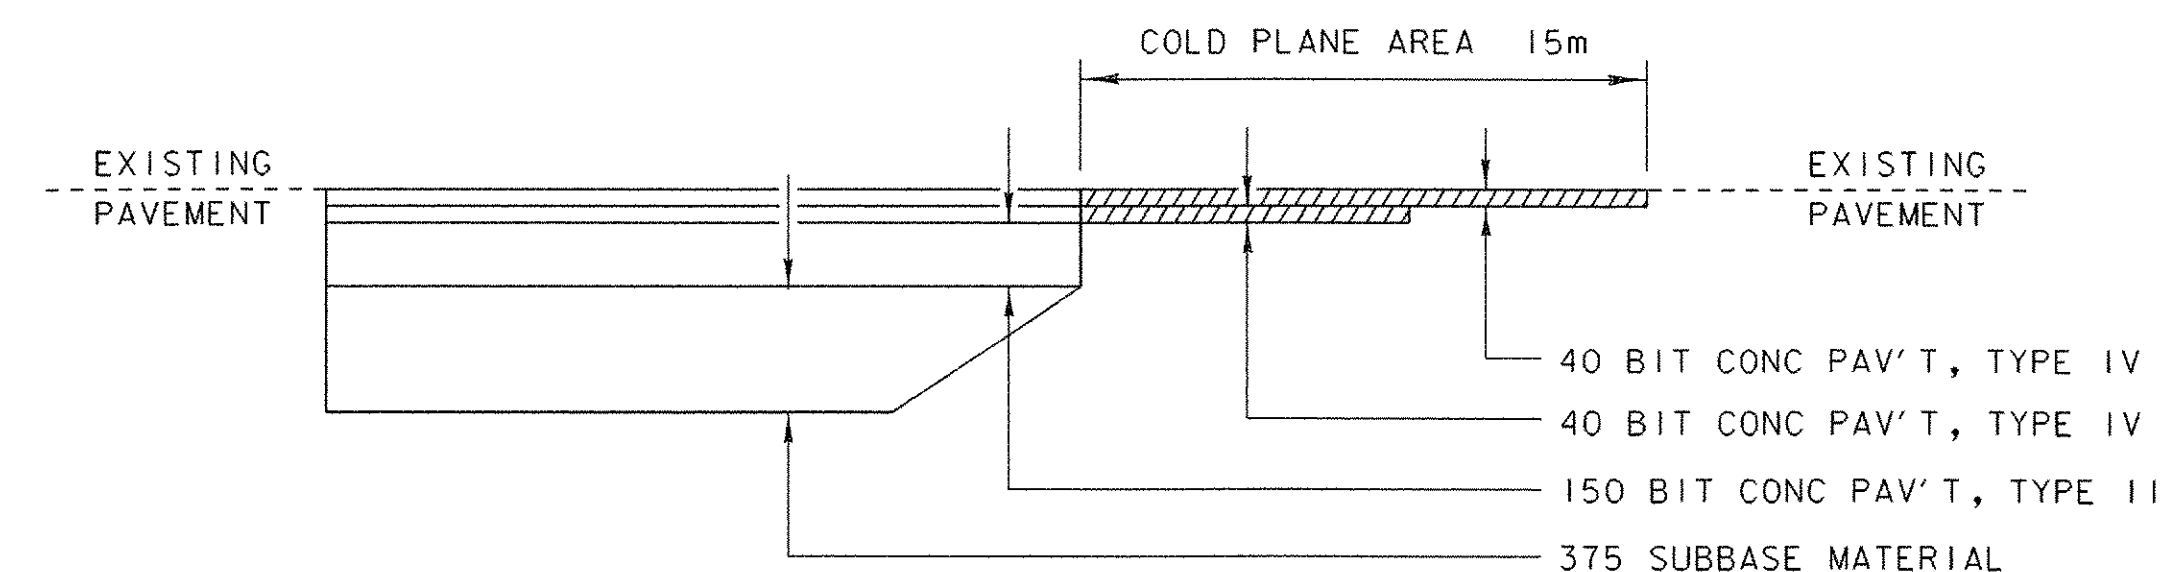

TH56 Banking Transition
 Not to Scale

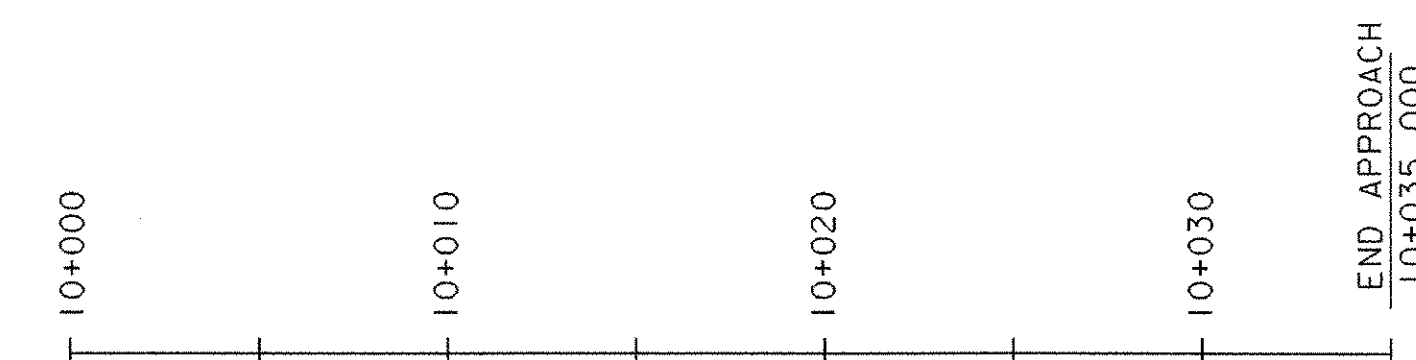

Material Transition Diagram (TH56)
 Not to Scale

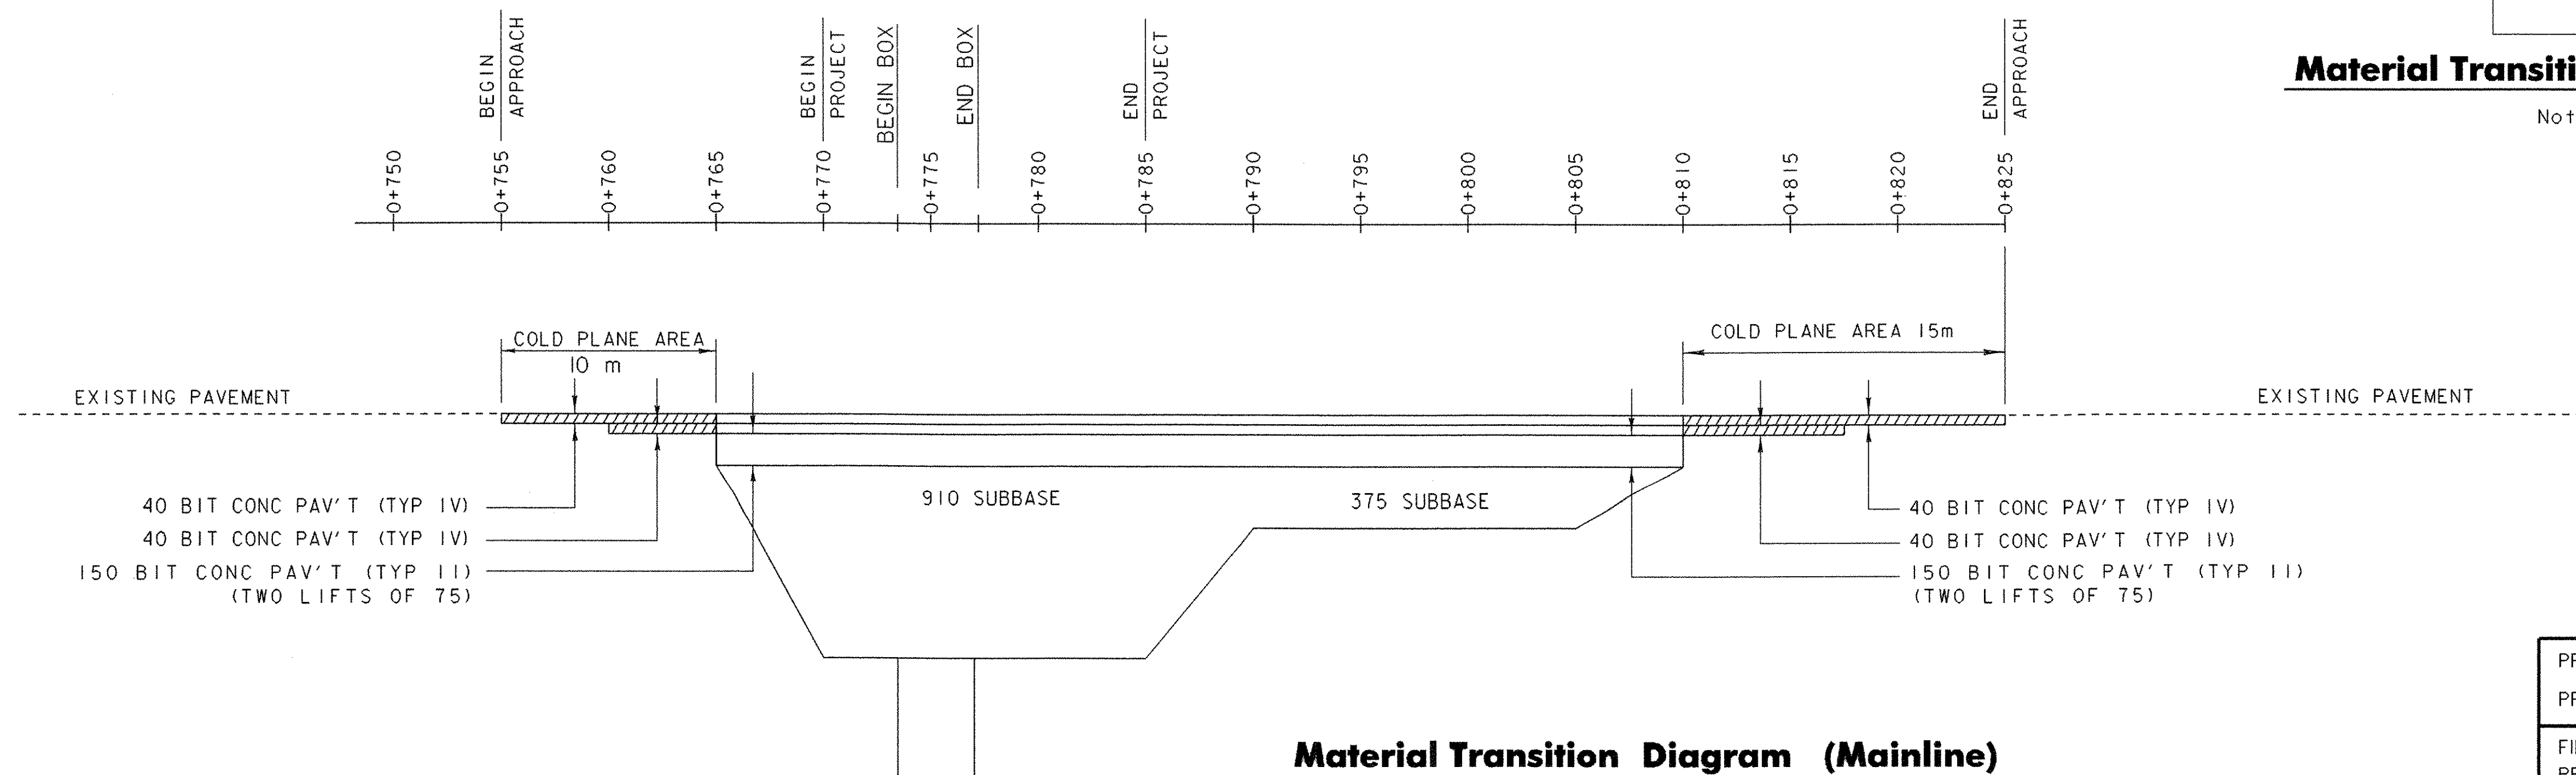

Material Transition Diagram (Mainline)
 Not to Scale

BANKING DIAGRAM & MATERIAL TRANSITIONS

PROJECT NAME: POWNAL
 PROJECT NUMBER: STP RS 0107 (8)

FILE NAME: /84c028/str/sc028xs.dgn PLOT DATE: 10-MAY-2007
 PROJECT LEADER: W. SYMONDS DRAWN BY: K. RUTTER
 DESIGNED BY: G. SHANGRAW CHECKED BY: T. SUMNER
 sc028bnk.j SHEET 52 OF 65