
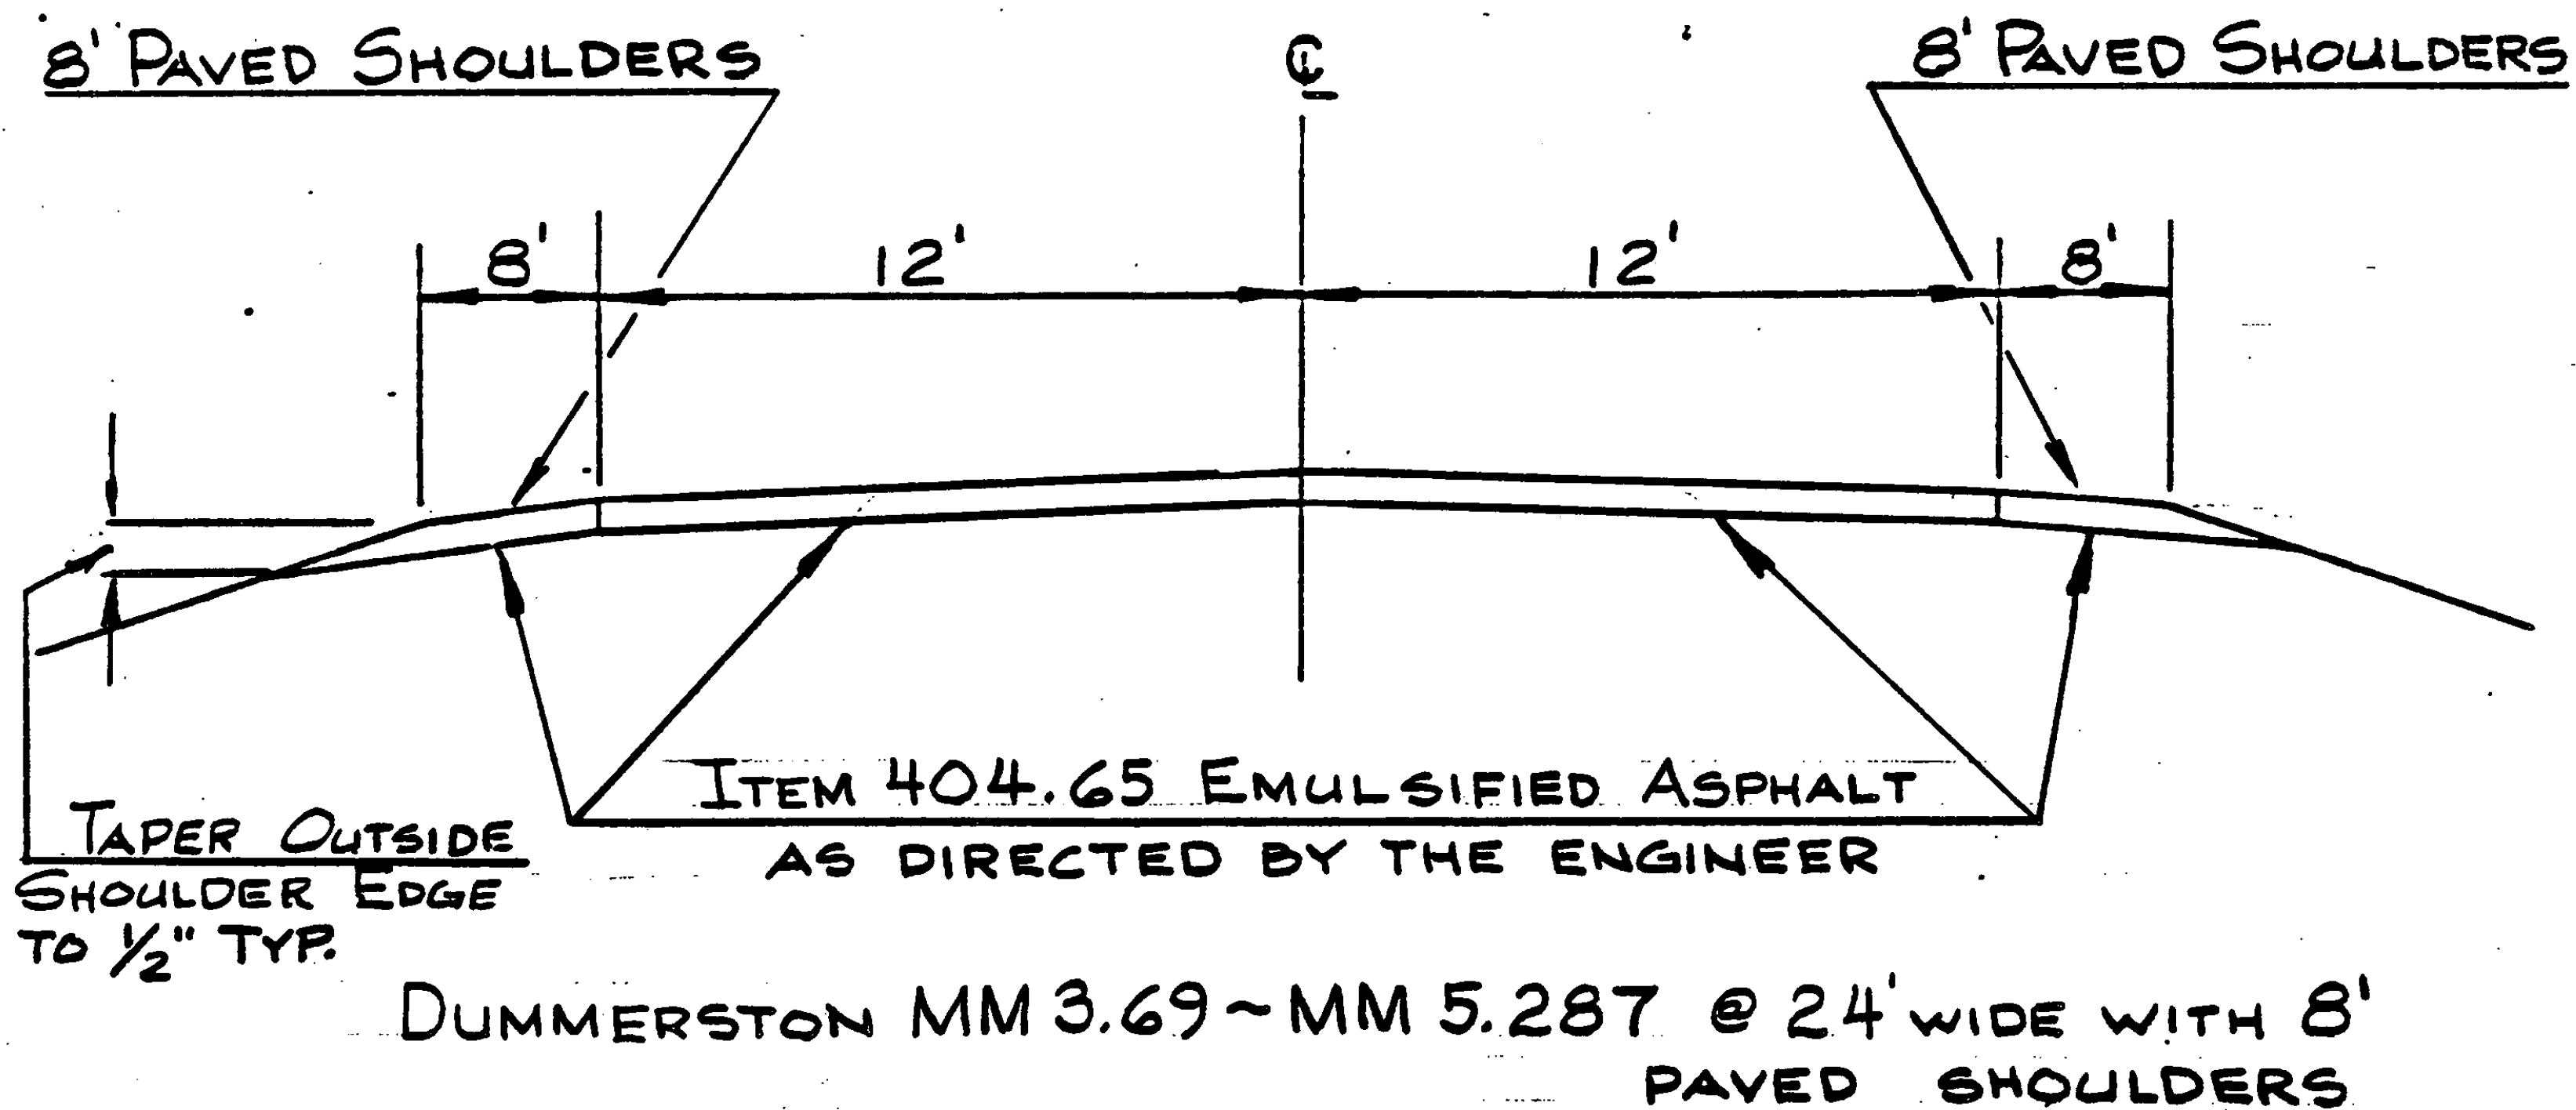


TYPICAL SECTIONS & DESIGN DATA

ITEM 406.25 BITUMINOUS CONCRETE PAVEMENT
 LEVELING COURSE, TYPE III OR IV (24' WIDE @ 164 TONS/Mi.)
 AS DIRECTED BY THE ENGINEER.
 1/4" WEARING COURSE, TYPE III

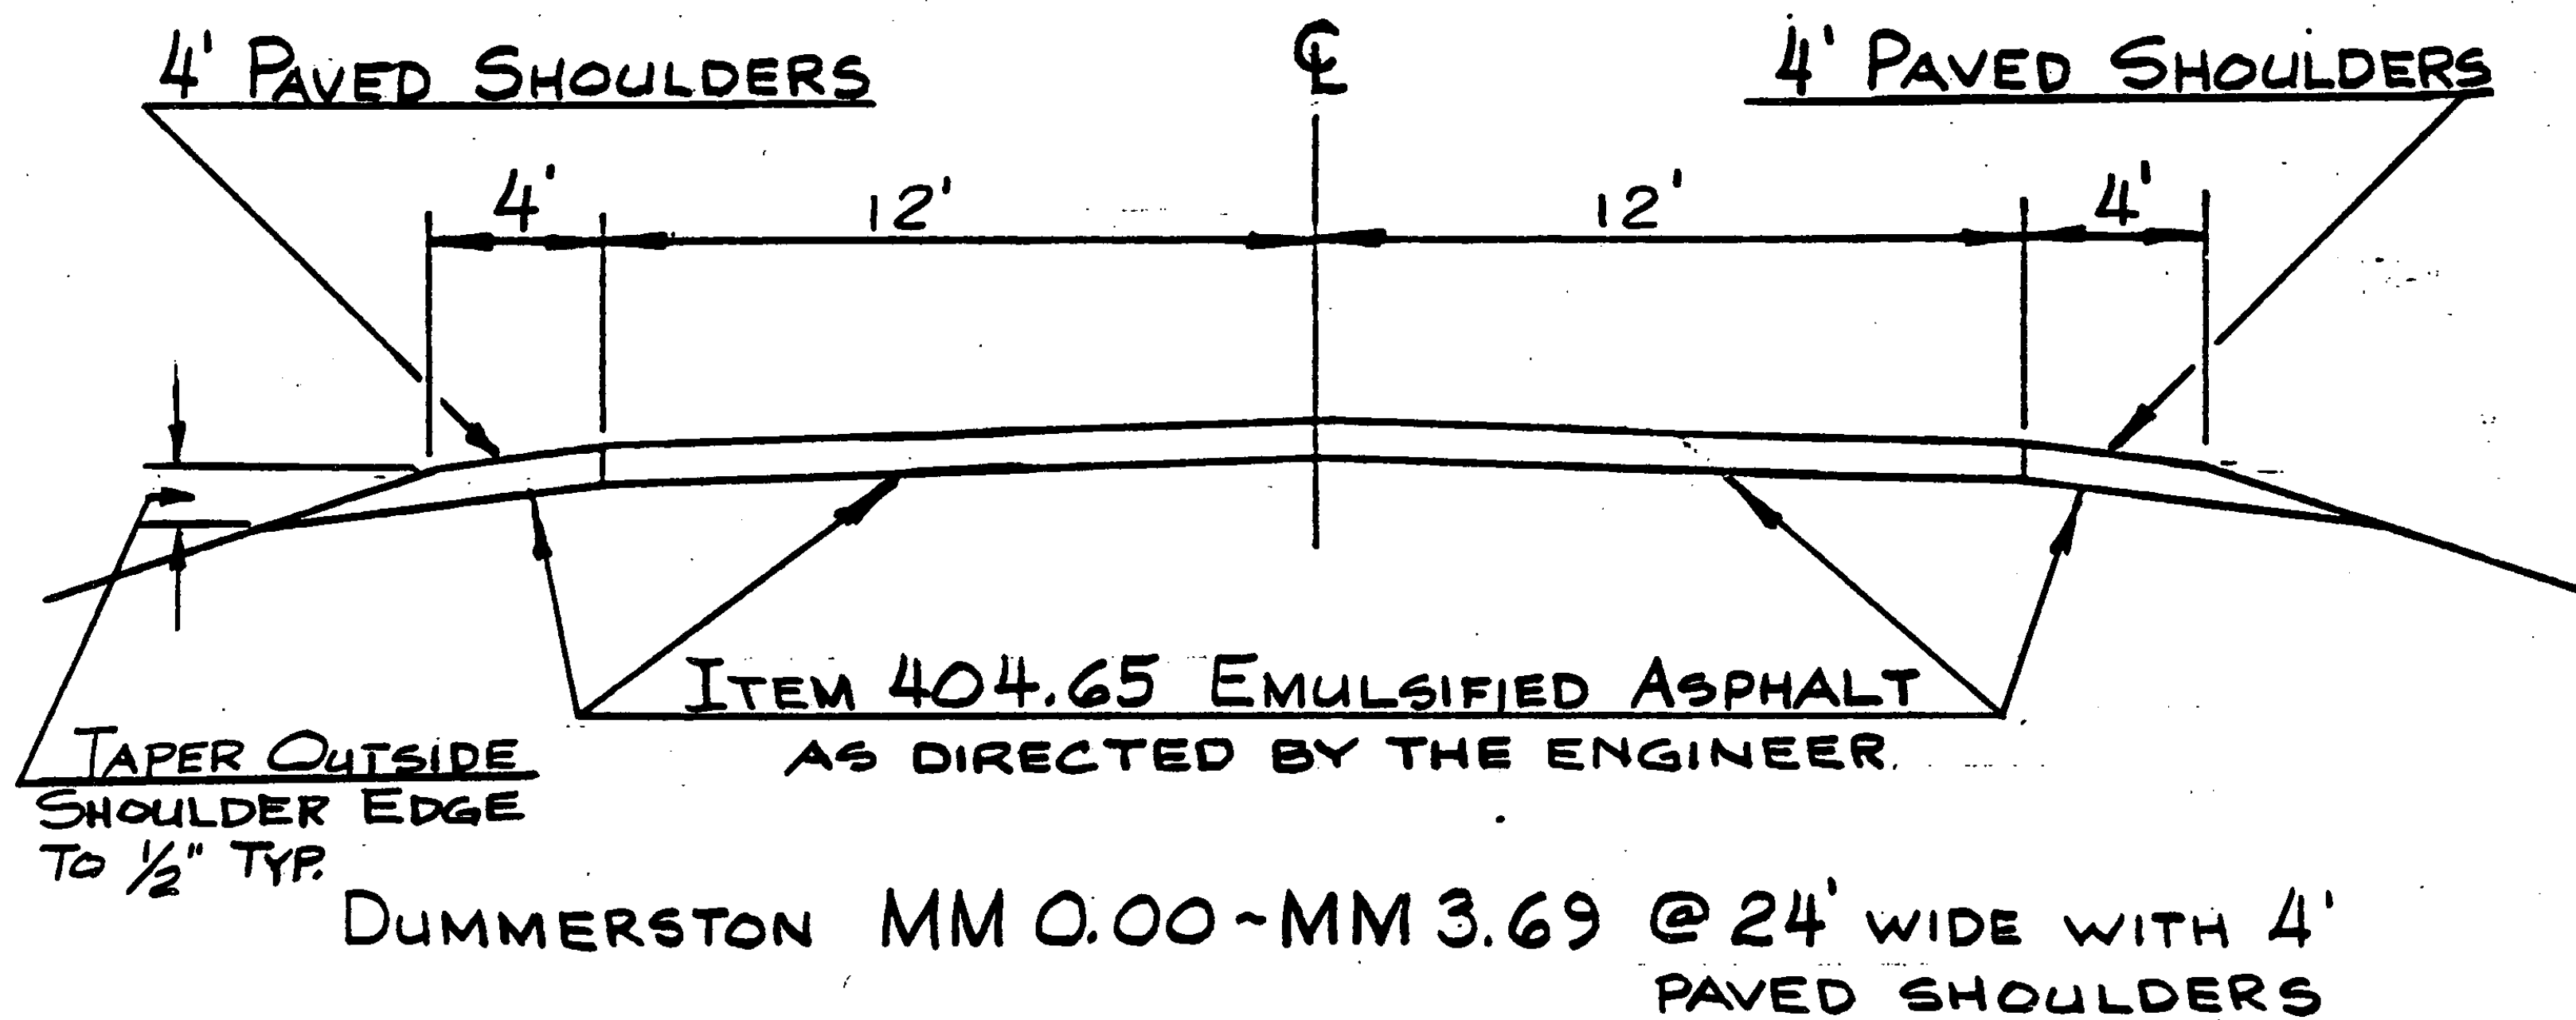

TRAFFIC DATA
 1982 ADT = 3440
 V = 50 MPH

PROJECT DUMMERSTON

NO. RS 0113(37)
 SHEET 12 OF 20