



WALDO LANE & CONST.

Δ	= 61'-33"-01" RT.
D	= 44'-00"-00" RT.
R	= 130.22'
T	= 77.57'
L	= 139.91'
E	= 21.35'

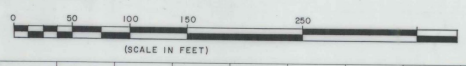

DATUM

VERTICAL	NOVD 1929
HORIZONTAL	VT. STATE PLANE GRID

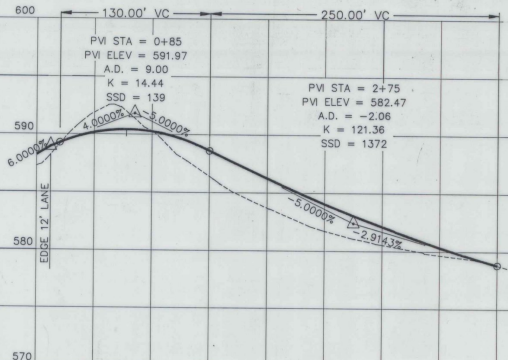

DRAINAGE TABLE

LOCATION	REMARKS
22 0+75~0+78 LT	NEW 6"X4' UNDERDRAIN W/F.B. @ 0+78 LT
23 0+78~2+77 LT	NEW 6"X198' UNDERDRAIN W/F.B. @ 2+77 LT
24 2+55	REMOVE EXISTING 15" CGMP
25 2+62 LT~2+52 RT	NEW 18"X54' PCCSP .064 CAAP .060 RCP CLASS III OR CP/SL W/CRM @ INLET & STONE FILL PAD @ OUTLET
26 2+77 LT~RT	NEW 6"X50' UNDERDRAIN W/OUTLET @ 2+77 RT

07-09-93	REVISION 11
04-21-93	REVISIONS 3, 5, & 7
04-02-93	REVISION 2

THIS SHEET FOR ROW USE ONLY

SURVEYED BY	V.S.C.	DATE	07/90
DRAWN BY	FJC	DATE	04/92
TRACED BY	JAC/SAS	DATE	01/93

WALLINGFORD
BRS 0137 (13)
R.O.W. SHEET 7 OF 9 SHEETS