
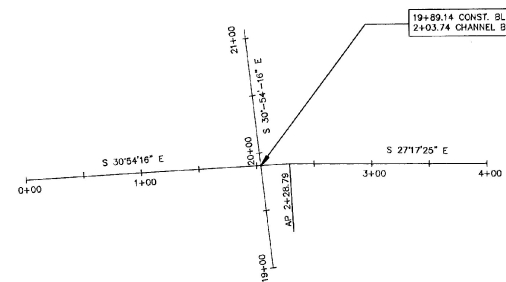
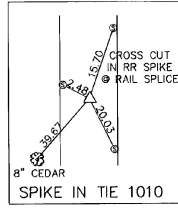
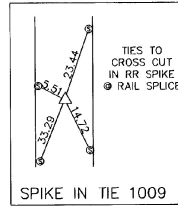
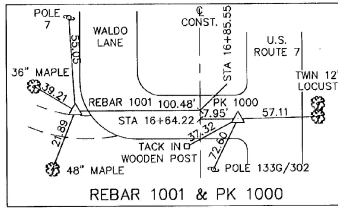
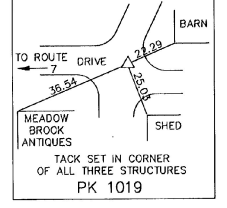
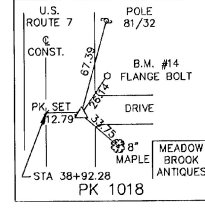
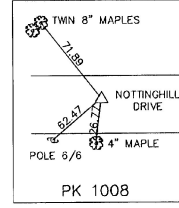
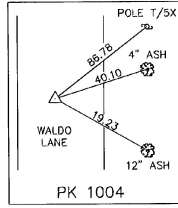
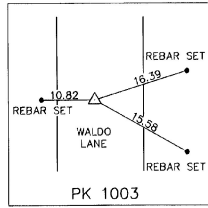
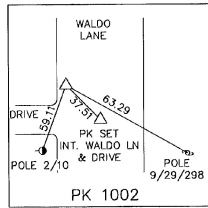
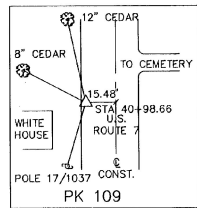
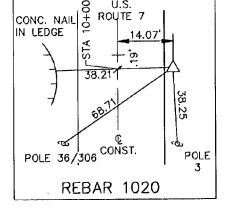
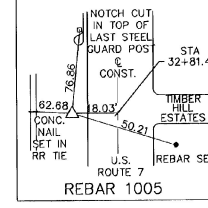
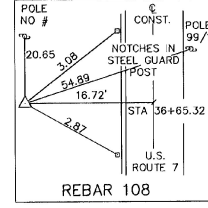
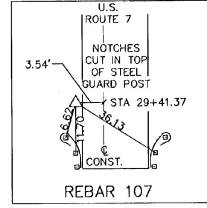
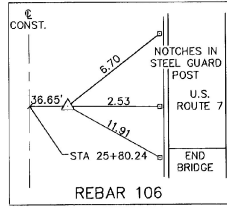
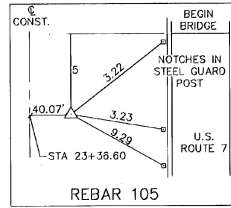


SURVEY BASELINE TIES

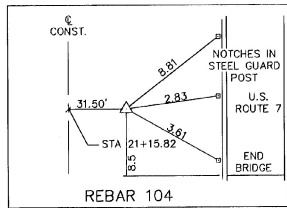

SURVEY BASELINE TIES

SURVEYED BY: VSC DATE 07/99
 DRAWN BY: JAC DATE 11/94
 TRACED BY: JAC DATE 11/94
 WALLINGFORD
 PROJ. BRS NO. 0137(13)
 SHEET 19 OF 113 SHEETS