

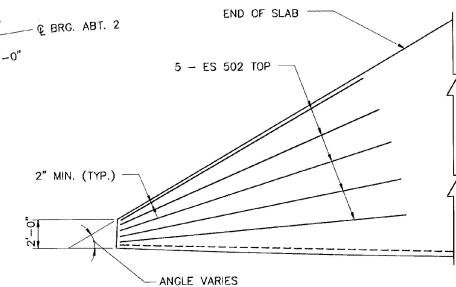
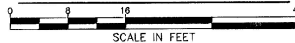



BRIDGE DECK REINFORCING PLAN

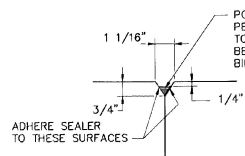


ADDITIONAL SLAB REINFORCEMENT AT ACUTE CORNERS

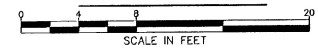


DETAIL A
NOT TO SCALE

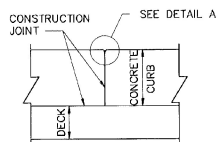

SECTION 1-1
NOT TO SCALE

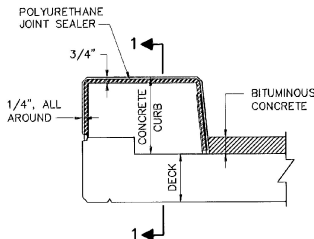

TYPICAL SECTION THROUGH
CONCRETE CURB CONSTRUCTION JOINT
NOT TO SCALE

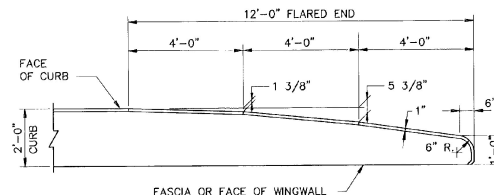

FLARED END DETAIL FOR 2'-0" CURB
SCALE IN FEET

NOTE:

- FOR CURB CONSTRUCTION JOINT AND BRIDGE RAILING POST LOCATION, SEE SHEET BR209.

STATE OF VERMONT
AGENCY OF TRANSPORTATION

Town Of	WALLINGFORD	Bridge No.	80
Highway No.	U.S. ROUTE 7	Log. Sta.	
		Surv. Sta.	
U.S. ROUTE 7 OVER RAILROAD BRIDGE DECK REINFORCING PLAN			
Designed By	GRI	Drawn By	RJL
Checked By	EMM	Date	4/95
		Bridge Design Supervisor	EMM
		Date	4/95
PROJECT	WALLINGFORD	PROJECT NO.	BRS 0137 (13)
I.G.C. Info.			
Bridge Sheet No.	BR208	Sheet	68 of 113



BARNES AND JARNIS, INC.
CONSULTING ENGINEERS
25 STUART STREET, 6TH FL.
BOSTON, MASSACHUSETTS