
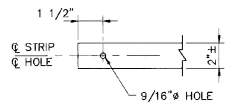


ABUTMENT NO. 2 - WALL LAYOUT
(REINFORCING STRIPS BELOW ABUT. SEAT)

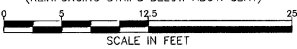

REINFORCING STRIP DETAIL
NTS

STATE OF VERMONT
AGENCY OF TRANSPORTATION

Town Of	WALLINGFORD	Bridge No.	80
Highway No.	U.S. ROUTE 7	Log. Sta.	
U.S. ROUTE 7 OVER RAILROAD			
MSE WALL - ABUT. NO. 2 BIN. WALL			
Designed By	LJW	Drawn By	REC
Checked By	AJP	Date	10/94
		Bridge Design Supervisor	EMM Date 4/95
PROJECT	WALLINGFORD	PROJECT NO.	BRS 0137 (13)
I.C.C. Info.		Bridge Sheet No.	BR229
		Sheet	89 of 113

B&J BARNES AND JARNIS, INC.
CONSULTING ENGINEERS
25 STUART STREET, 8TH FL.
BOSTON, MASSACHUSETTS