


BEGIN PROJECT  
15+00 END APPROACH

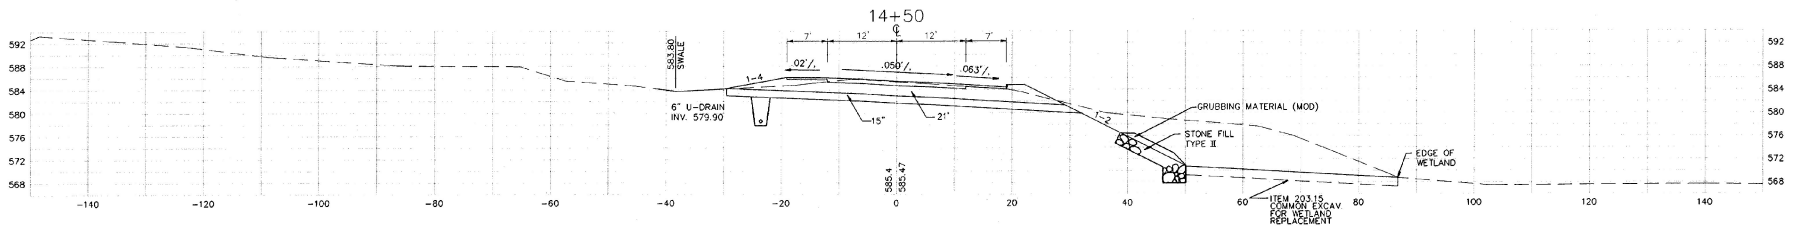

STA. 14 + 20 RT  
BEGIN WETLAND RESTORATION

SCALE 10 FEET

MAINLINE	
FROM STATION	TO STATION
14+50	16+00
PROJ. NAME WALINGE08D	
PROJ. NO. BRS-0137(13)	
SURVEYED BY: JSC-07/90	
PLOTTED BY: JAC-02/95	
SHEET 99 OF 113 SHEETS	