


		FED. ROAD DIST. NO.	STATE	FED. AID PROJ. NO.	
			VT		
BILL OF MATERIAL					
NO.	MARK	DESCRIPTION	LENGTH	REMARKS	ITEM
ONE	G5A	GIRDER			
1	c	PL 39 x 1/2	32 3/4	(1)	
1	b	PL 39 x 1/2	69 8 1/2	(1)	
1	c	PL 18 x 1	68	4	
1	d	PL 18 x 1	33 7 1/2		
1	f	PL 18 x 1 1/8	20 11 1/8	(1)	
1	g	PL 18 x 2	60	0	(1)
1	h	PL 18 x 1 1/8	20 11 1/8	(1)	
4	x1o	PL 8 1/2 x 3/8	3	3	
1	x1g	PL 39 x 1/2	1	0 1/2	BENT
1	x1s	PL 39 1/2 x 1/2	1	1 1/8	BENT
1	x1bg	PL 39 x 1/2	1	0 1/2	BENT
1	x1bs	PL 39 1/2 x 1/2	1	1 1/8	BENT
2	x1w	BAR 8 x 1/2	3	3	
3	x1y	BAR 8 x 1/2	3	3	
1	x1ob	BAR 8 x 1/2	3	3	
1	x1oc	BAR 8 x 1/2	3	3	
1	x1of	BAR 8 x 1/2	3	3	
1	x1ol	BAR 8 x 1/2	3	3	
1	x1ok	BAR 8 x 1/2	3	3	

TOTAL WEIGHT THIS DWS.
ITEM 506.55 = 24,956.00

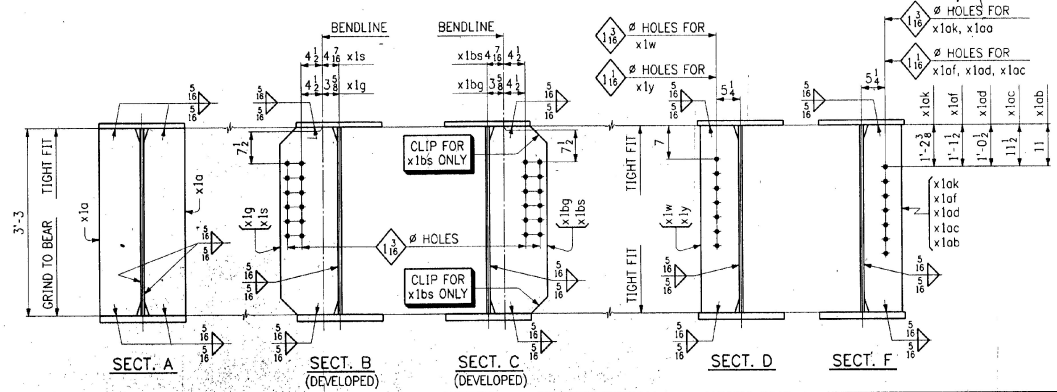

PAINT LIGHT RUST PREVENTIVE
COAT OF PRIMER (FS),
EDGES & SHADED AREA (NS)

RECEIVED
DEC 27 1955
REGISTRY

SHOP NOTE
HOLES: 1/8" (UN)
BOLTS: NONE
PAINT: AS NOTED, SEE DWG. N1
FOR GENERAL SHOP NOTES, SEE DWG. N1.
FOR WEB CAMBER DIAGRAM, SEE DWG. WC1.

NO.	REVISION	DATE

NO. 1770 Homestead Road
Lancaster, Pa. 17605-0008
Phone 717-298-5211
A Division of High Industries, Inc.

CONTRACTOR: J. A. McDONALD, INC.
PROJECT NO. BRS-0137(13)
STATE CONTRACT OR REF. NO.
IN CHARGE: abs
MADE PPF 2-15 CMCD BY FM
DATE: 2-21-96
CONTRACT NUMBER: VT-95368
DRAWING NUMBER: 8 OF 9

CODE: 30