
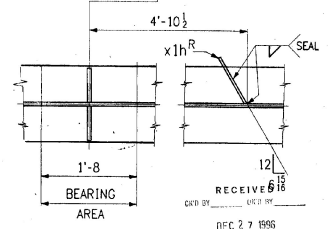
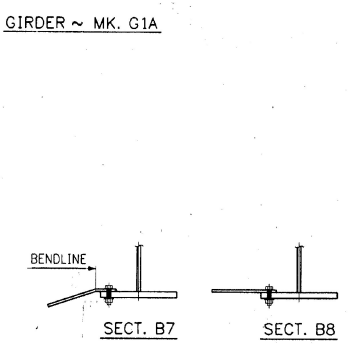
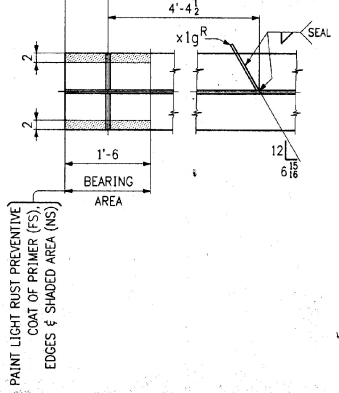
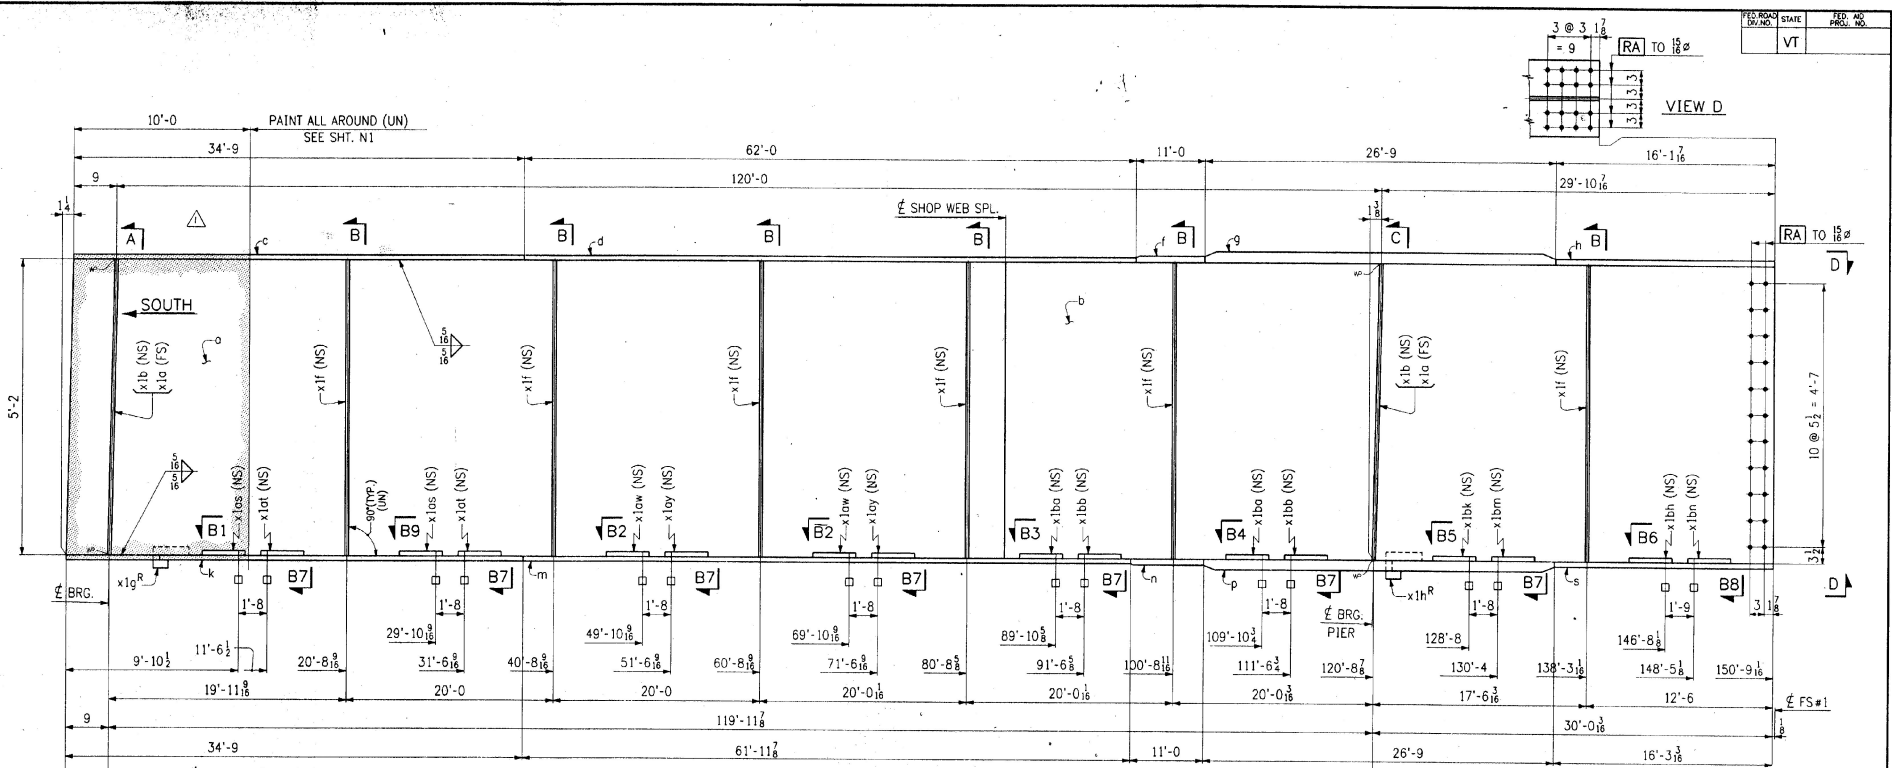


FED. ROAD DIST. NO.	STATE	FED. AC. PROJ. NO.
	VT	

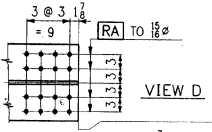

NO.	REVISION	DATE
△	DELETED SECT. P : DESIGN CHANGE	5-20-94
HIGH STEEL STRUCTURES, INC. 1770 Hempstead Road, Bensalem, Pa. 17605-0008, Phone 717/269-5211		
GIRDER G1A		
U.S. ROUTE 7 OVER OTTER CREEK		
BRIDGE NO. 79		
TOWN OF WALLINGFORD, COUNTY OF RUTLAND		
STATE OF VERMONT		
AGENCY OF TRANSPORTATION		
STATE CONTRACT OR REF. NO.	PROJECT NO. BRS-0137(13)	
CONTRACTOR	J. A. McDONALD, INC.	
IN CHARGE	abs	DATE 2-2-96
CONTRACT NUMBER	VT-95367	DRAWING NUMBER 5 OF 24

WORK THIS DWG. WITH DWG. 6