
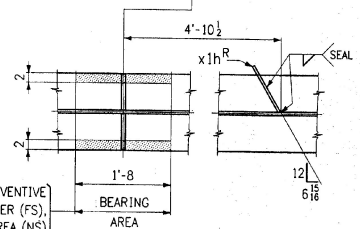
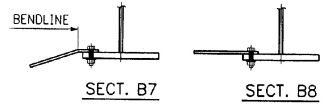
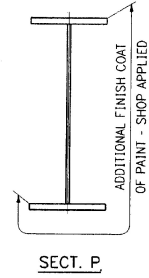


GIRDER ~ MK. G1A

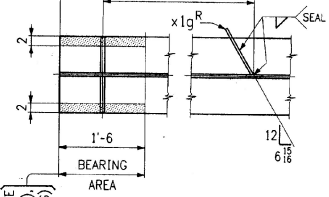

SHOP DRAWING REVIEW	
REVIEWED FOR GENERAL COMPLIANCE WITH CONTRACT SPECIFICATIONS AND RESPONSIBILITY FOR ACCURACY OF DIMENSIONS AND DETAILS	DATE
DESIGNED BY	
CHECKED BY	
APPROVED BY	
DATE	

Barra and Jernst, Inc.
 100 MAR 27 1996

WORK THIS DWG. WITH DWG. 6

CODE: 30

NO.	REVISION	DATE
HIGH STEEL STRUCTURES, INC. 1770 Hempstead Road Lancaster, PA 17606-0008 Phone 717/299-5211 <i>A Division of High Industries, Inc.</i>		
GIRDER U.S. ROUTE 7 OVER OTTER CREEK BRIDGE NO. 79 TOWN OF WALLINGFORD, COUNTY OF RUTLAND STATE OF VERMONT AGENCY OF TRANSPORTATION PROJECT NO. BRS-0137(13)		
STATE CONTRACT NO. _____ CONTRACTOR J. A. McDONALD, INC. IN CHARGE: abs MADE PPF 1-31-97 BY: L.D. DATE: 2-2-96 CONTRACT NUMBER: VT-95367 DRAWING NUMBER: 5 OF 24		