


BILL OF MATERIAL						
NO.	MARK	DESCRIPTION	LENGTH	REMARKS	ITEM	QTY
ONE	G4B	GIRDER				29020
1	a	PL 62 x 3/8	65	(T)	2	4
1	b	PL 62 x 3/8	42	11 1/2 (T)	2	5
1	c	PL 16 x 1 1/2	72	11 1/2 (T)	2	13
1	d	PL 16 x 1 1/2	35	6 (T)	2	14
1	e	PL 16 x 1 1/2	72	9 (T)	2	13
1	f	PL 16 x 1 1/2	35	6 (T)	2	14
2	x1k	PL 58 x 3/8	1	1 (T)	3	6
2	x1m	PL 16 x 3/8	2	1 (T)	3	6
4	x1n	BAR 7 x 1/2	2	1 (T)	3	2
2	x1b	BAR 7 1/2 x 3/4	5	2	3	12
10	x1f	BAR 7 1/2 x 1/2	5	2	3	14

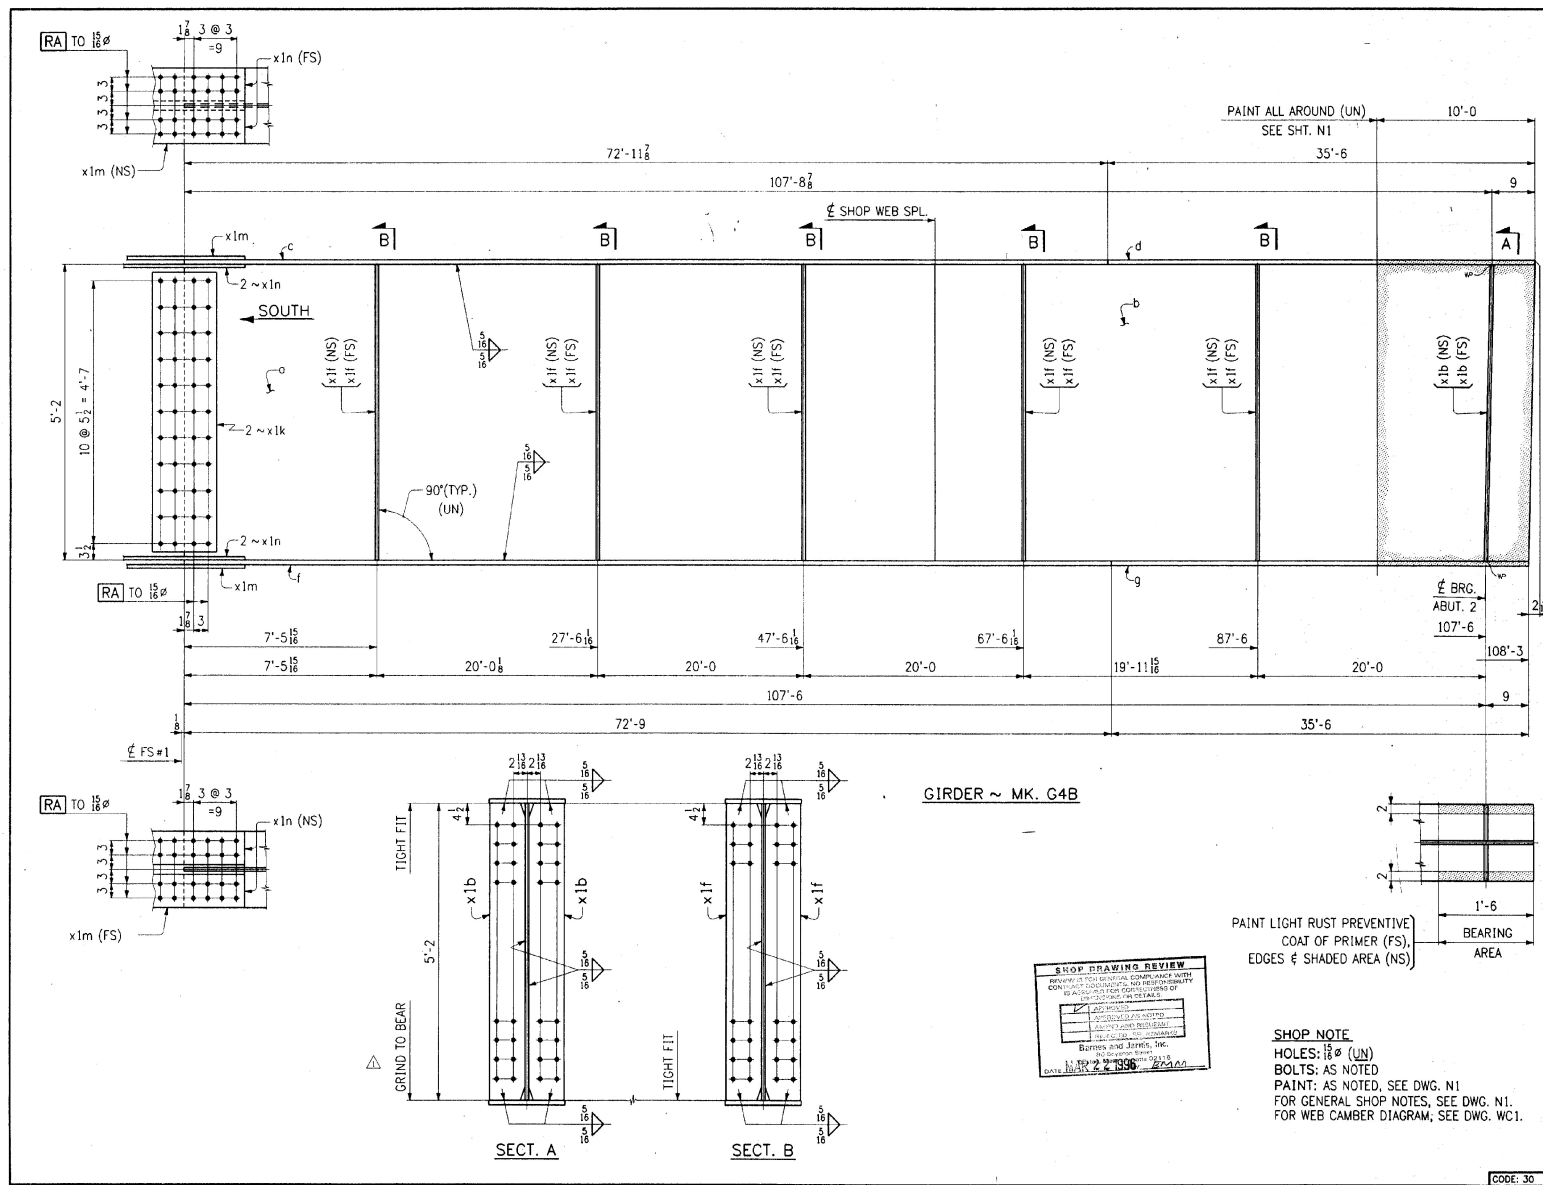

GIRDER ~ MK. G4B



PAINT LIGHT RUST PREVENTIVE  
 COAT OF PRIMER (FS),  
 EDGES & SHADED AREA (NS)

SHOP NOTE  
 HOLES: 1/8" (UN)  
 BOLTS: AS NOTED  
 PAINT: AS NOTED, SEE DWG. N1  
 FOR GENERAL SHOP NOTES, SEE DWG. N1.  
 FOR WEB CAMBER DIAGRAM, SEE DWG. WC1.

NO.	REVISION	DATE
1	CHANGED "MILL" TO "GRIND"	2-21-96

HIGH STEEL STRUCTURES, INC.		1770 Hempstead Road Lancaster, PA 17605-0008 Phone 717/298-5211 A Division of High Industries, Inc.	
GIRDER		G4B	
U.S. ROUTE 7 OVER OTTER CREEK			
BRIDGE NO. 79			
TOWN OF WALLINGFORD, COUNTY OF RUTLAND			
STATE OF VERMONT			
AGENCY OF TRANSPORTATION			
PROJECT NO. BRS-0137(13)			
STATE CONTRACT OR REF. NO.	CONTRACTOR J. A. McDONALD, INC.		
IN CHARGE: abs	DATE: 2-3-96	BY: [Signature]	DATE: 2-3-96
CONTRACT NUMBER: VT-95367	DRAWING NUMBER: 20 OF 24		

CODE: 30