

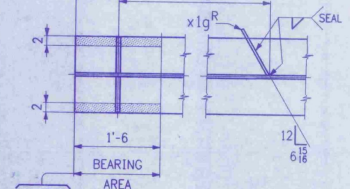



GIRDER ~ MK. G1A

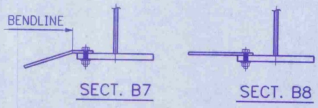

PAINT LIGHT RUST PREVENTIVE
COAT OF PRIMER (FS)
EDGES & SHADED AREA (NS)

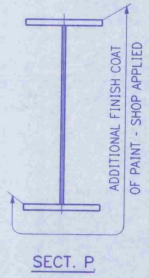

PAINT LIGHT RUST PREVENTIVE
COAT OF PRIMER (FS)
EDGES & SHADED AREA (NS)

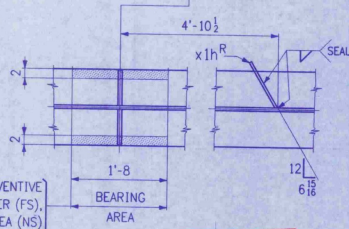

SHOP DRAWING REVIEW
REVIEWED FOR GENERAL COMPLIANCE WITH
CONTRACT REQUIREMENTS. NO RESPONSIBILITY
IS ASSUMED FOR CORRECTIONS OF
CONSTRUCTION DETAILS.
DATE: 2-2-96
BY: [Signature]
Barrett and Jarrett, Inc.
MAR 2 2 1996

WORK THIS DWG. WITH DWG. 6

NO.	REVISION	DATE
<p>HIGH STEEL STRUCTURES, INC. 1770 Haverhill Road Lancaster, PA 17605-0008 Phone 717/299-5211 A Division of High Industries, Inc.</p>		
<p>GIRDER G1A U.S. ROUTE 7 OVER OTTER CREEK BRIDGE NO. 79 TOWN OF WALLINGFORD, COUNTY OF RUTLAND STATE OF VERMONT AGENCY OF TRANSPORTATION</p>		
<p>STATE CONTRACT OR REF. NO. PROJECT NO. BRS-0137(13) CONTRACTOR J. A. McDONALD, INC. IN CHARGE abs MADE PPP BY LJD DATE 2-2-96 DRAWING NUMBER VT-95367 DRAWING NUMBER 5 OF 24</p>		