


BILL OF MATERIAL

NO.	MARK	DESCRIPTION	LENGTH	REMARKS	ITEM
ONE	G2A	GIRDER			41170
1	a	PL 62 x 3/8	88 9	(T)	2 1
1	b	PL 62 x 3/8	62 0 1/2	(T)	2 2
1	c	PL 16 x 1/2	34 9	(T)	2 18
1	d	PL 16 x 1/2	62 0 1/2	(T)	2 17
1	f	PL 16 x 1 1/4	11 0	(T)	2 11
1	g	PL 16 x 2 1/4	26 9	(T)	2 9
1	h	PL 16 x 1 1/2	16 1 1/2	(T)	2 15
1	k	PL 16 x 1/2	34 9	(T)	2 18
1	m	PL 16 x 1/2	62 0	(T)	2 17
1	n	PL 16 x 1 1/4	11 0	(T)	2 11
1	p	PL 16 x 2 1/4	26 9	(T)	2 9
1	s	PL 16 x 1 1/2	16 3/8	(T)	2 15
4	x1b	BAR 7/8 x 1/2	5 2		3 12
12	x1f	BAR 7/8 x 1/2	5 2		3 14
2	x1w	PL 14 x 3/8	1 1 1/2	BENT	3 16
2	x1t	PL 14 x 3/8	1 1 1/2	BENT	3 16
2	x1y	PL 14 x 3/8	1 1 1/2	BENT	3 16
2	x1oo	PL 14 x 3/8	1 1 1/2	BENT	3 16
2	x1oc	PL 14 x 3/8	1 1 1/2	BENT	3 16
2	x1ob	PL 14 x 3/8	1 1 1/2	BENT	3 16
1	x1on	PL 14 x 3/8	1 2 1/2	BENT	3 16
1	x1om	PL 14 x 3/8	1 2 1/2	BENT	3 16
1	x1ok	PL 14 x 3/8	1 2 1/2	BENT	3 16
30		7/8 # H.S. BOLTS	0 2 1/2		B1 2
6		7/8 # H.S. BOLTS	0 3		B1 3
6		7/8 # H.S. BOLTS	0 4		B1 4
42		WASHERS FOR 7/8 # H.S. BOLTS			B1 5
3		7/8 # H.S. BOLTS	0 2 1/2	A325-1 W/1 A563 GALV. CAP. TH. H.S. NUT	B1 2
3		WASHERS FOR 7/8 # H.S. BOLTS		F436 GALV.	B1 5

△
△

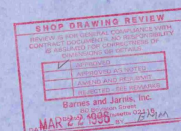

SHOP NOTE
HOLES: 1/8" (UN)
BOLTS: AS NOTED
PAINT: AS NOTED, SEE DWG. N1
FOR GENERAL SHOP NOTES, SEE DWG. N1.
FOR WEB CAMBER DIAGRAM, SEE DWG. WC1.

WORK THIS DWG. WITH DWG. 7

CODE: 30

CONTRACT NO. VT-95367

DATE: 2-2-96

DRAWING NUMBER: 8 OF 24

800-400

MAR 01 1996

