


BILL OF MATERIAL					
NO.	MARK	DESCRIPTION	LENGTH	REMARKS	ITEM NO.
ONE	G3A	GIRDER			40865
1	a	PL 62 x 3/8	88 9 (T)		2-5
1	b	PL 62 x 3/8	62 0 1/8 (T)		2-2
1	c	PL 16 x 1/2	34 9 (T)		2-18
1	d	PL 16 x 1/2	62 0 1/4 (T)		2-17
1	f	PL 16 x 1 1/4	11 0 (T)		2-11
1	g	PL 16 x 2 3/8	26 9 (T)		2-9
1	h	PL 16 x 1 1/4	16 1 1/2 (T)		2-15
1	k	PL 16 x 1/2	34 9 (T)		2-18
1	m	PL 16 x 1/2	62 0 1/8 (T)		2-17
1	n	PL 16 x 1 1/4	11 0 (T)		2-11
1	p	PL 16 x 2 3/8	26 9 (T)		2-9
1	s	PL 16 x 1 1/4	16 3 1/4 (T)		2-15
4	x1b	BAR 7/8 x 4	5 2		3-12
12	x1f	BAR 7/8 x 1/2	5 2		3-14

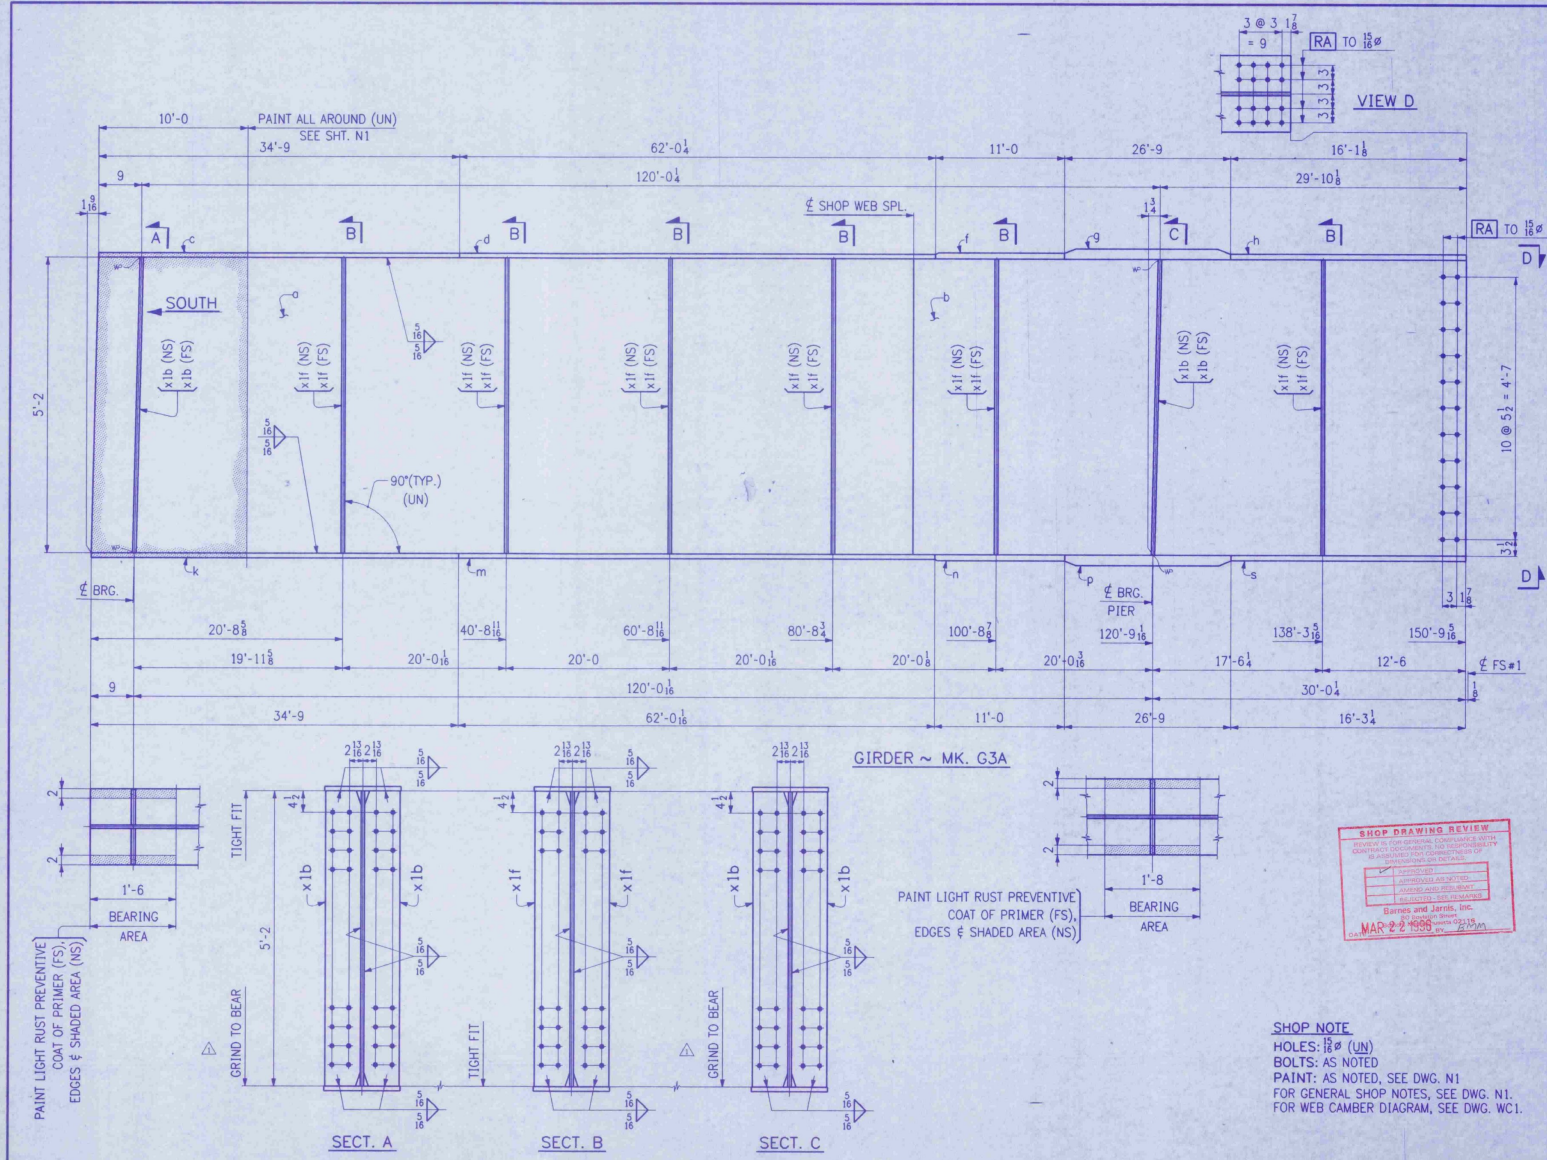

SHOP DRAWING REVIEW
 REVIEWED FOR GENERAL COMPLIANCE WITH
 CONTRACT REQUIREMENTS AND RESPONSIBILITY
 IS ASSUMED FOR CORRECTNESS OF
 DIMENSIONS AND DETAILS.
 APPROVED:
 J. A. McDONALD, INC.
 ENGINEERS AND ARCHITECTS
 1770 HEMPSTEAD ROAD
 LANCASTER, PA 17605-0008
 PH 717-299-5211
 FAX 717-299-5211
 DATE: MAR 22 1996
 TIME: 10:00 AM

SHOP NOTE
 HOLES: 1/8" (UN)
 BOLTS: AS NOTED
 PAINT: AS NOTED, SEE DWG. N1
 FOR GENERAL SHOP NOTES, SEE DWG. N1.
 FOR WEB CAMBER DIAGRAM, SEE DWG. WC1.

△		
△	CHANGED "MILL" TO "GRIND"	2-21-96
NO.	REVISION	DATE

HIGH STEEL STRUCTURES, INC.		1770 Hempstead Road Lancaster, Pa 17605-0008 Phone 717-299-5211
A Division of High Industries, Inc.		
GIRDER		G3A
U.S. ROUTE 7 OVER OTTER CREEK		
BRIDGE NO. 79		
TOWN OF WALLINGFORD, COUNTY OF RUTLAND		
STATE OF VERMONT		
AGENCY OF TRANSPORTATION		
PROJECT NO. BR5-0137(13)		
STATE CONTRACT OR REF. NO.	J. A. McDONALD, INC.	1770 HEMPSTEAD ROAD LANCASTER, PA 17605-0008 PH 717-299-5211 FAX 717-299-5211
CONTRACTOR	J. A. McDONALD, INC.	
IN CHARGE:	cbbs	DATE: 2-2-96
CONTRACT NUMBER:	VT-95367	BY: [Signature]
		DATE: 2-2-96
		9 OF 24