
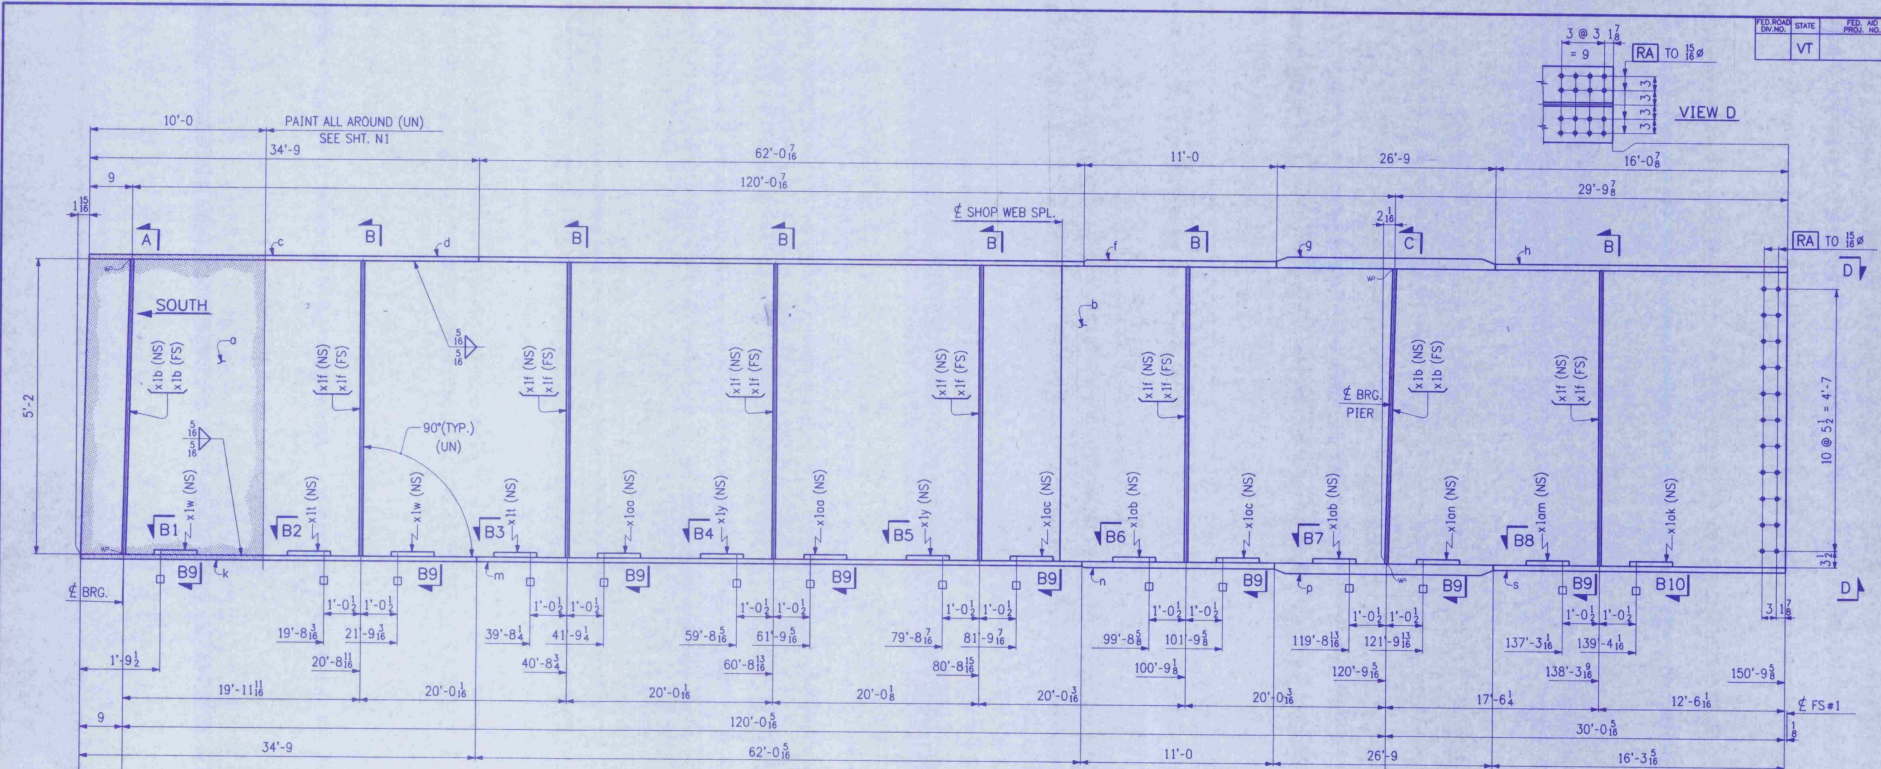


FED. ROAD DIST. NO.	STATE	FED. AID PROJ. NO.
	VT	

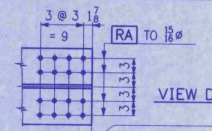


GIRDER ~ MK. G5A


SHOP DRAWING REVIEW
 REVIEWED FOR GENERAL COMPLIANCE WITH
 CONTRACT AND SPECIFICATIONS. NO RESPONSIBILITY
 IS ASSUMED FOR CORRECTIONS OR
 OMISSIONS OR DELAYS.

APPROVED	DATE
APPROVED AND NOTED	
APPROVED AND REVISIONS	
APPROVED AND RESUBMITTED	

Barney and Jerns, Inc.
 100 Broadway Street
 New York, N.Y. 10038
 MAR 22 1968

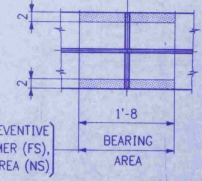

PAINT LIGHT RUST PREVENTIVE
 COAT OF PRIMER (FS),
 EDGES & SHADED AREA (NS)

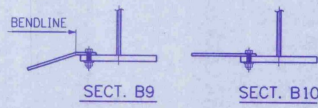

PAINT LIGHT RUST PREVENTIVE
 COAT OF PRIMER (FS),
 EDGES & SHADED AREA (NS)

WORK THIS DWG. WITH DWG. 12

NO.	REVISION	DATE

HIGH STEEL STRUCTURES, INC.
 1770 Hempstead Road
 Lancaster, PA 17605-0000
 Phone 717-299-5211
 A Division of High Industries

GIRDER G5A
 U.S. ROUTE 7 OVER OTTER CREEK
 BRIDGE NO. 75
 TOWN OF WALLINGFORD, COUNTY OF RUTLAND
 STATE OF VERMONT
 AGENCY OF TRANSPORTATION

STATE CONTRACT PROJECT NO. BRS-0137(13)
 OF REF. NO. J. A. McDONALD, INC.
 CONTRACTOR
 IN CHARGE: abs BY: PPF 2:1 CHK'D: LD DATE: 2-2-96
 CONTRACT NUMBER: VT-95367 DRAWING NUMBER: 11 OF 24