

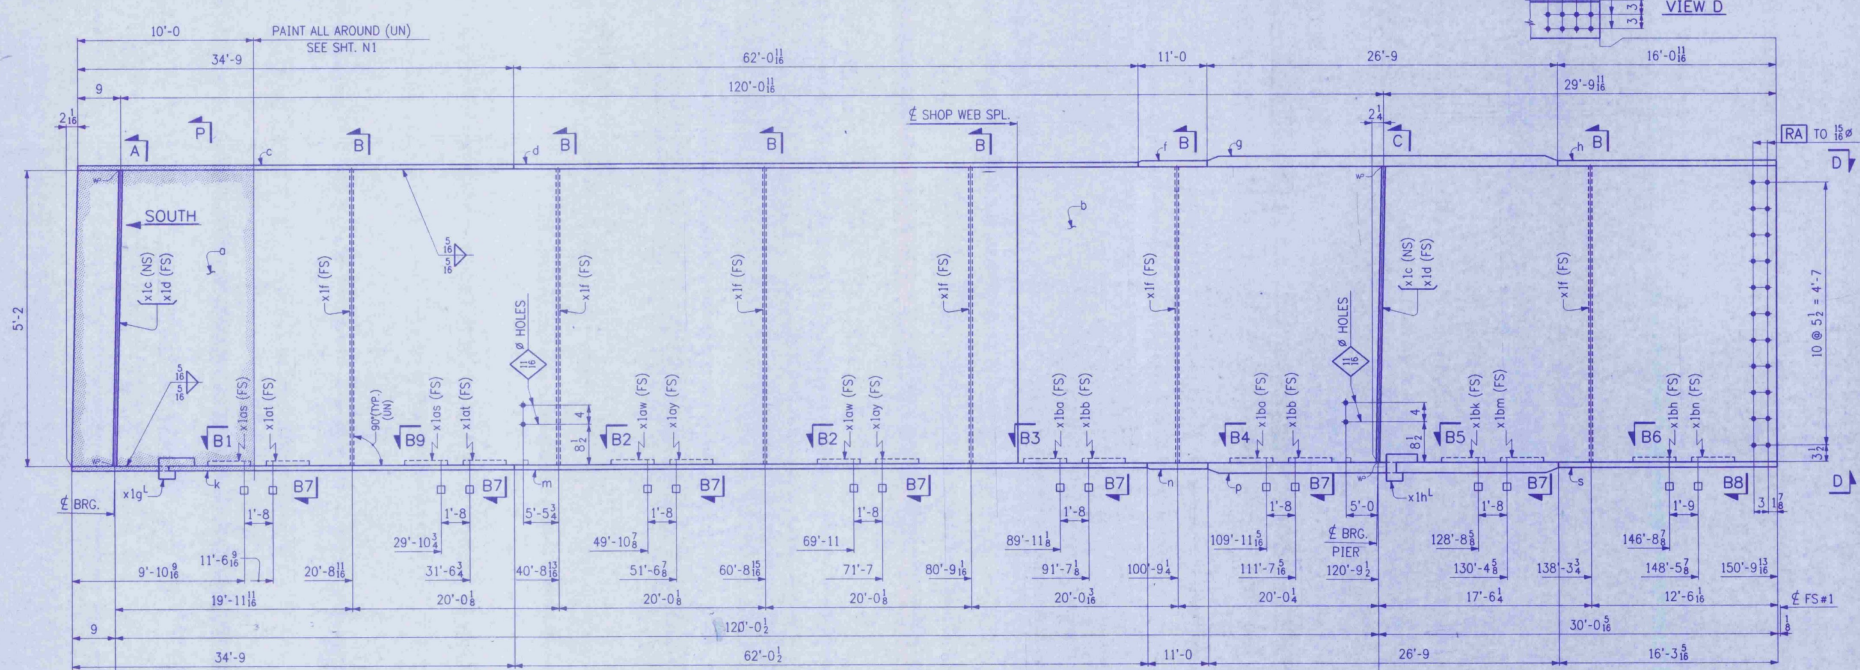
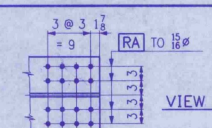
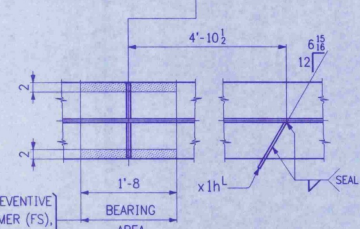
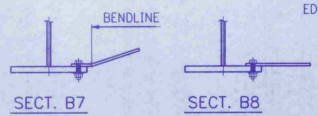


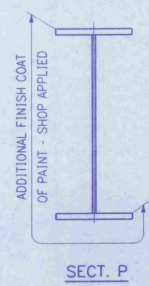

GIRDER ~ MK. G6A

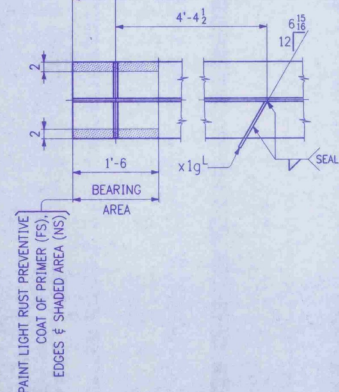

SHOP DRAWING REVIEW
 REVIEWED FOR COMPLIANCE WITH
 CONTRACT REQUIREMENTS OF PERFORMANCE
 ASSURING THE CORRECTNESS OF
 DIMENSIONS AND DETAILS
 APPROVED:
 DATE: MAR 22 1996
 BY: [Signature]

NO.	REVISION	DATE

HIGH STEEL STRUCTURES, INC.
 1770 Hempstead Road
 Lancaster, Pa. 17601-0008
 Phone: 717/299-5211
 A Division of High Industries, Inc.

GIRDER G6A
 U.S. ROUTE 7 OVER OTTER CREEK
 BRIDGE NO. 79
 TOWN OF WALLINGFORD, COUNTY OF RUTLAND
 STATE OF VERMONT
 AGENCY OF TRANSPORTATION
 PROJECT NO. BR5-0137(13)
 CONTRACTOR: J. A. McDONALD, INC.
 IN CHARGE: **abs** BY: **PPF** 2-1 CWD L.D. DATE: 2-2-96
 CONTRACT NO.: VT-95367 DRAWING NO.: 13 OF 24

WORK THIS DWG. WITH DWG. 14

MAR 01 1996